

621.205
~~621.20~~ STEEL BEAM GUARDRAIL, GALVANIZED W/ 8' POSTS
 BRADFORD STA. 362+82.5 TO 365+82.5, RT

646.20
~~646.402~~ DURABLE 4 INCH WHITE LINE, THERMOPLASTIC
 BRADFORD STA. 360+50 TO CORINTH STA. 4+50, SOLID LT & RT

646.602 TEMPORARY 4 INCH WHITE LINE, PAINT
 BRADFORD STA. 360+50 TO CORINTH STA. 4+50, SOLID LT & RT

675.50 REMOVING SIGNS
 AS SHOWN - 1



621.50 MANUFACTURED TERMINAL SECTION, FLARED
 BRADFORD STA. 362+45 TO 362+82.5, RT
 BRADFORD STA. 365+82.5 TO 366+20, RT

646.21
~~646.412~~ DURABLE 4 INCH YELLOW LINE, THERMOPLASTIC
 BRADFORD STA. 360+50 TO CORINTH STA. 4+50, SOLID LT & RT

646.612 TEMPORARY 4 INCH YELLOW LINE, PAINT
 BRADFORD STA. 360+50 TO CORINTH STA. 4+50, SOLID LT & RT

621.80 REMOVAL AND DISPOSAL OF GUARDRAIL
 BRADFORD STA. 362+93 TO 366+07, RT

**BRADFORD STA 367+40 BK=
 CORINTH STA 0+00 AHD**

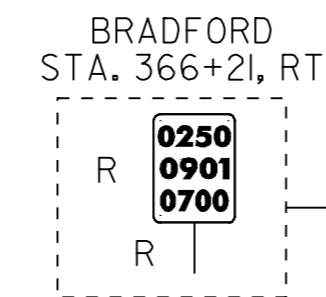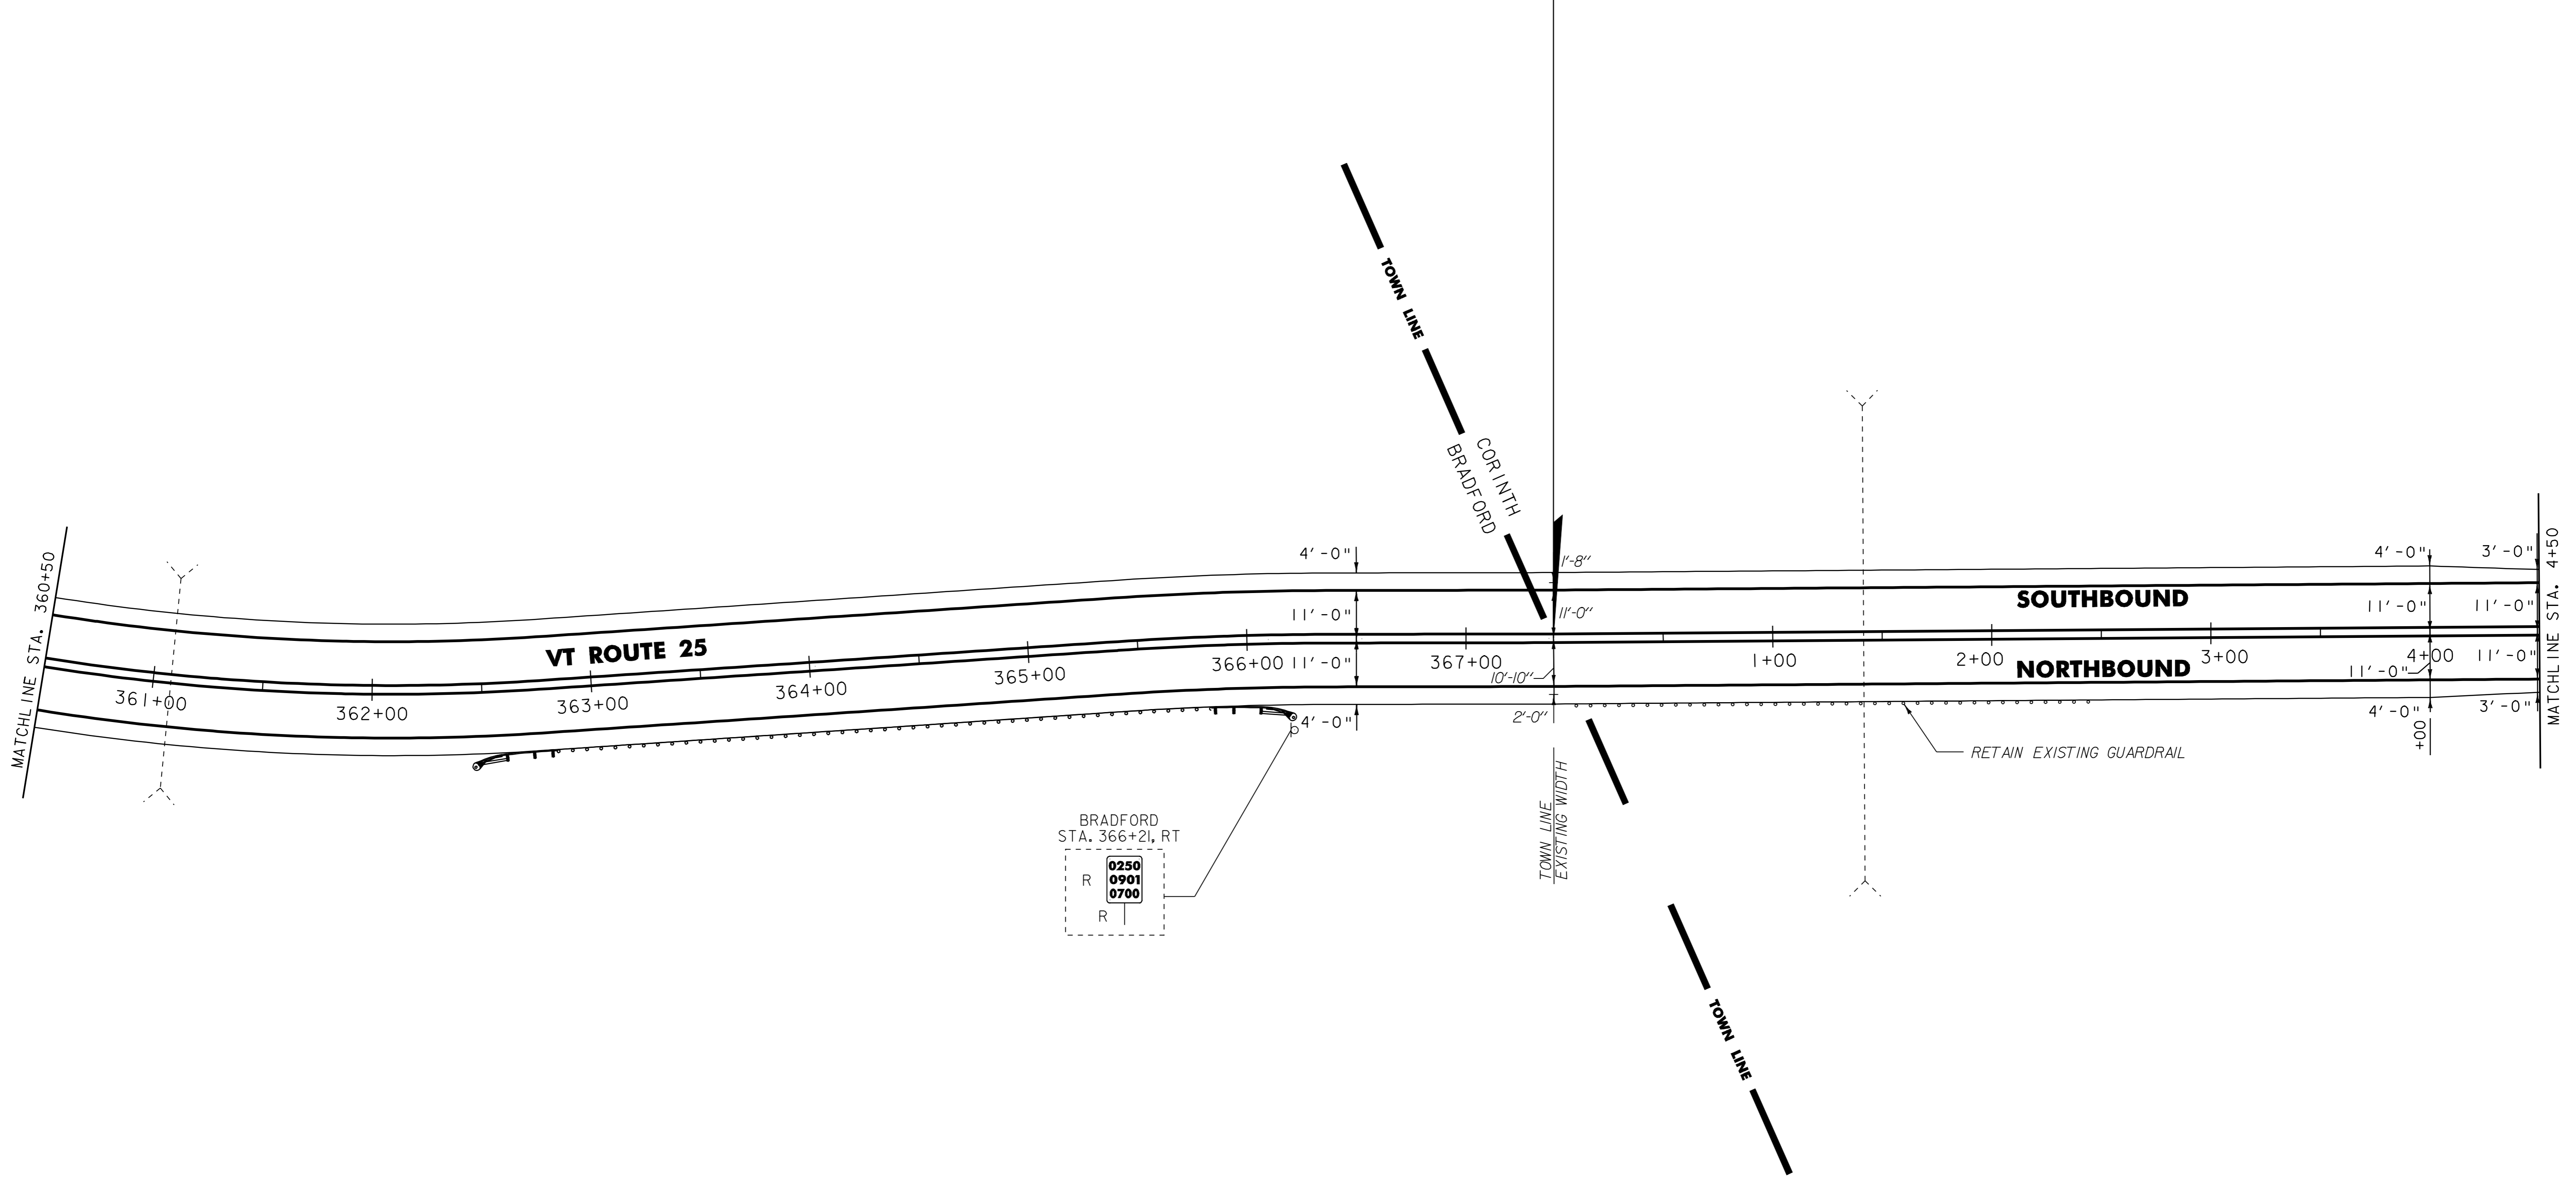

- NOTES:
 1. ALL EXISTING SIGNS NOT SHOWN SHALL BE RETAINED.
 2. FOR LEGEND, SEE LAYOUT SHEET #1

NOT TO SCALE

PROJECT LAYOUT SHEET #4	PROJECT NAME: BRADFORD - ORANGE
	PROJECT NUMBER: STP 2213(1)
	FILE NAME: p99b178.dgn
	PLOT DATE: 28-MAY-2010 13:4
PROJECT LEADER: JLL	DRAWN BY: STANTEC
DESIGNED BY: STANTEC	CHECKED BY: JLL
IPARM FILE: p99b178IO4.i	SHEET 21 OF 84

