

621.20 STEEL BEAM GUARDRAIL, GALVANIZED  
 STA. 11+66.5 TO 16+50, RT

646.20  
~~646.402 DURABLE 4 INCH WHITE LINE, THERMOPLASTIC~~  
 STA. 4+50 TO 16+50, SOLID LT & RT


646.602 TEMPORARY 4 INCH WHITE LINE, PAINT  
 STA. 4+50 TO 16+50, SOLID LT & RT

~~621.60 ANCHOR FOR STEEL BEAM GUARDRAIL~~  
 STA 13+06, RT  
 STA 14+16.5, RT

621.50 MANUFACTURED TERMINAL SECTION, FLARED  
 STA. 11+29 TO 11+66.5, RT

646.21  
~~646.412 DURABLE 4 INCH YELLOW LINE, THERMOPLASTIC~~  
 STA. 4+50 TO 14+52, SOLID LT & RT  
 STA. 14+52 TO 16+50, SOLID LT, DASHED RT

646.612 TEMPORARY 4 INCH YELLOW LINE, PAINT  
 STA. 4+50 TO 14+52, SOLID LT & RT  
 STA. 14+52 TO 16+50, SOLID LT, DASHED RT

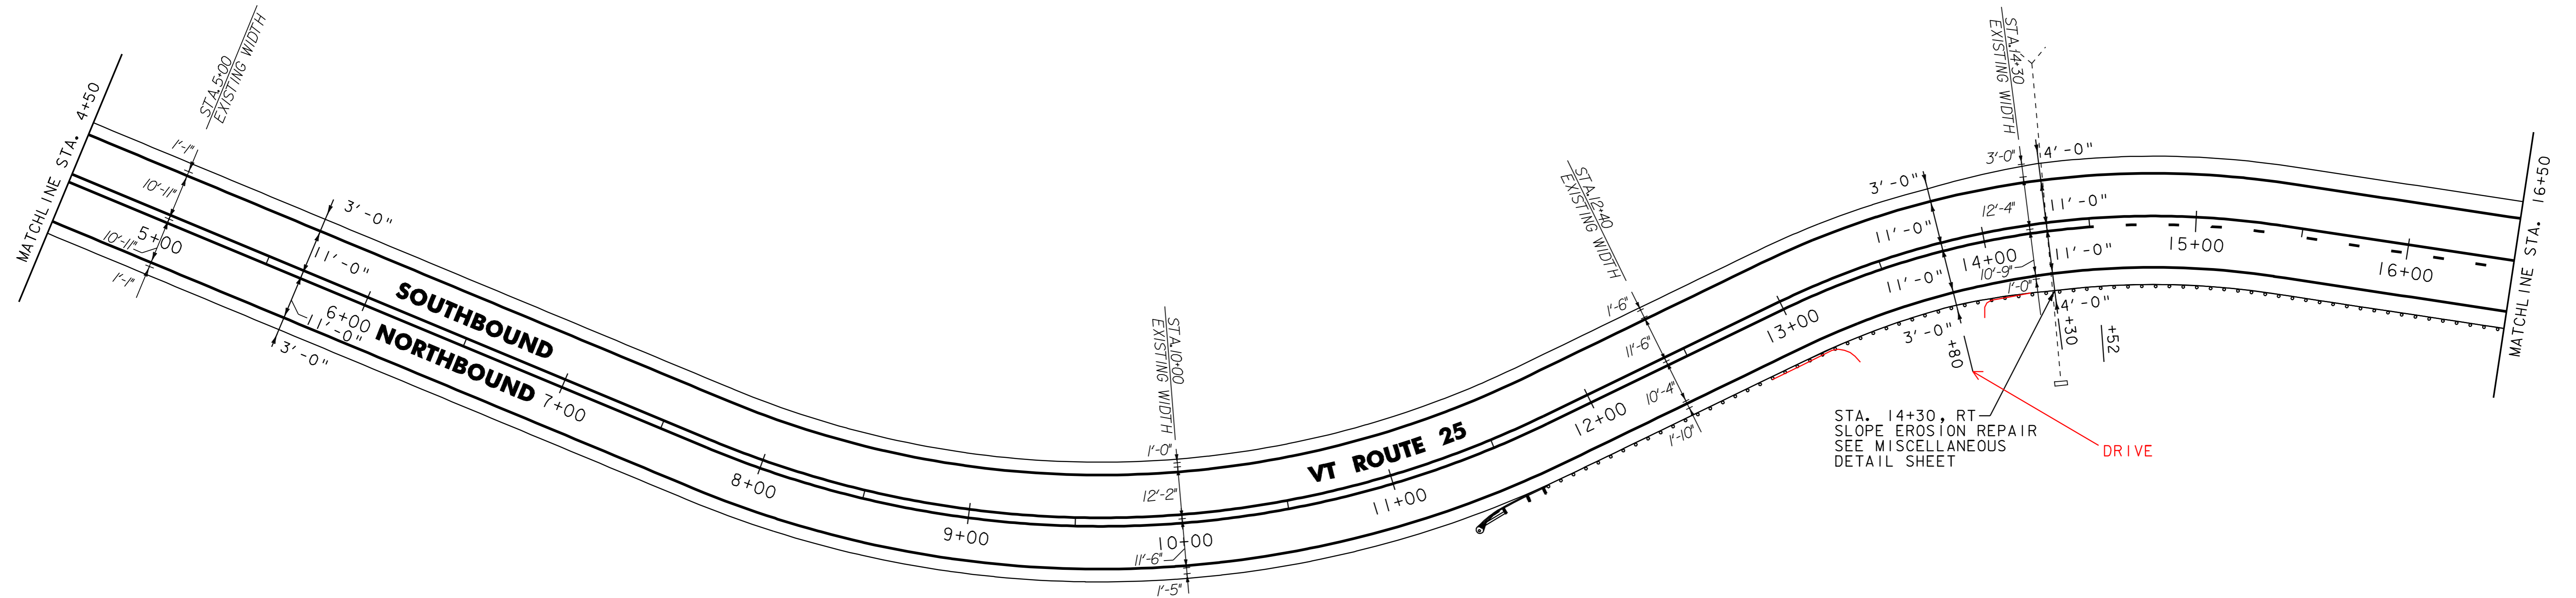

- NOTES:
1. ALL EXISTING SIGNS NOT SHOWN SHALL BE RETAINED.
  2. FOR LEGEND, SEE LAYOUT SHEET #1

NOT TO SCALE

**PROJECT  
 LAYOUT  
 SHEET #5**



PROJECT NAME: BRADFORD - ORANGE	FILE NAME: p99b178.dgn	PLOT DATE: 28-MAY-2010 13:4
PROJECT NUMBER: STP 2213(I)	PROJECT LEADER: JLL	DRAWN BY: STANTEC
DESIGNED BY: STANTEC	CHECKED BY: JLL	SHEET 22 OF 84
IPARM FILE: p99b178IO5.i		