

621.20 STEEL BEAM GUARDRAIL, GALVANIZED  
 STA. 16+50 TO 18+41.5, RT  
 STA. 21+37.5 TO 25+12.5, RT

621.50 MANUFACTURED TERMINAL SECTION, FLARED  
 STA. 18+41.5 TO 18+79, RT  
 STA. 21+00 TO 21+37.5, RT  
 STA. 25+12.5 TO 25+50, RT


646.20  
~~646.402 DURABLE 4 INCH WHITE LINE, THERMOPLASTIC~~  
 STA. 16+50 TO 28+00, SOLID LT & RT

646.21  
~~646.412 DURABLE 4 INCH YELLOW LINE, THERMOPLASTIC~~  
 STA. 16+50 TO 21+12, SOLID LT, DASHED RT  
 STA. 21+12 TO 21+91, SOLID LT & RT  
 STA. 21+91 TO 27+98, DASHED LT, SOLID RT  
 STA. 27+98 TO 28+00, SOLID LT & RT

646.602 TEMPORARY 4 INCH WHITE LINE, PAINT  
 STA. 16+50 TO 28+00, SOLID LT & RT

646.612 TEMPORARY 4 INCH YELLOW LINE, PAINT  
 STA. 16+50 TO 21+12, SOLID LT, DASHED RT  
 STA. 21+12 TO 21+91, SOLID LT & RT  
 STA. 21+91 TO 27+98, DASHED LT, SOLID RT  
 STA. 27+98 TO 28+00, SOLID LT & RT

675.50 REMOVING SIGNS  
 AS SHOWN - 1

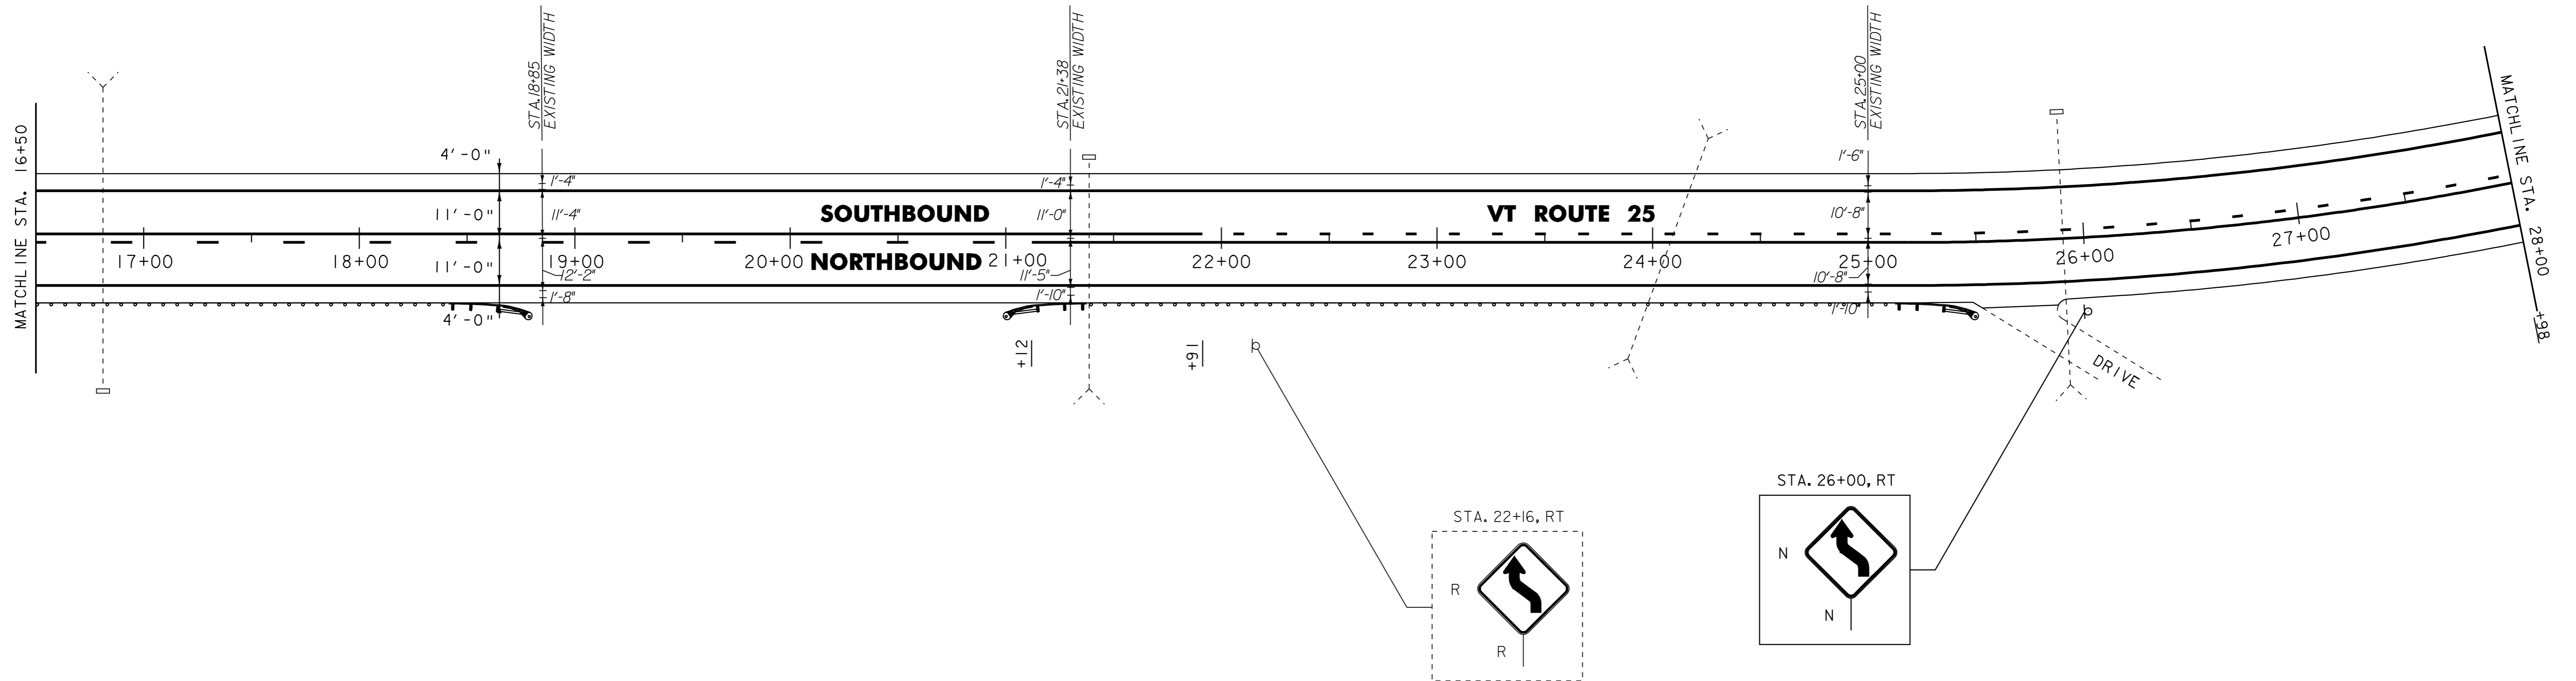

- NOTES:
1. ALL EXISTING SIGNS NOT SHOWN SHALL BE RETAINED.
  2. FOR LEGEND, SEE LAYOUT SHEET #1

NOT TO SCALE

**PROJECT LAYOUT SHEET #6**

PROJECT NAME: BRADFORD - ORANGE	FILE NAME: p99b178.dgn	PLOT DATE: 28-MAY-2010 13:4
PROJECT NUMBER: STP 2213(I)	PROJECT LEADER: JLL	DRAWN BY: STANTEC
DESIGNED BY: STANTEC	CHECKED BY: JLL	SHEET 23 OF 84
IPARM FILE: p99b178IO6.i		

