

621.20 STEEL BEAM GUARDRAIL, GALVANIZED
STA. 33+17.5 TO 35+30, RT 40+00
~~STA. 36+42.5 TO 40+00, RT~~

~~621.205 STEEL BEAM GUARDRAIL, GALVANIZED W/8 FEET POSTS
STA. 35+30 TO 36+42.5, RT~~

621.50 MANUFACTURED TERMINAL SECTION, FLARED
STA. 32+80 TO 33+17.5, RT


621.80 REMOVAL AND DISPOSAL OF GUARDRAIL
STA. 32+79 TO 40+00, RT

646.20
~~646.402 DURABLE 4 INCH WHITE LINE, THERMOPLASTIC
STA. 28+00 TO 40+00, SOLID LT & RT~~

646.21
~~646.412 DURABLE 4 INCH YELLOW LINE, THERMOPLASTIC
STA. 28+00 TO 39+07, SOLID LT & RT
STA. 39+07 TO 40+00, SOLID LT, DASHED RT~~

646.602 TEMPORARY 4 INCH WHITE LINE, PAINT
STA. 28+00 TO 40+00, SOLID LT & RT

646.612 TEMPORARY 4 INCH YELLOW LINE, PAINT
STA. 28+00 TO 39+07, SOLID LT & RT
STA. 39+07 TO 40+00, SOLID LT, DASHED RT

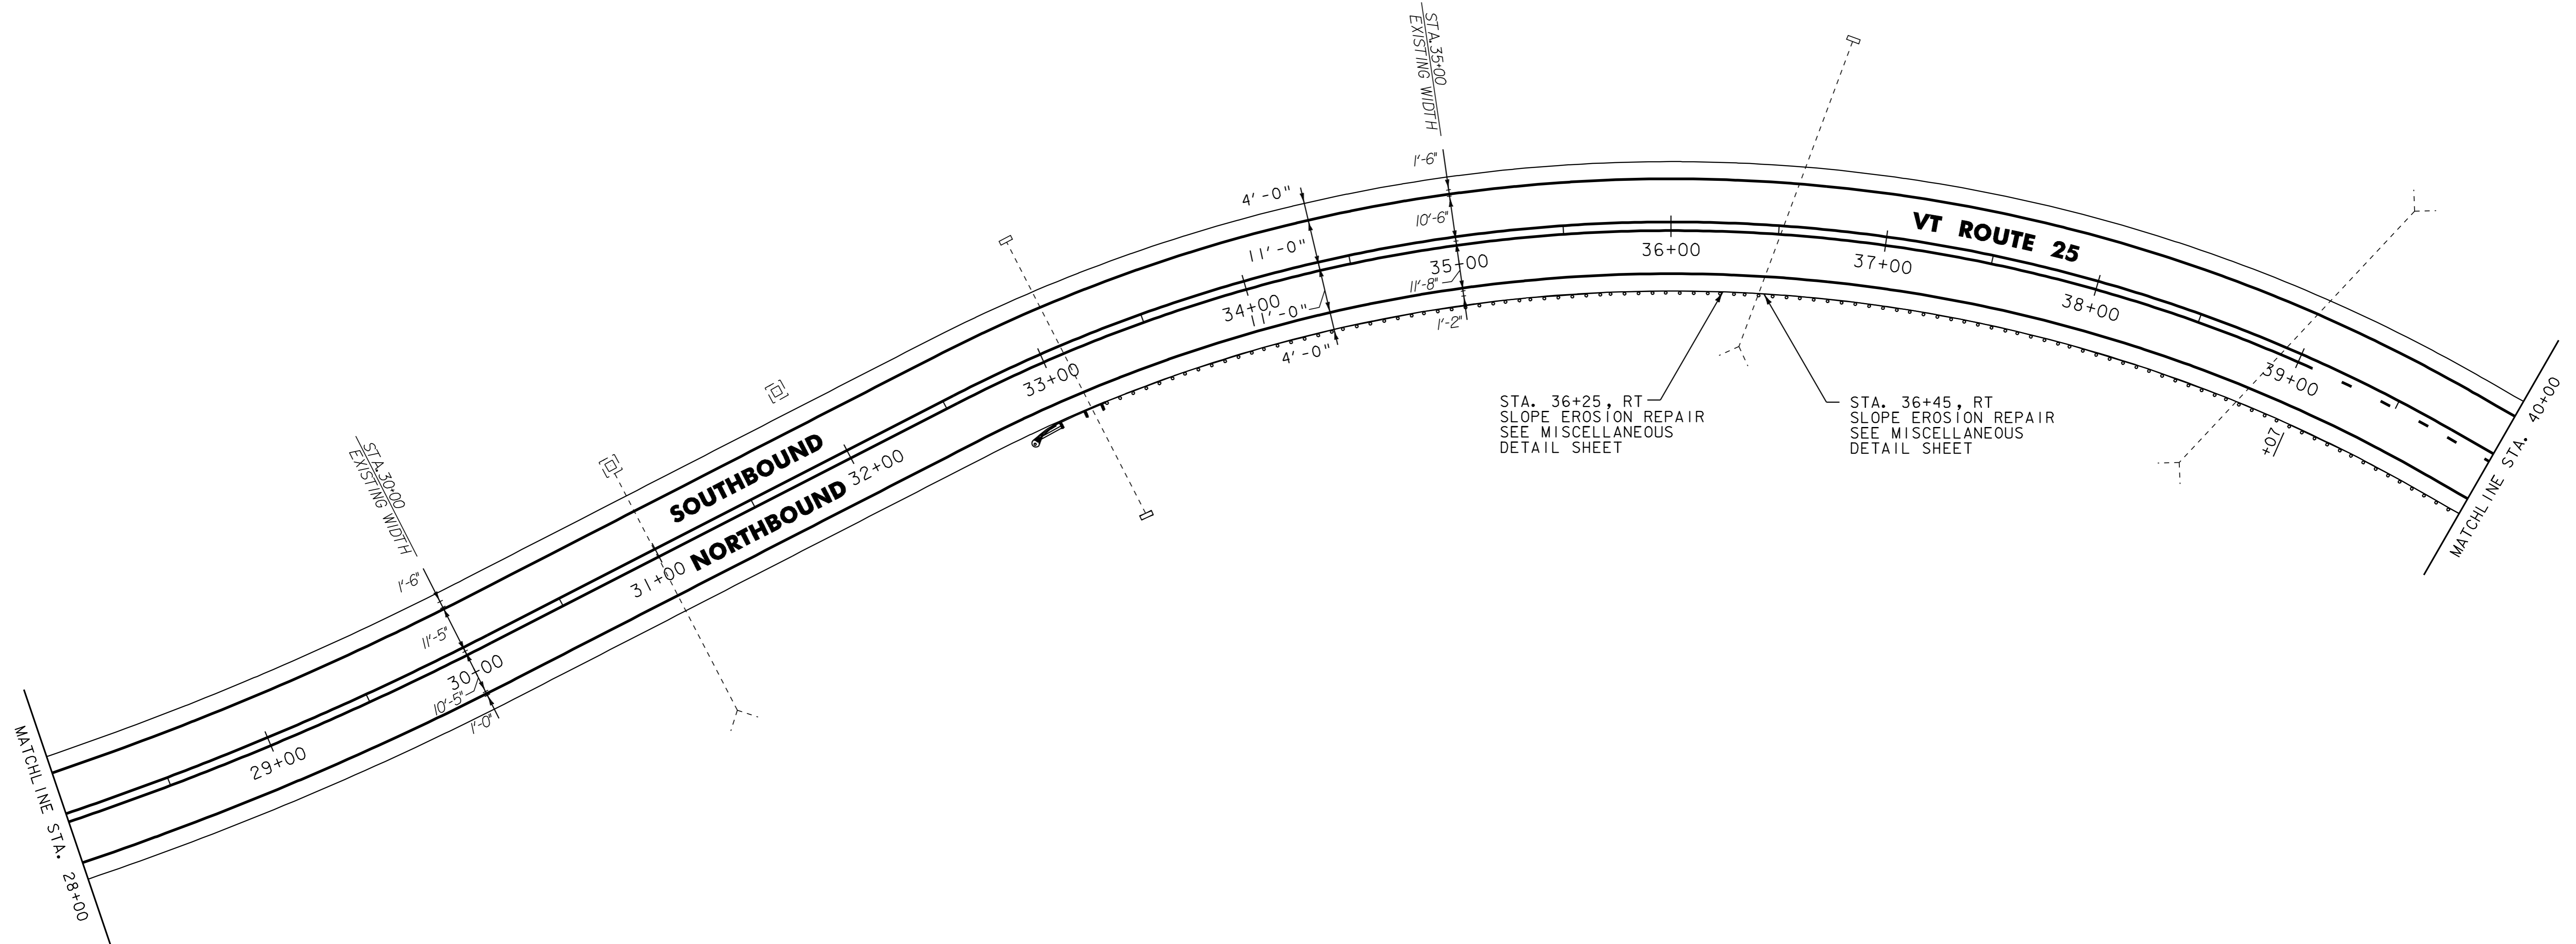

- NOTES:
1. ALL EXISTING SIGNS NOT SHOWN SHALL BE RETAINED.
 2. FOR LEGEND, SEE LAYOUT SHEET #1

NOT TO SCALE

**PROJECT
LAYOUT
SHEET #7**



PROJECT NAME: BRADFORD - ORANGE	
PROJECT NUMBER: STP 2213(I)	
FILE NAME: p99b178.dgn	PLOT DATE: 28-MAY-2010 13:4
PROJECT LEADER: JLL	DRAWN BY: STANTEC
DESIGNED BY: STANTEC	CHECKED BY: JLL
IPARM FILE: p99b178IO7.i	SHEET 24 OF 84