

621.20 STEEL BEAM GUARDRAIL, GALVANIZED
 STA. 40+00 TO 41+42.5, RT
 STA. 48+01.5 TO 49+89, LT
 STA. 49+10.5 TO 50+98, RT
~~(LAST 2 SECTIONS WILL BE 16'-
 RADIUS WITH 2 ANCHORS)~~

621.50 MANUFACTURED TERMINAL SECTION, FLARED
 STA. 41+42.5 TO 41+80, RT
 STA. 47+64 TO 48+01.5, LT
 STA. 48+73 TO 49+10.5, RT
 STA. 50+98 TO 51+35.5, RT

621.60 ANCHOR FOR STEEL BEAM RAIL
 STA. 49+89, LT (2-EACH)


621.80 REMOVAL AND DISPOSAL OF GUARDRAIL
 STA. 40+00 TO 41+46, RT
 STA. 48+73 TO 50+52, RT
 STA. 48+76 TO 49+89, LT

646.20
~~646.402 DURABLE 4 INCH WHITE LINE, THERMOPLASTIC~~
 STA. 40+00 TO 51+50, SOLID LT & RT

646.21
~~646.412 DURABLE 4 INCH YELLOW LINE, THERMOPLASTIC~~
 STA. 40+00 TO 45+94, SOLID LT, DASHED RT
 STA. 45+94 TO 51+22, DASHED C
 STA. 51+22 TO 51+50, DASHED LT, SOLID RT

646.602 TEMPORARY 4 INCH WHITE LINE, PAINT
 STA. 40+00 TO 51+50, SOLID LT & RT

646.612 TEMPORARY 4 INCH YELLOW LINE, PAINT
 STA. 40+00 TO 45+94, SOLID LT, DASHED RT
 STA. 45+94 TO 51+22, DASHED C
 STA. 51+22 TO 51+50, DASHED LT, SOLID RT

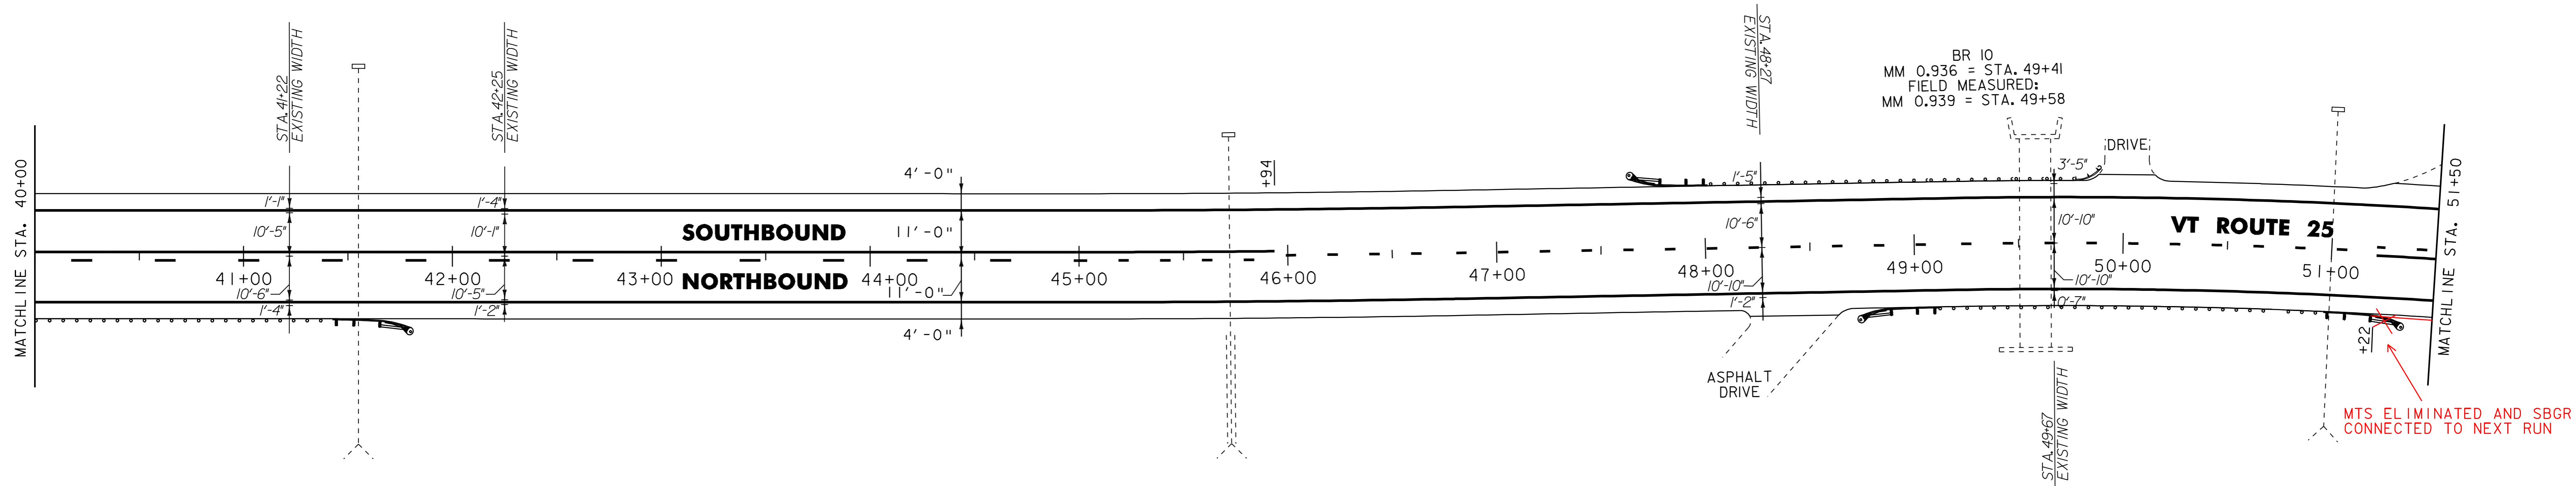

621.20 STEEL BEAM GUARDRAIL, GALVANIZED
 STA. 52+50 TO 56+00, RT
 STA. 51+50

646.20
~~646.402 DURABLE 4 INCH WHITE LINE, THERMOPLASTIC~~
 STA. 51+50 TO 63+00, SOLID LT & RT

646.602 TEMPORARY 4 INCH WHITE LINE, PAINT
 STA. 51+50 TO 63+00, SOLID LT & RT


675.50 REMOVING SIGNS
 AS SHOWN - I

621.50 MANUFACTURED TERMINAL SECTION, FLARED
 STA. 52+12.5 TO 52+50, RT
 STA. 56+00 TO 56+37.5, RT
 STA. 59+30 TO 59+67.5 RT

646.21
~~646.412 DURABLE 4 INCH YELLOW LINE, THERMOPLASTIC~~
 STA. 51+50 TO 58+61, DASHED LT, SOLID RT
 STA. 58+61 TO 63+00, SOLID LT & RT

646.612 TEMPORARY 4 INCH YELLOW LINE, PAINT
 STA. 51+50 TO 58+61, DASHED LT, SOLID RT
 STA. 58+61 TO 63+00, SOLID LT & RT

675.60 ERECTING SALVAGED SIGNS
 AS SHOWN - I

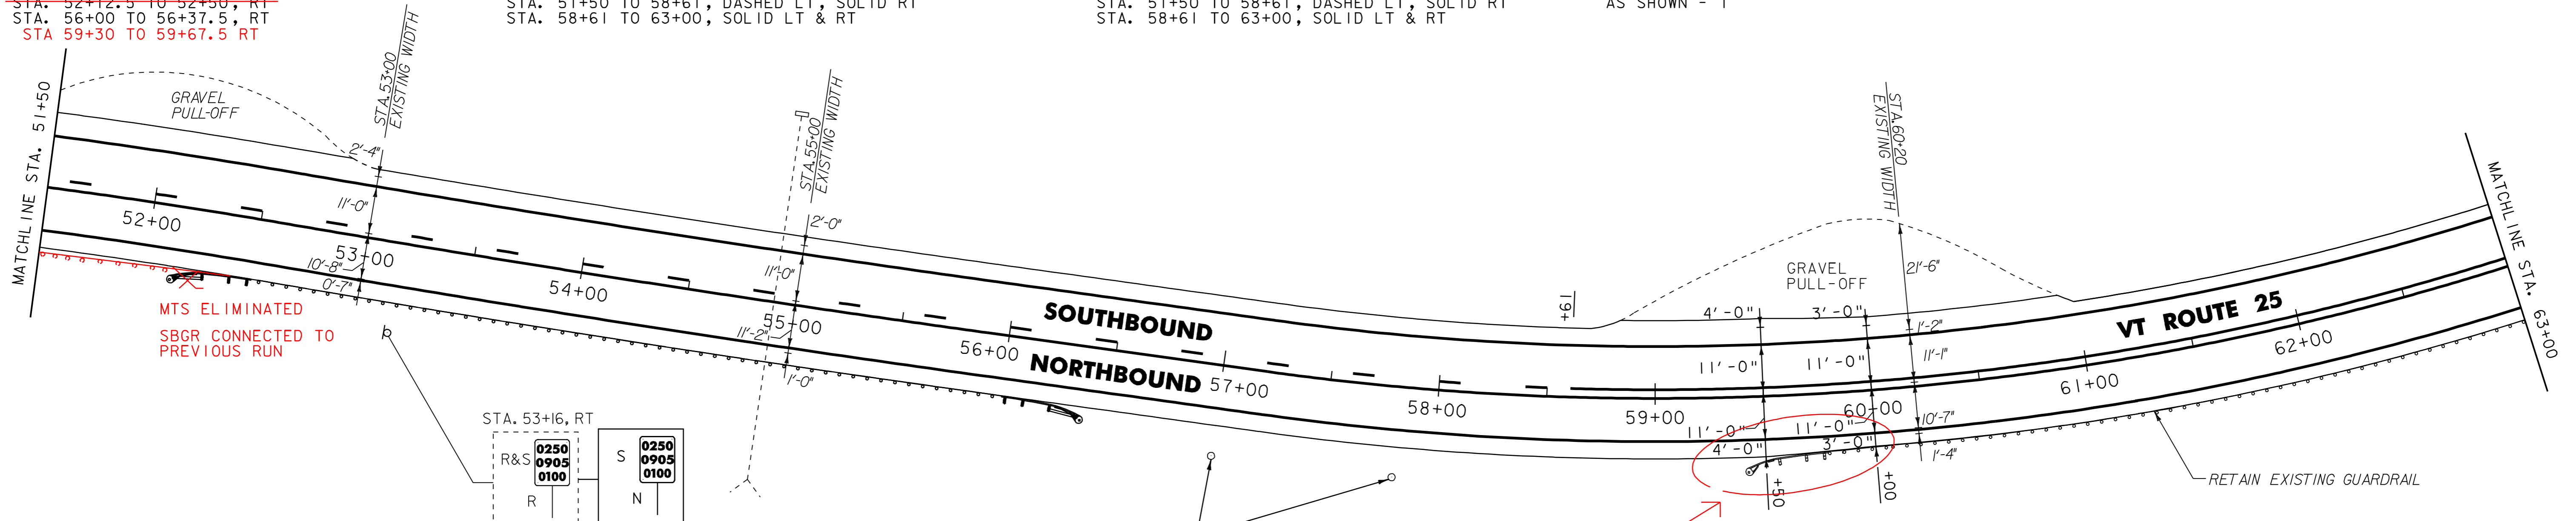

REMOVE EXISTING SIGN POSTS
 (INCIDENTAL TO ITEM 675.50)

- NOTES:
 1. ALL EXISTING SIGNS NOT SHOWN SHALL BE RETAINED.
 2. FOR LEGEND, SEE LAYOUT SHEET #1



PROJECT LAYOUT SHEET #8	PROJECT NAME: BRADFORD - ORANGE
	PROJECT NUMBER: STP 2213(I)
	FILE NAME: p99b178.dgn
	PLOT DATE: 28-MAY-2010 13:4
DESIGNED BY: STANTEC	DRAWN BY: STANTEC
CHECKED BY: JLL	SHEET 25 OF 84