

621.20 STEEL BEAM GUARDRAIL, GALVANIZED
STA. 73+15 TO 74+50, RT

621.50 MANUFACTURED TERMINAL SECTION, FLARED
STA. 72+77.5 TO 73+15, RT
STA. 67+87.5 - 68+25, RT

621.81 REMOVAL AND DISPOSAL OF GUIDE POSTS
STA. 73+17 TO 74+50, RT

~~646.20~~
~~646.402 DURABLE 4 INCH WHITE LINE, THERMOPLASTIC~~
STA. 63+00 TO 74+50, SOLID LT & RT
STA. 69+14, DOUBLE SOLID RT (T.H. 1)

646.21
~~646.412 DURABLE 4 INCH YELLOW LINE, THERMOPLASTIC~~
STA. 63+00 TO 74+50, SOLID LT & RT
STA. 69+14, DOUBLE SOLID RT (T.H. 1)

646.26
~~646.482 DURABLE 24 INCH STOP BAR, THERMOPLASTIC~~
STA. 69+14, RT (T.H. 1)

646.492 DURABLE LETTER OR SYMBOL, THERMOPLASTIC
STA. 69+14, RT - "STOP"


646.602 TEMPORARY 4 INCH WHITE LINE, PAINT
STA. 63+00 TO 74+50, SOLID LT & RT
STA. 69+14, DOUBLE SOLID RT (T.H. 1)

646.612 TEMPORARY 4 INCH YELLOW LINE, PAINT
STA. 63+00 TO 74+50, SOLID LT & RT
STA. 69+14, DOUBLE SOLID RT (T.H. 1)

646.682 TEMPORARY 24 INCH STOP BAR, PAINT
STA. 69+14, RT (T.H. 1)

646.692 TEMPORARY LETTER OR SYMBOL, PAINT
~~STA. 69+14, RT - "STOP"~~

675.50 REMOVING SIGNS
AS SHOWN - 1

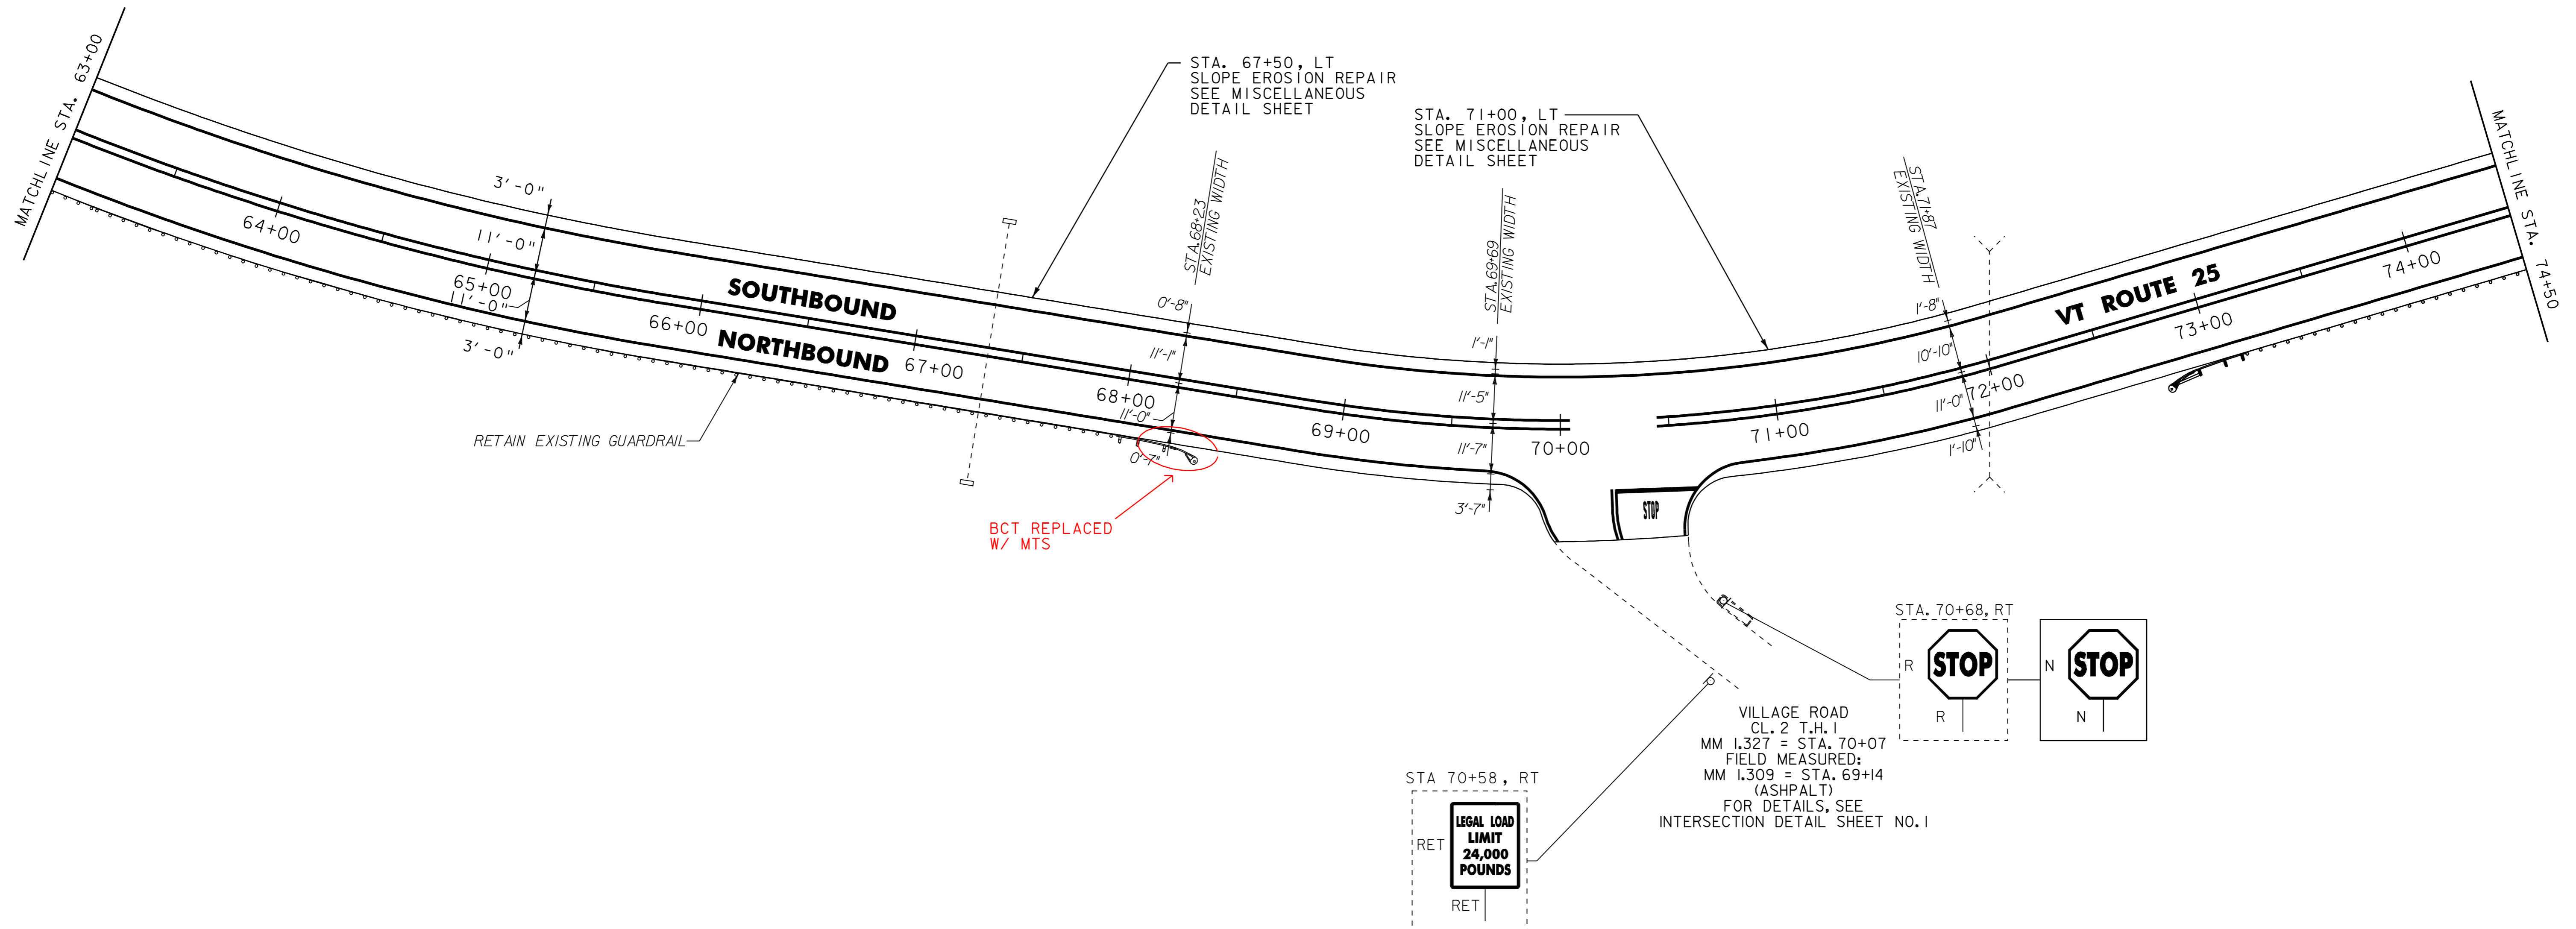

- NOTES:
1. ALL EXISTING SIGNS NOT SHOWN SHALL BE RETAINED.
 2. FOR LEGEND, SEE LAYOUT SHEET #1

NOT TO SCALE

PROJECT LAYOUT SHEET #9



PROJECT NAME: BRADFORD - ORANGE	FILE NAME: p99b178.dgn	PLOT DATE: 28-MAY-2010 13:4
PROJECT NUMBER: STP 2213(I)	PROJECT LEADER: JLL	DRAWN BY: STANTEC
	DESIGNED BY: STANTEC	CHECKED BY: JLL
	IPARM FILE: p99b178109.i	SHEET 26 OF 84