

601.0915 18" CPEP
 STA. 77+02.5, RT
 (SEE GUARD RAIL DETAIL SHEET)

621.20 STEEL BEAM GUARDRAIL, GALVANIZED
 STA. 74+50 TO 76+65, RT

621.50 MANUFACTURED TERMINAL SECTION, FLARED
 STA. 76+65 TO 77+02.5, RT
 (SEE DRAINAGE AT M.T.S. DETAIL SHEET)

621.81 REMOVAL AND DISPOSAL OF GUIDE POSTS
 STA. 74+50 TO 76+59, RT

~~646.20 DURABLE 4 INCH WHITE LINE, THERMOPLASTIC~~
~~646.402 DURABLE 4 INCH WHITE LINE, THERMOPLASTIC~~
 STA. 74+50 TO 86+50, SOLID LT & RT
 STA. 80+00 TO 82+90, DOUBLE SOLID LT (T.H. 28)
 STA. 80+14 DOUBLE SOLID LT (T.H. 28)

646.21
~~646.412 DURABLE 4 INCH YELLOW LINE, THERMOPLASTIC~~
 STA. 74+50 TO 82+63, SOLID LT & RT
 STA. 82+63 TO 86+50, SOLID LT, DASHED RT
 STA. 80+00 TO 81+75, DOUBLE SOLID LT (T.H. 28)
 STA. 80+14, DOUBLE SOLID LT (T.H. 28)

646.26
~~646.482 DURABLE 24 INCH STOP BAR, THERMOPLASTIC~~
 2 - STA. 80+14, LT (T.H. 28)
 STA. 81+62, LT (T.H. 28)

646.492 DURABLE LETTER OR SYMBOL, THERMOPLASTIC
 2 - STA. 80+14, LT - "STOP"
 STA. 81+62, LT - "STOP"

646.602 TEMPORARY 4 INCH WHITE LINE, PAINT
 STA. 74+50 TO 86+50, SOLID LT & RT
 STA. 80+00 TO 82+90, DOUBLE SOLID LT (T.H. 28)
 STA. 80+14 DOUBLE SOLID LT (T.H. 28)


646.612 TEMPORARY 4 INCH YELLOW LINE, PAINT
 STA. 74+50 TO 82+63, SOLID LT & RT
 STA. 82+63 TO 86+50, SOLID LT, DASHED RT
 STA. 80+00 TO 81+75, DOUBLE SOLID LT (T.H. 28)
 STA. 80+14, DOUBLE SOLID LT (T.H. 28)

646.682 TEMPORARY 24 INCH STOP BAR, PAINT
 2 - STA. 80+14, LT (T.H. 28)
 STA. 81+62, LT (T.H. 28)

~~646.692 TEMPORARY LETTER OR SYMBOL, PAINT~~
~~2 - STA. 80+14, LT - "STOP"~~
~~STA. 81+62, LT - "STOP"~~

675.50 REMOVING SIGNS
 AS SHOWN - 8

675.60 ERECTING SALVAGED SIGNS
 AS SHOWN - 2

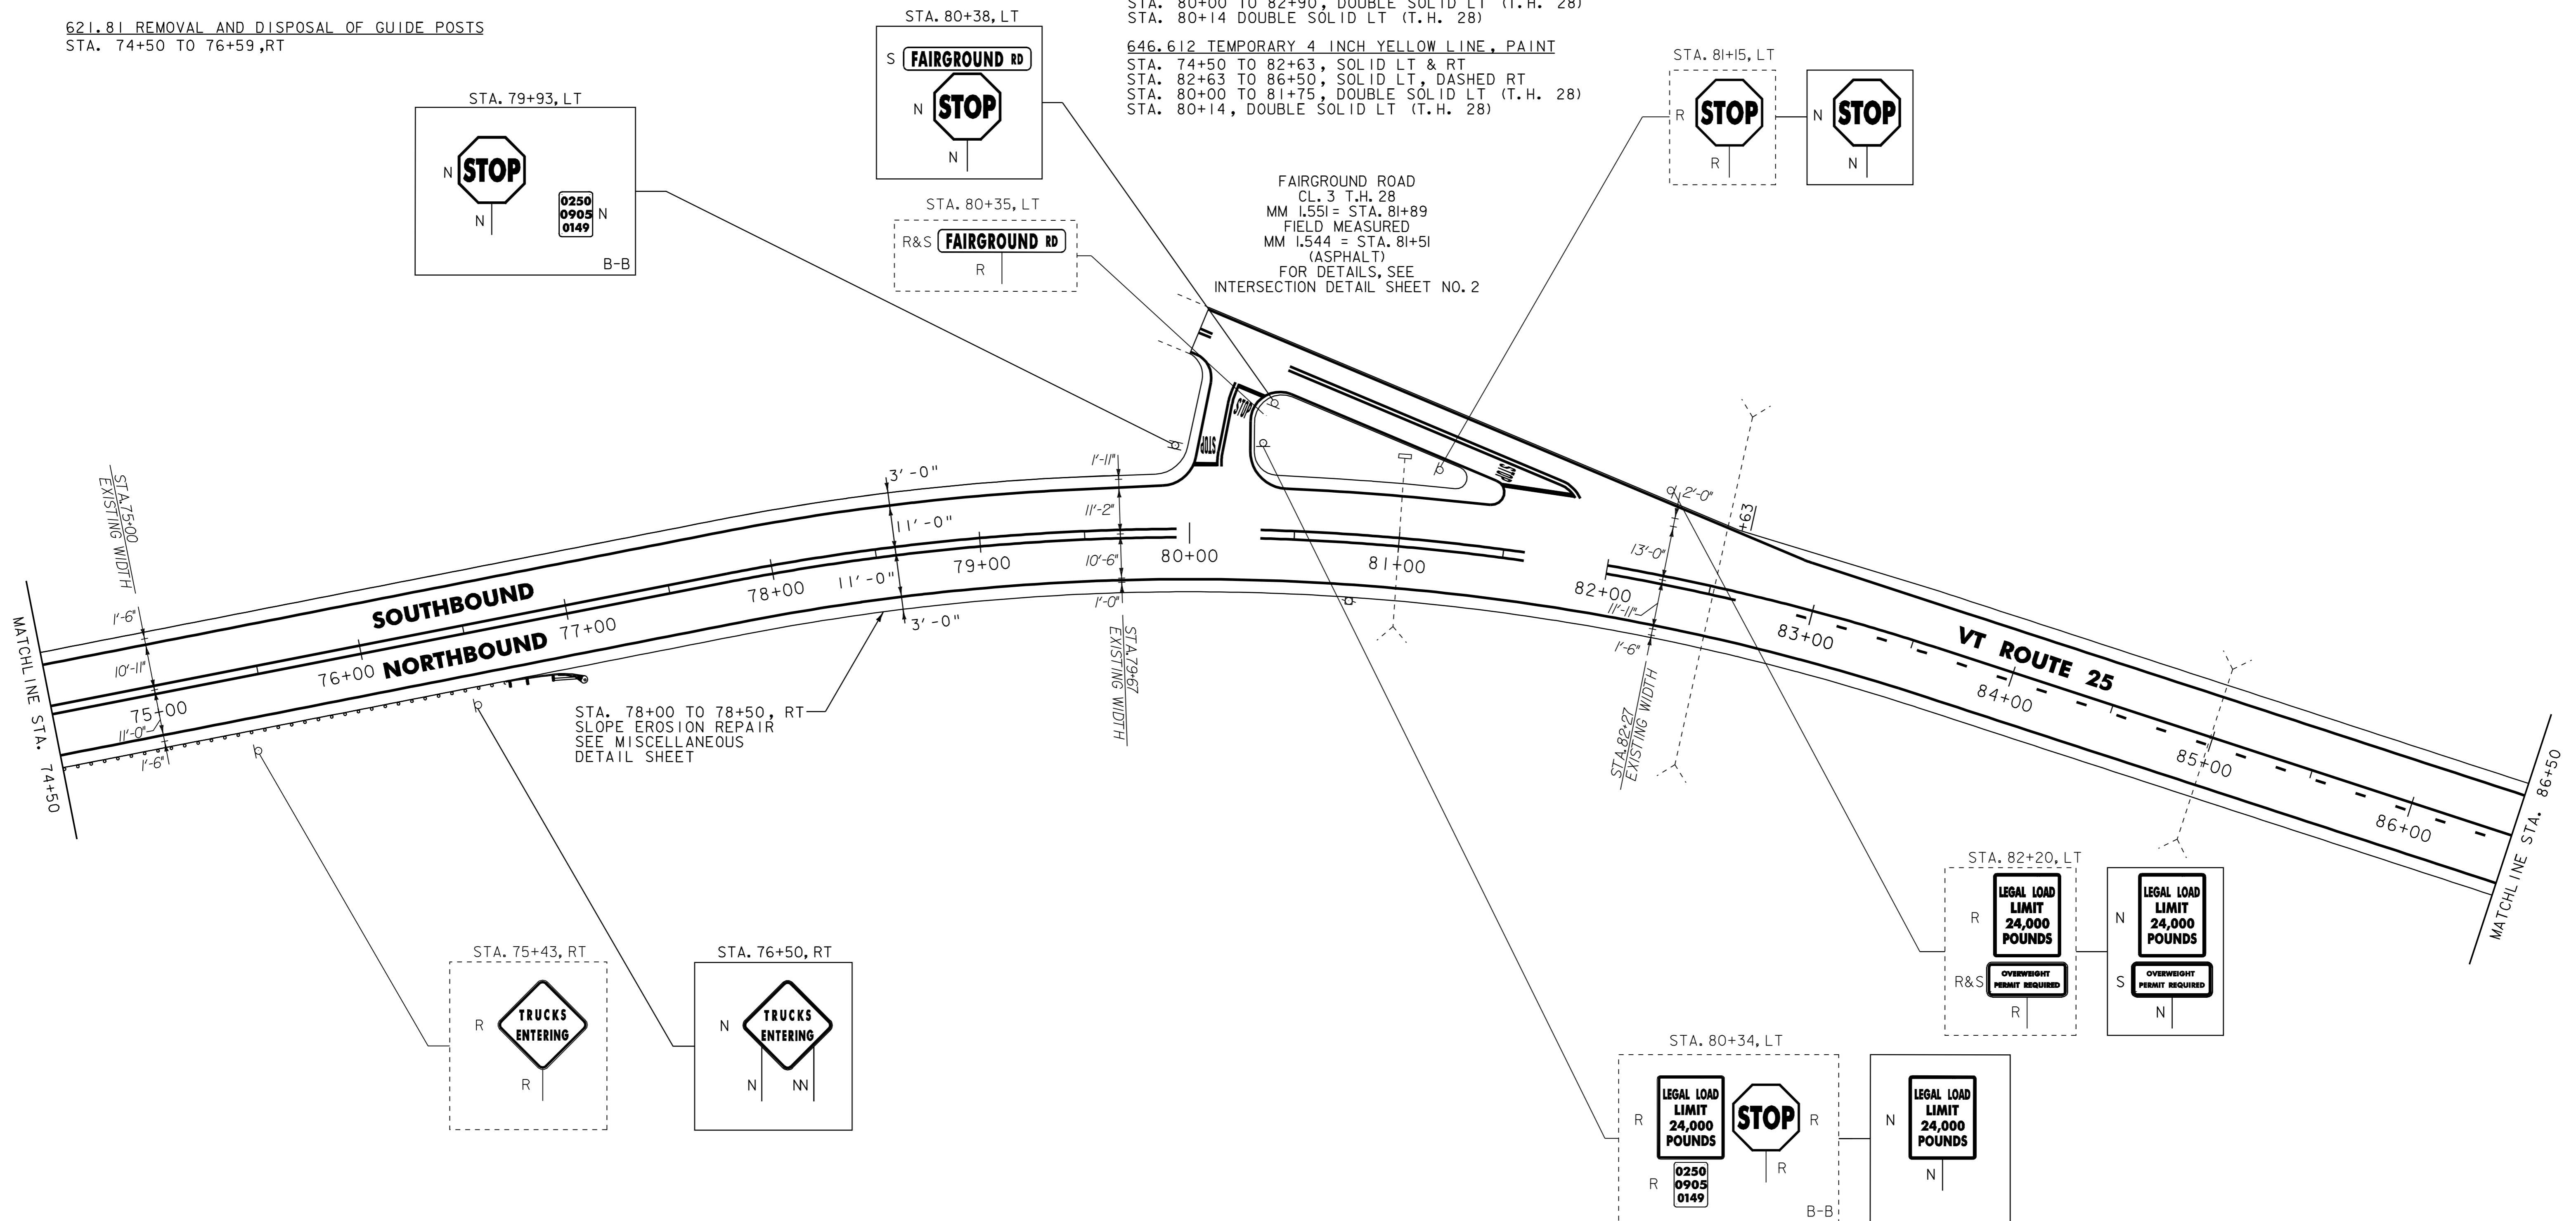

NOTES:
 1. ALL EXISTING SIGNS NOT SHOWN SHALL BE RETAINED.
 2. FOR LEGEND, SEE LAYOUT SHEET #1

NOT TO SCALE

PROJECT LAYOUT SHEET #10

PROJECT NAME: BRADFORD - ORANGE	
PROJECT NUMBER: STP 2213(I)	
FILE NAME: p99b178.dgn	PLOT DATE: 28-MAY-2010 13:4
PROJECT LEADER: JLL	DRAWN BY: STANTEC
DESIGNED BY: STANTEC	CHECKED BY: JLL
IPARM FILE: p99b178i10.i	SHEET 27 OF 84

