


646.20
~~646.402 DURABLE 4 INCH WHITE LINE, THERMOPLASTIC~~
 STA. 168+50 TO 178+50, SOLID LT & RT
 646.21
~~646.412 DURABLE 4 INCH YELLOW LINE, THERMOPLASTIC~~
 STA. 168+50 TO 178+50, SOLID LT & RT


646.602 TEMPORARY 4 INCH WHITE LINE, PAINT
 STA. 168+50 TO 178+50, SOLID LT & RT
 646.612 TEMPORARY 4 INCH YELLOW LINE, PAINT
 STA. 168+50 TO 178+50, SOLID LT & RT

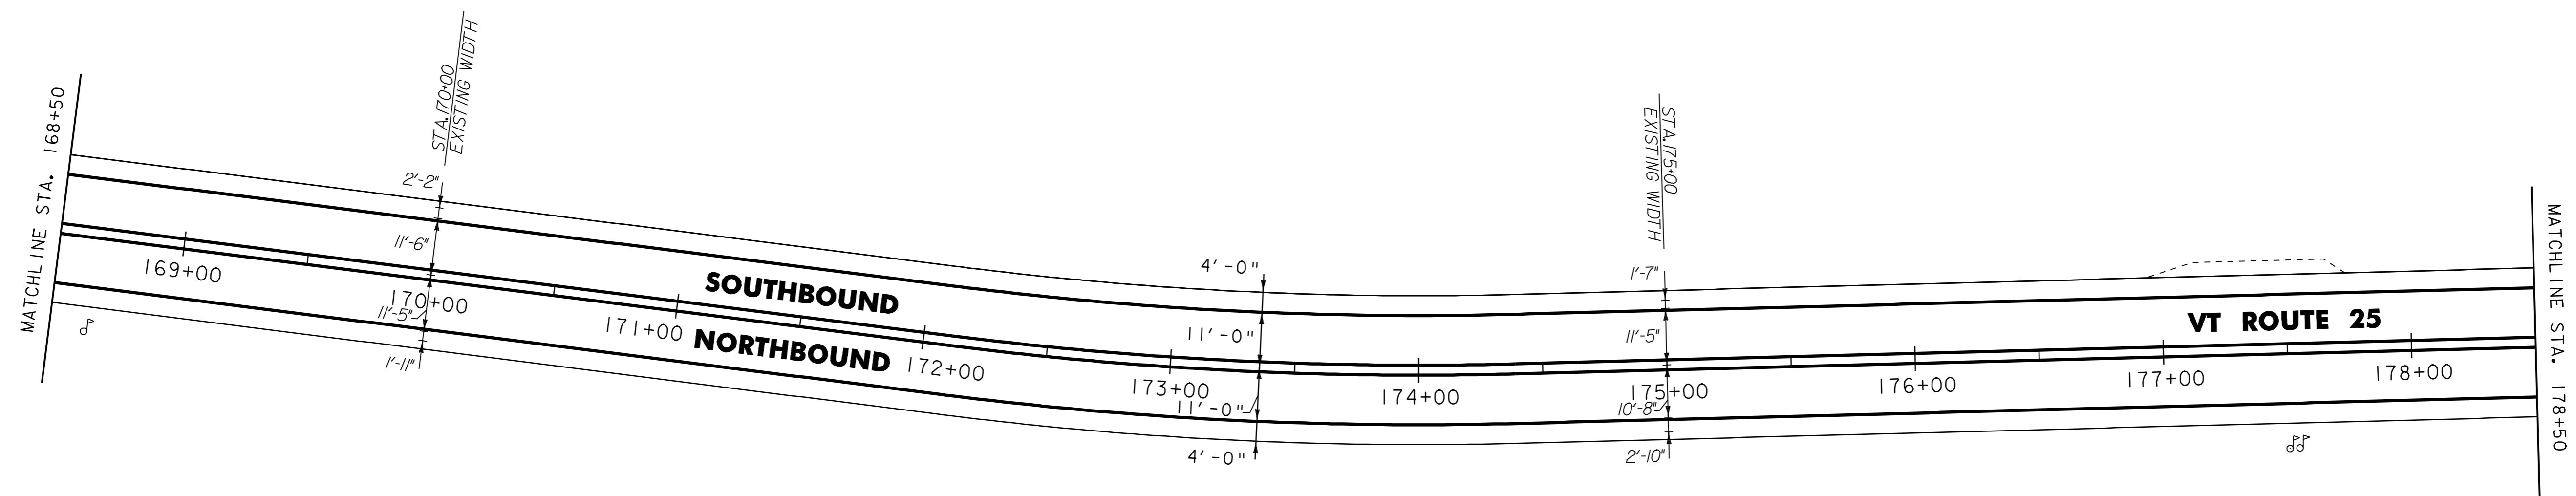

616.47 BITUMINOUS CONCRETE GUTTERS AND TRAFFIC ISLANDS
 STA 186+51 LT & RT CULVERT CROSSING

646.20
~~646.402 DURABLE 4 INCH WHITE LINE, THERMOPLASTIC~~
 STA. 178+50 TO 189+50, SOLID LT & RT
 646.21
~~646.412 DURABLE 4 INCH YELLOW LINE, THERMOPLASTIC~~
 STA. 178+50 TO 189+50, SOLID LT & RT

646.602 TEMPORARY 4 INCH WHITE LINE, PAINT
 STA. 178+50 TO 189+50, SOLID LT & RT
 646.612 TEMPORARY 4 INCH YELLOW LINE, PAINT
 STA. 178+50 TO 189+50, SOLID LT & RT

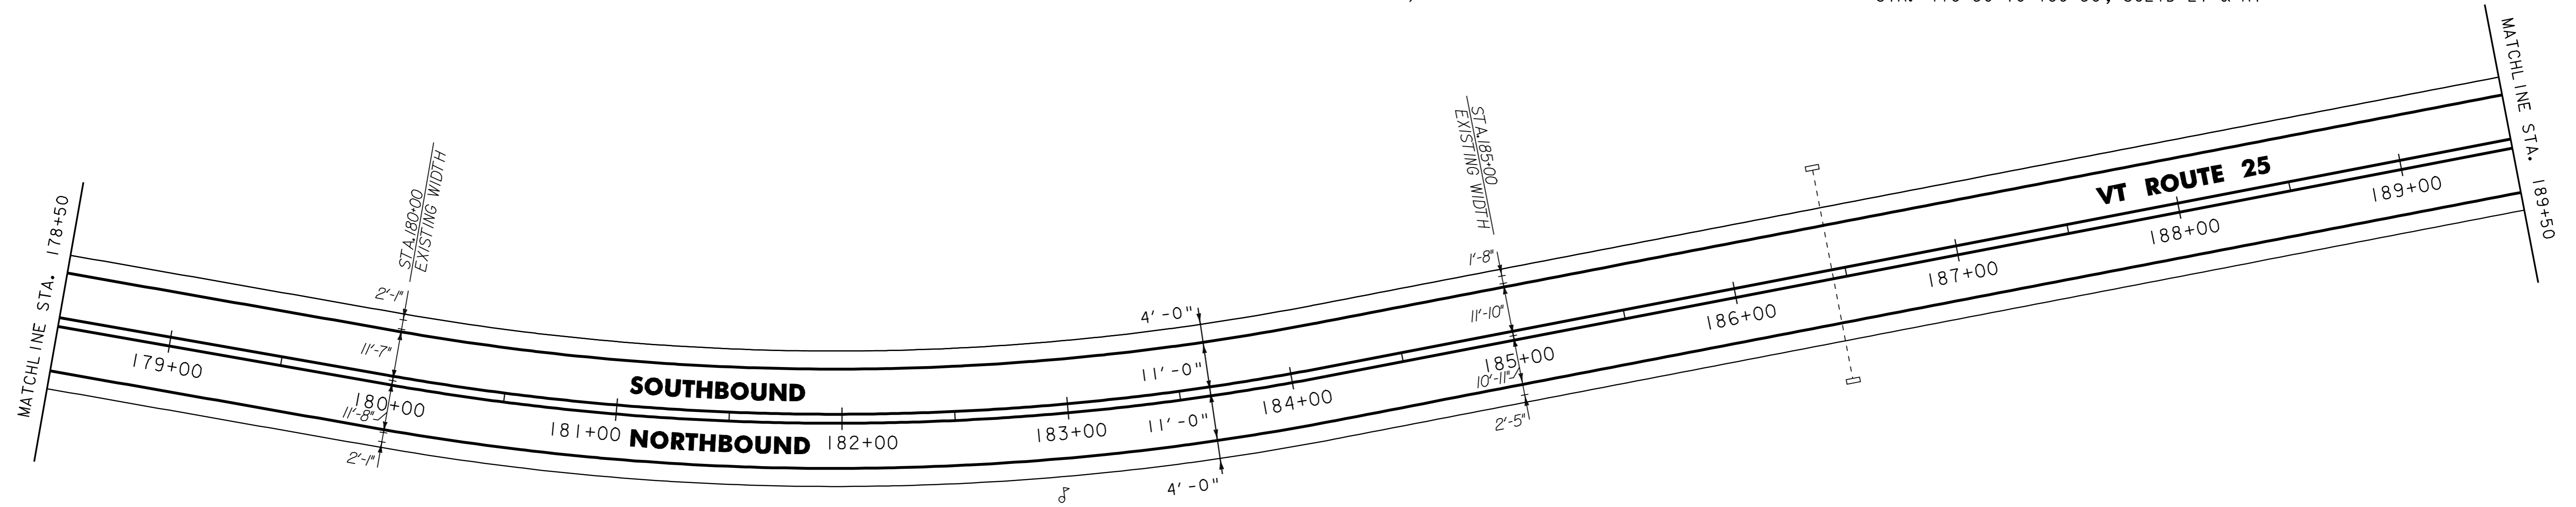

- NOTES:
1. ALL EXISTING SIGNS NOT SHOWN SHALL BE RETAINED.
 2. FOR LEGEND, SEE LAYOUT SHEET #1

NOT TO SCALE



PROJECT LAYOUT SHEET #15	PROJECT NAME: BRADFORD - ORANGE
	PROJECT NUMBER: STP 2213(1)
	FILE NAME: p99b178.dgn
	PLOT DATE: 28-MAY-2010 13:4
PROJECT LEADER: JLL	DRAWN BY: STANTEC
DESIGNED BY: STANTEC	CHECKED BY: JLL
IPARM FILE: p99b178i15.i	SHEET 32 OF 84