

604.412, 604.415, OR 604.418 REHAB.
 DI'S, CB'S OR MH'S, CLASS I, II OR III

675.50 REMOVING SIGNS
 AS SHOWN - 6

STA. 189+67, LT

~~646.20 DURABLE 4 INCH WHITE LINE, THERMOPLASTIC~~
 STA. 189+50 TO 201+50, SOLID LT & RT

646.21


~~646.412 DURABLE 4 INCH YELLOW LINE, THERMOPLASTIC~~
 STA. 189+50 TO 201+50, SOLID LT & RT

646.602 TEMPORARY 4 INCH WHITE LINE, PAINT

STA. 189+50 TO 201+50, SOLID LT & RT

646.612 TEMPORARY 4 INCH YELLOW LINE, PAINT

STA. 189+50 TO 201+50, SOLID LT & RT

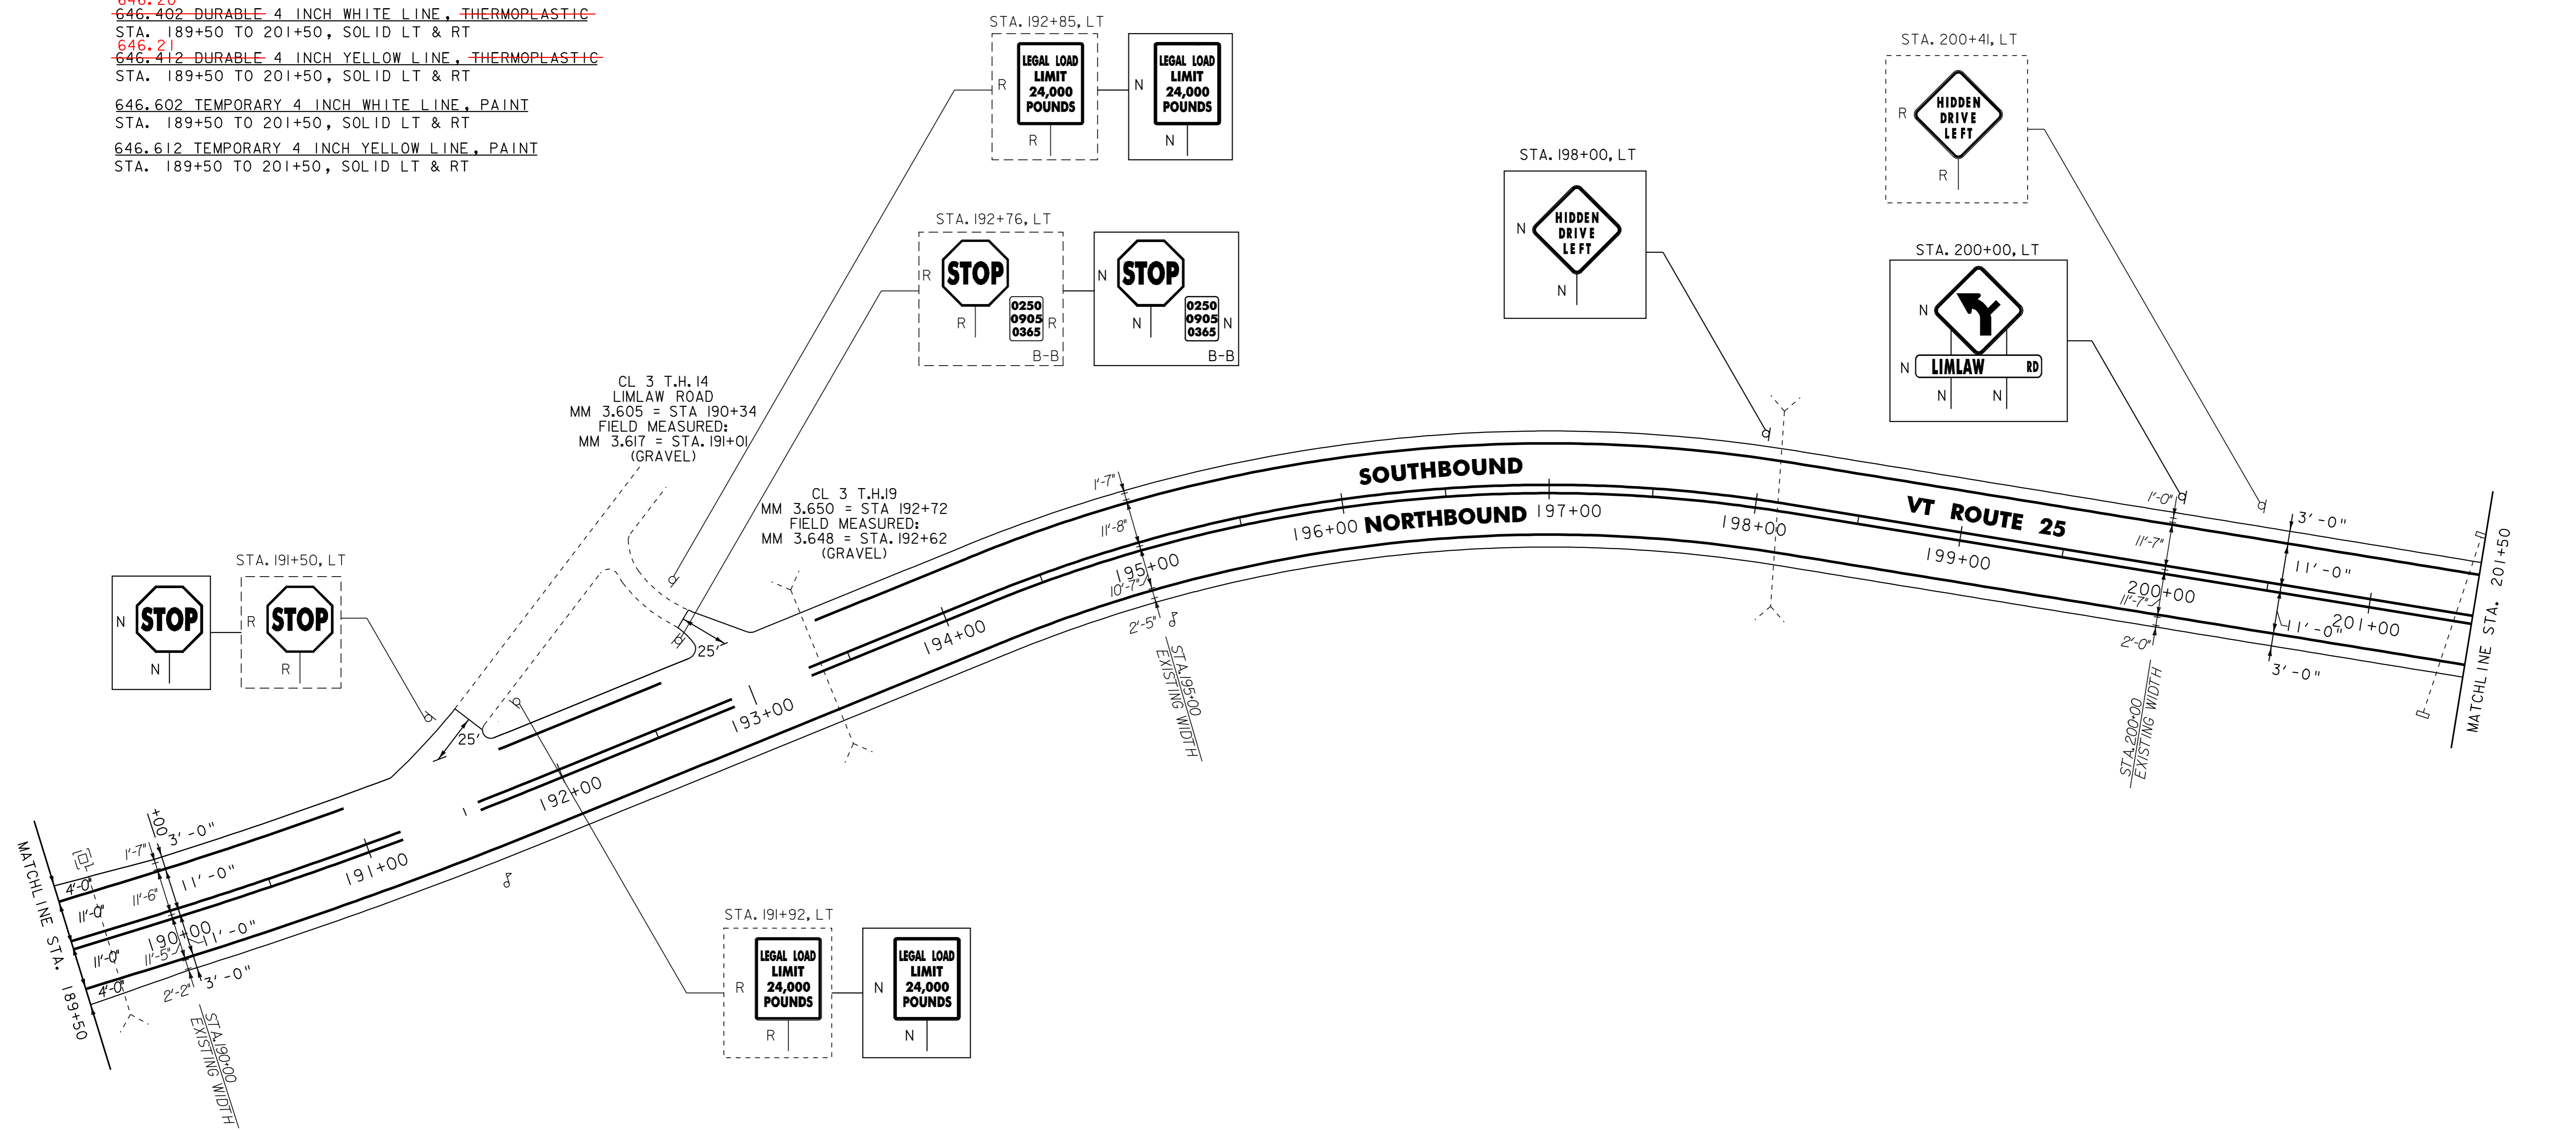

- NOTES:
1. ALL EXISTING SIGNS NOT SHOWN SHALL BE RETAINED.
 2. FOR LEGEND, SEE LAYOUT SHEET #1

NOT TO SCALE

PROJECT LAYOUT SHEET #16



PROJECT NAME: BRADFORD - ORANGE	FILE NAME: p99b178.dgn	PLOT DATE: 28-MAY-2010 13:4
PROJECT NUMBER: S1P 2213(I)	PROJECT LEADER: JLL	DRAWN BY: STANTEC
	DESIGNED BY: STANTEC	CHECKED BY: JLL
	IPARM FILE: p99b178i16.i	SHEET 33 OF 84