

621.20 STEEL BEAM GUARDRAIL, GALVANIZED  
STA. 3+50 TO 5+12.5, LT

621.50 MANUFACTURED TERMINAL SECTION, FLARED  
STA. 5+12.5 TO 5+50, LT

646.20  
~~646.402 DURABLE 4 INCH WHITE LINE, THERMOPLASTIC~~  
STA. 3+50 TO 15+50, SOLID LT & RT

646.21  
~~646.412 DURABLE 4 INCH YELLOW LINE, THERMOPLASTIC~~  
STA. 3+50 TO 15+50, SOLID LT & RT  
STA. 5+43, DOUBLE SOLID RT. (T.H. 76)

646.21  
~~646.482 DURABLE 24 INCH STOP BAR, THERMOPLASTIC~~  
STA. 5+43, RT (T.H. 76)

646.492 DURABLE LETTER OR SYMBOL, THERMOPLASTIC  
STA. 5+43, RT - "STOP"  
STA. 10+06, LT - "SCHOOL"

646.602 TEMPORARY 4 INCH WHITE LINE, PAINT  
STA. 3+50 TO 15+50, SOLID LT & RT


646.612 TEMPORARY 4 INCH YELLOW LINE, PAINT  
STA. 3+50 TO 15+50, SOLID LT & RT  
STA. 5+43, DOUBLE SOLID RT. (T.H. 76)

646.682 TEMPORARY 24 INCH STOP BAR, PAINT  
STA. 5+43, RT (T.H. 76)

~~646.692 TEMPORARY LETTER OR SYMBOL, PAINT~~  
~~STA. 5+43, RT - "STOP"~~  
~~STA. 10+06, LT - "SCHOOL"~~

675.50 REMOVING SIGNS  
AS SHOWN - 5

675.60 ERECTING SALVAGED SIGNS  
AS SHOWN - 1

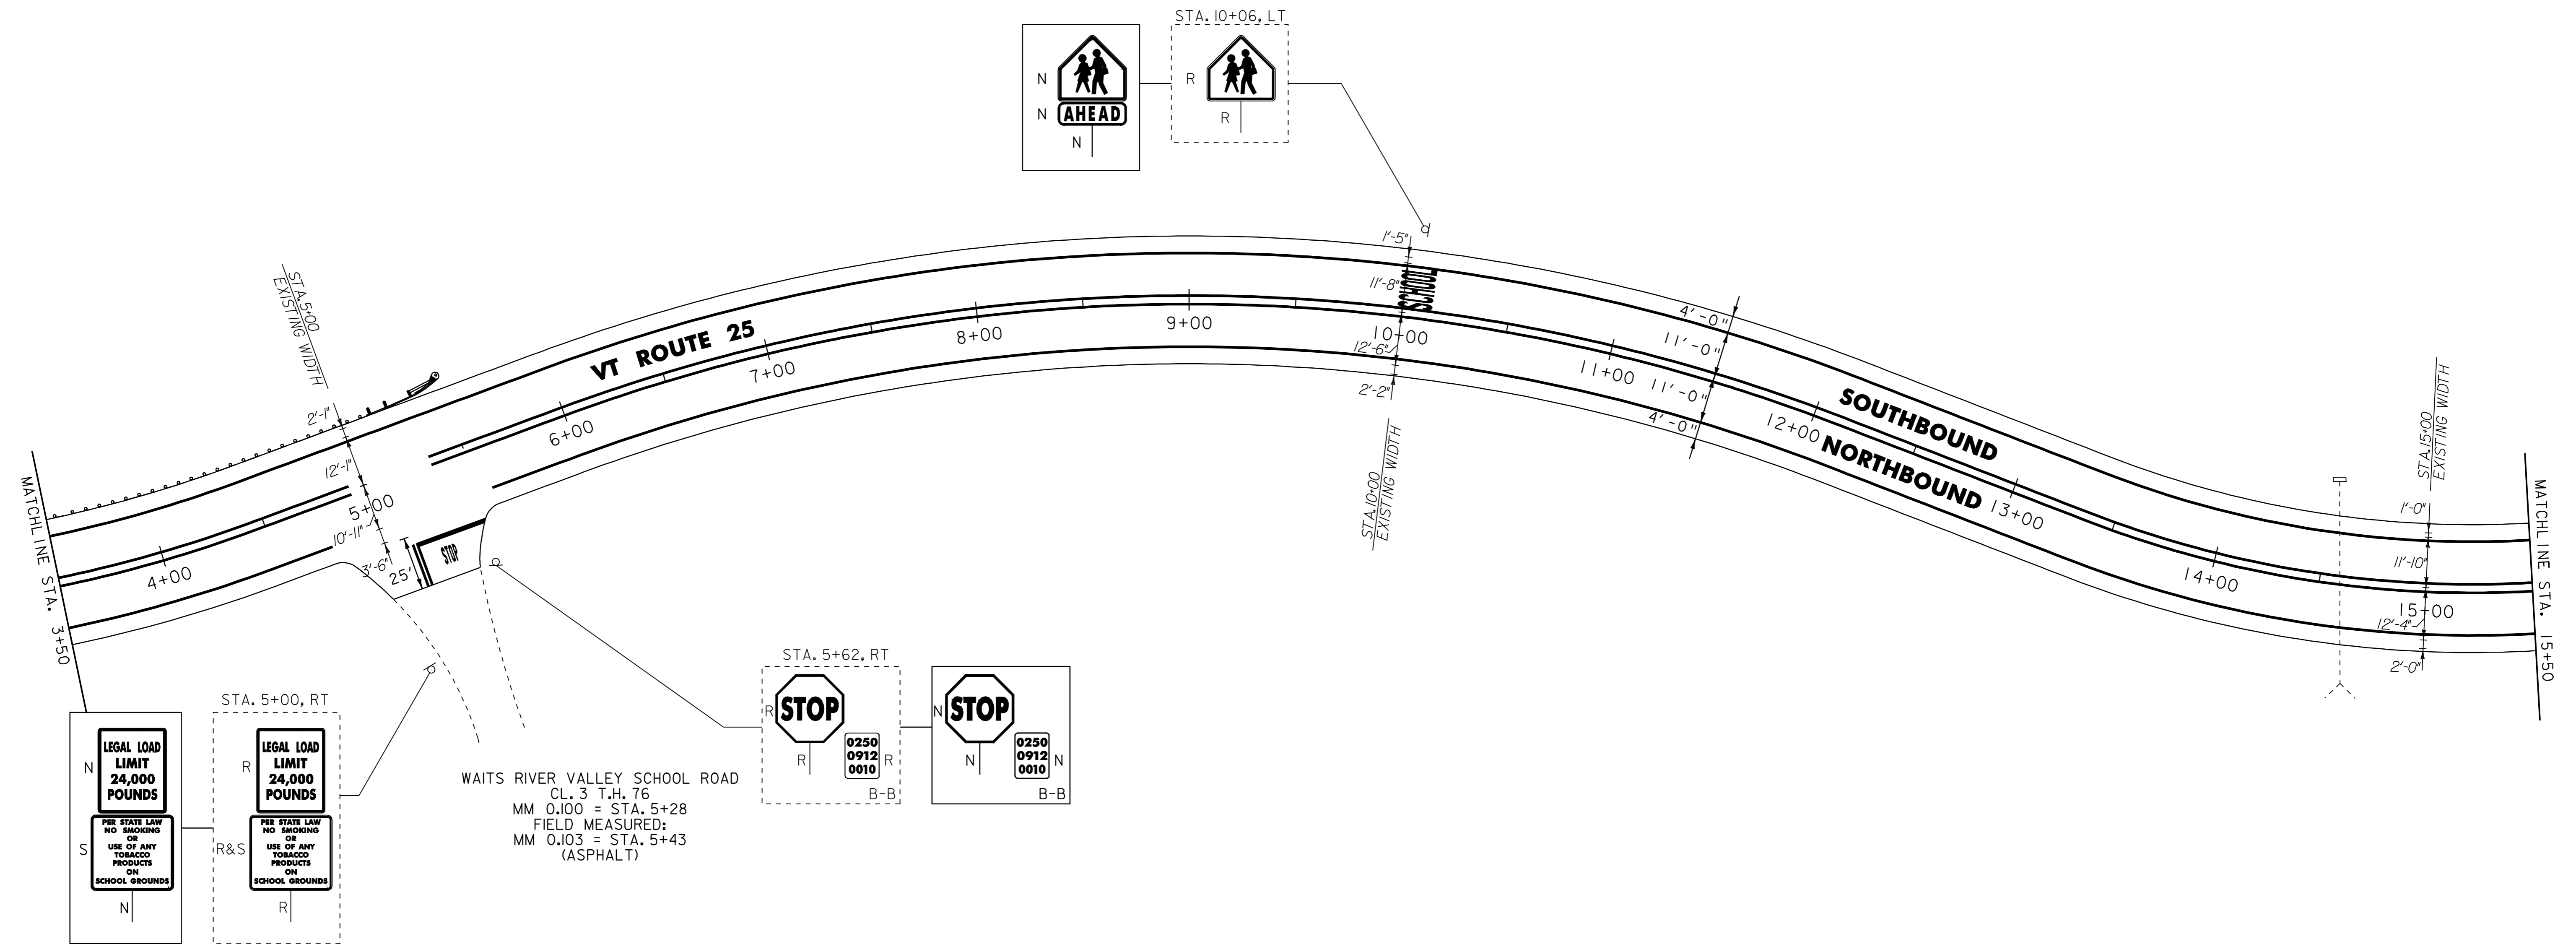

- NOTES:
1. ALL EXISTING SIGNS NOT SHOWN SHALL BE RETAINED.
  2. FOR LEGEND, SEE LAYOUT SHEET #1

NOT TO SCALE

**PROJECT LAYOUT SHEET #18**



PROJECT NAME: BRADFORD - ORANGE	FILE NAME: p99b178.dgn	PLOT DATE: 28-MAY-2010 13:4
PROJECT NUMBER: S1P_2213(1)	PROJECT LEADER: JLL	DRAWN BY: STANTEC
	DESIGNED BY: STANTEC	CHECKED BY: JLL
	IPARM FILE: p99b178i18.i	SHEET 35 OF 84