

621.20 STEEL BEAM GUARDRAIL, GALVANIZED
 STA. 17+04 TO 20+66.5, LT
 (CONNECT TO EXISTING RAIL @ 20+66.5, LT)

621.50 MANUFACTURED TERMINAL SECTION, FLARED
 STA. 16+66.5 TO 17+04, LT
~~STA. 20+82 TO 21+19.5, RT~~
 STA. 21+59.5 TO 21+97, LT
 STA. 21+84.5 TO 22+22, RT


621.80 REMOVAL AND DISPOSAL OF GUARDRAIL
 STA. 20+29 TO 20+66.5, LT
 STA. 20+82 TO 21+19.5, RT
 STA. 21+59.5 TO 21+97, LT
 STA. 21+84.5 TO 22+22, RT

~~646.20~~
~~646.402 DURABLE 4 INCH WHITE LINE, THERMOPLASTIC~~
 STA. 15+50 TO 27+50, SOLID LT & RT
~~646.21~~
~~646.412 DURABLE 4 INCH YELLOW LINE, THERMOPLASTIC~~
 STA. 15+50 TO 27+50, SOLID LT & RT

646.602 TEMPORARY 4 INCH WHITE LINE, PAINT
 STA. 15+50 TO 27+50, SOLID LT & RT
 646.612 TEMPORARY 4 INCH YELLOW LINE, PAINT
 STA. 15+50 TO 27+50, SOLID LT & RT

621.60 ANCHOR FOR STEEL BEAM RAIL
 STA 20+89 RT
 STA 19+00 LT (2)


616.47 BITUMINOUS CONCRETE GUTTERS & TRAFFIC ISLANDS
 19+29 LT & RT CULVERT CROSSING

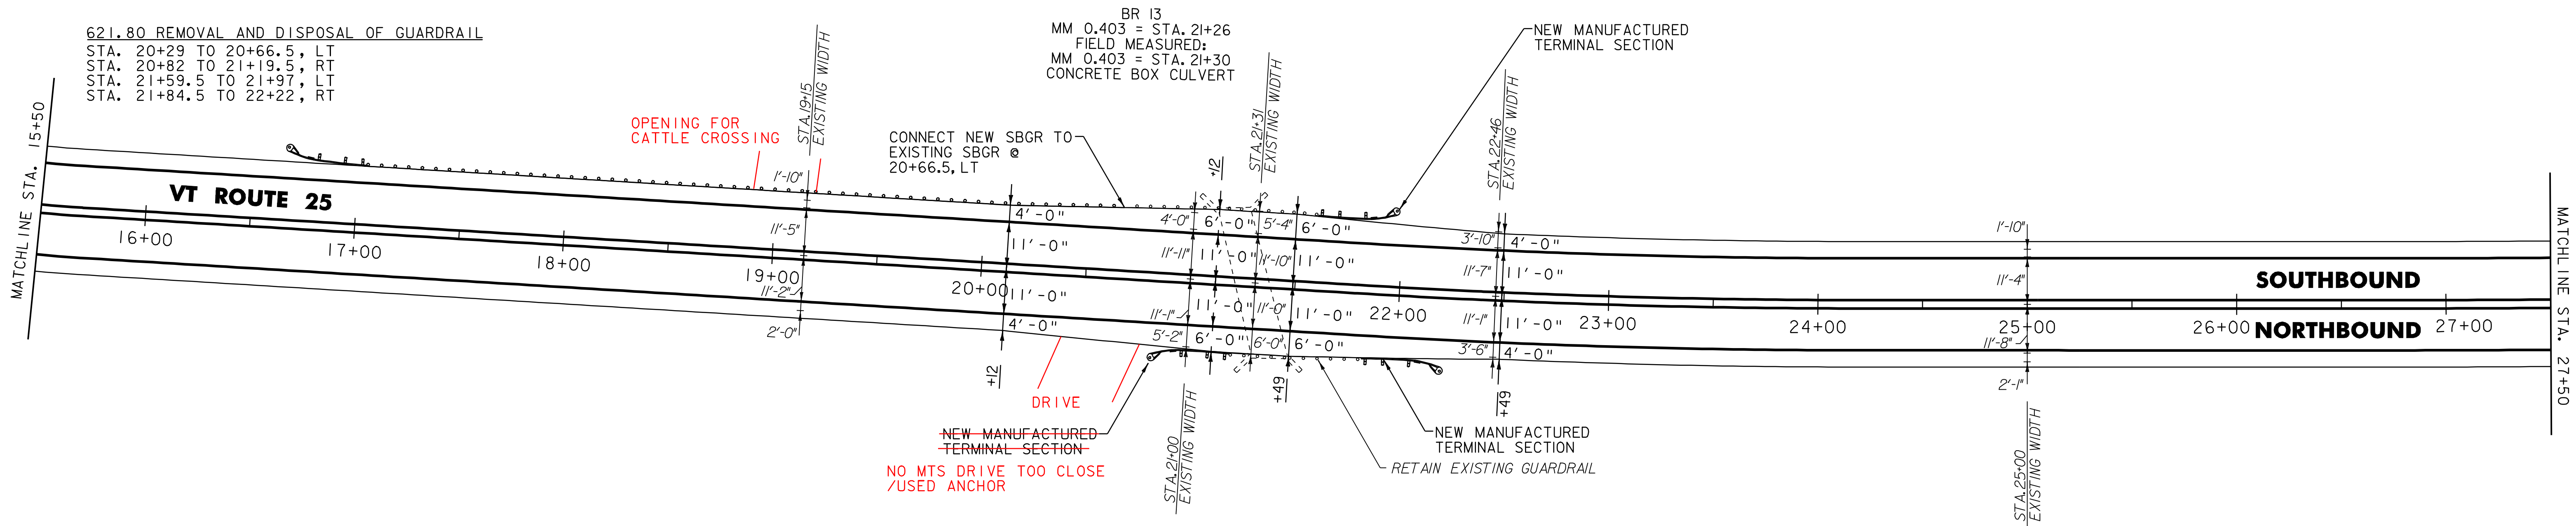

~~646.20~~
~~646.402 DURABLE 4 INCH WHITE LINE, THERMOPLASTIC~~
 STA. 27+50 TO 39+50, SOLID LT & RT
~~646.21~~
~~646.412 DURABLE 4 INCH YELLOW LINE, THERMOPLASTIC~~
 STA. 27+50 TO 39+50, SOLID LT & RT

646.602 TEMPORARY 4 INCH WHITE LINE, PAINT
 STA. 27+50 TO 39+50, SOLID LT & RT
 646.612 TEMPORARY 4 INCH YELLOW LINE, PAINT
 STA. 27+50 TO 39+50, SOLID LT & RT

616.47 BITUMINOUS CONCRETE GUTTERS AND TRAFFIC ISLANDS
 28+52 LT & RT CULVERT CROSSING

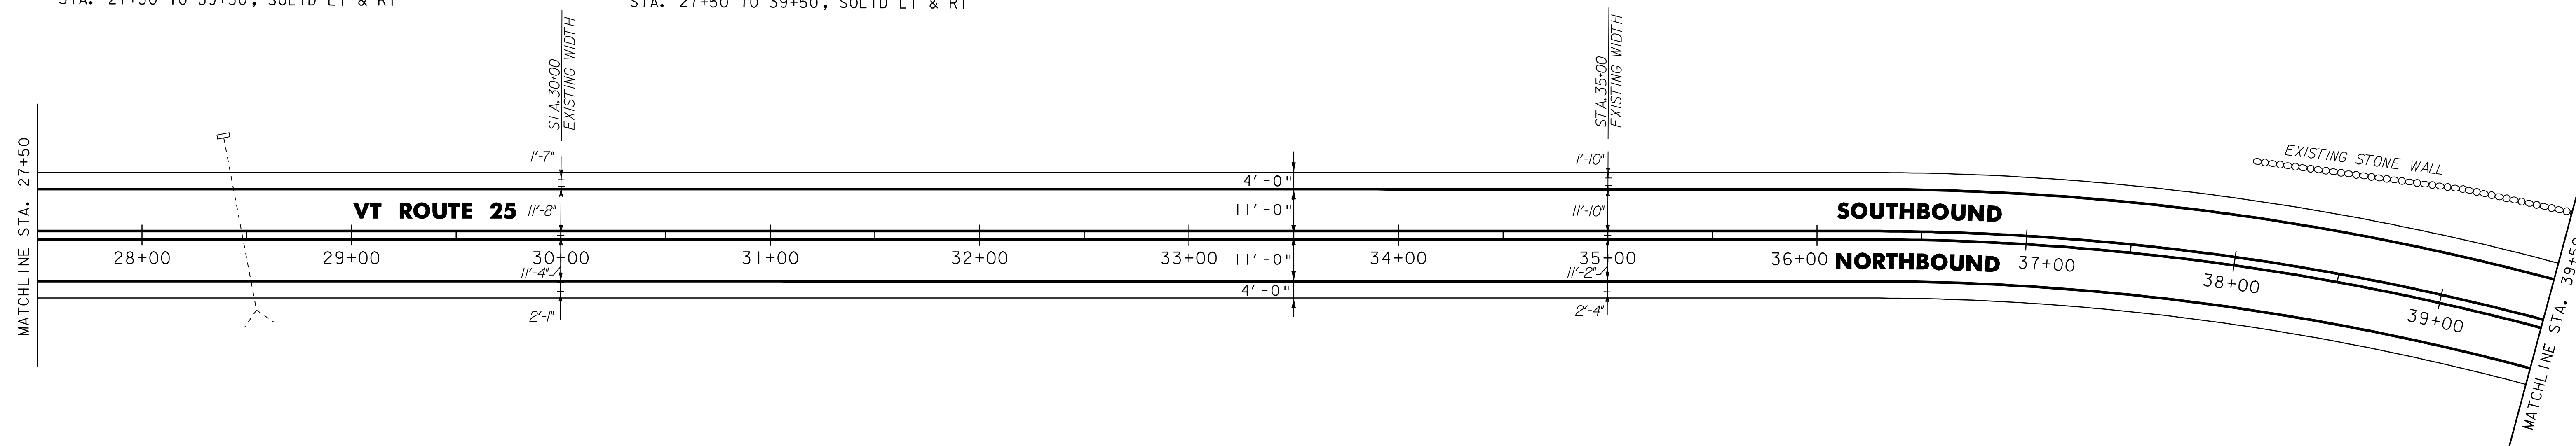

- NOTES:
 1. ALL EXISTING SIGNS NOT SHOWN SHALL BE RETAINED.
 2. FOR LEGEND, SEE LAYOUT SHEET #1

NOT TO SCALE

PROJECT LAYOUT SHEET #19



PROJECT NAME: BRADFORD - ORANGE	FILE NAME: p99b178.dgn	PLOT DATE: 28-MAY-2010 13:4
PROJECT NUMBER: S1P_2213(I)	PROJECT LEADER: JLL	DRAWN BY: STANTEC
	DESIGNED BY: STANTEC	CHECKED BY: JLL
	IPARM FILE: p99b178i19.i	SHEET 36 OF 84