

621.20 STEEL BEAM GUARDRAIL, GALVANIZED
STA. 51+42.5 TO 51+50, RT

621.205 STEEL BEAM GUARDRAIL, GALVANIZED W/8 FEET POSTS
STA. 51+22.5 TO 51+50, LT

621.50 MANUFACTURED TERMINAL SECTION, FLARED

STA. 50+85 TO 51+22.5, LT
~~STA. 51+05 TO 51+42.5, RT~~

621.80 REMOVAL AND DISPOSAL OF GUARDRAIL

STA. 50+93 TO 51+50, LT
STA. 51+05 TO 51+50, RT

~~646.20~~
~~646.402 DURABLE 4 INCH WHITE LINE, THERMOPLASTIC~~
STA. 39+50 TO 51+50, SOLID LT & RT
STA. 42+42, DOUBLE SOLID RT (T.H. 38)

646.21
~~646.412 DURABLE 4 INCH YELLOW LINE, THERMOPLASTIC~~
STA. 39+50 TO 51+50, SOLID LT & RT

646.26
~~646.482 DURABLE 24 INCH STOP BAR, THERMOPLASTIC~~
STA. 42+58, RT (T.H. 38)

646.492 DURABLE LETTER OR SYMBOL, THERMOPLASTIC
STA. 42+58, RT - "STOP"

646.602 TEMPORARY 4 INCH WHITE LINE, PAINT
STA. 39+50 TO 51+50, SOLID LT & RT
STA. 42+42, DOUBLE SOLID RT (T.H. 38)


646.612 TEMPORARY 4 INCH YELLOW LINE, PAINT
STA. 39+50 TO 51+50, SOLID LT & RT

646.682 TEMPORARY 24 INCH STOP BAR, PAINT
STA. 42+58, RT (T.H. 38)

~~646.692 TEMPORARY LETTER OR SYMBOL, PAINT~~
~~STA. 42+58, LT - "STOP"~~

675.50 REMOVING SIGNS
AS SHOWN - 4

621.80 ANCHOR FOR STEEL BEAM RAIL
51+05 RT

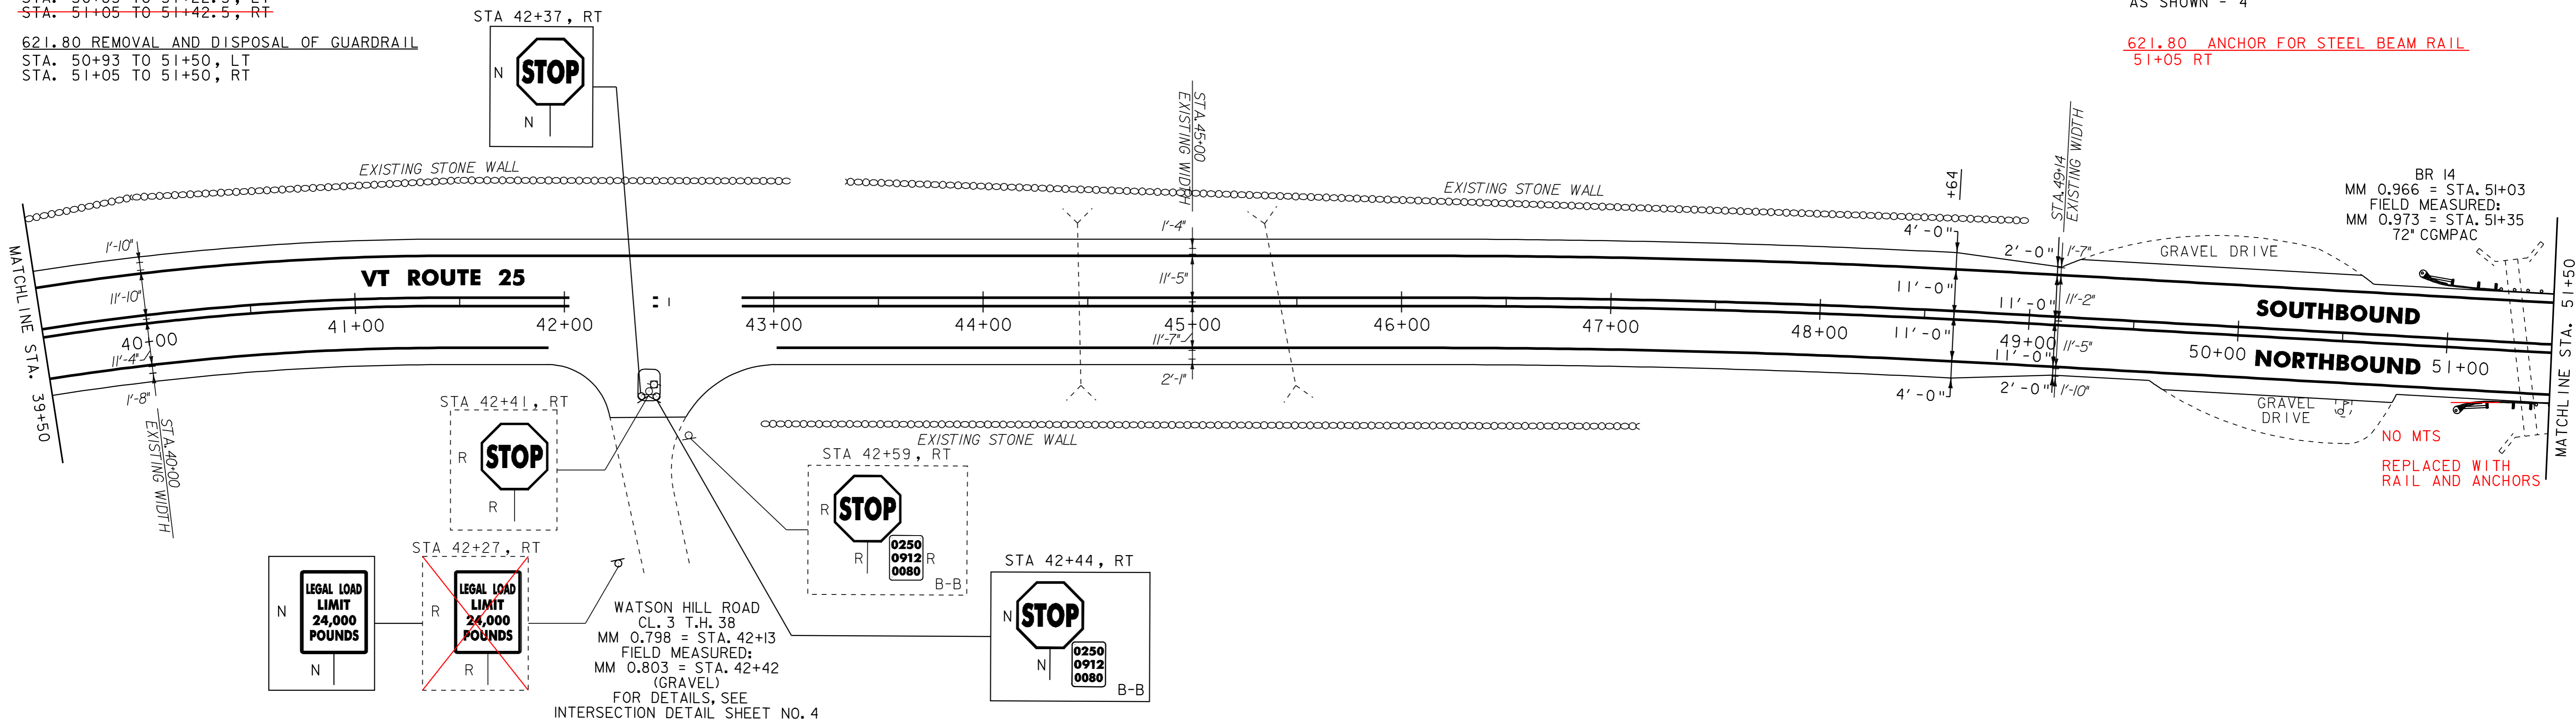

621.20 STEEL BEAM GUARDRAIL, GALVANIZED
STA. 51+50 TO 52+05, RT
54+00 STA. 54+10 TO 55+85, LT
STA. 58+39 TO 59+26.5, LT
57+87.5 63+50

621.205 STEEL BEAM GUARDRAIL, GALVANIZED W/8 FEET POSTS
STA. 51+50 TO 54+10, LT 54+00
~~STA. 59+26.5 TO 63+50, LT~~

621.50 MANUFACTURED TERMINAL SECTION, FLARED
STA. 52+05 TO 52+42.5, RT
56+40 STA. 55+85 TO 56+22.5, LT 77.5
STA. 58+01.5 TO 58+39, LT
57+50 57+87.5

621.80 REMOVAL AND DISPOSAL OF GUARDRAIL
STA. 51+50 TO 51+79, RT
STA. 51+50 TO 56+23, LT
STA. 58+01.5 TO 63+50, LT


646.20
~~646.402 DURABLE 4 INCH WHITE LINE, THERMOPLASTIC~~
STA. 51+50 TO 63+50, SOLID LT & RT

646.21
~~646.412 DURABLE 4 INCH YELLOW LINE, THERMOPLASTIC~~
STA. 51+50 TO 63+50, SOLID LT & RT

646.602 TEMPORARY 4 INCH WHITE LINE, PAINT
STA. 51+50 TO 63+50, SOLID LT & RT

646.612 TEMPORARY 4 INCH YELLOW LINE, PAINT
STA. 51+50 TO 63+50, SOLID LT & RT

621.60 ANCHOR FOR STEEL BEAM RAIL
STA 51+80 RT

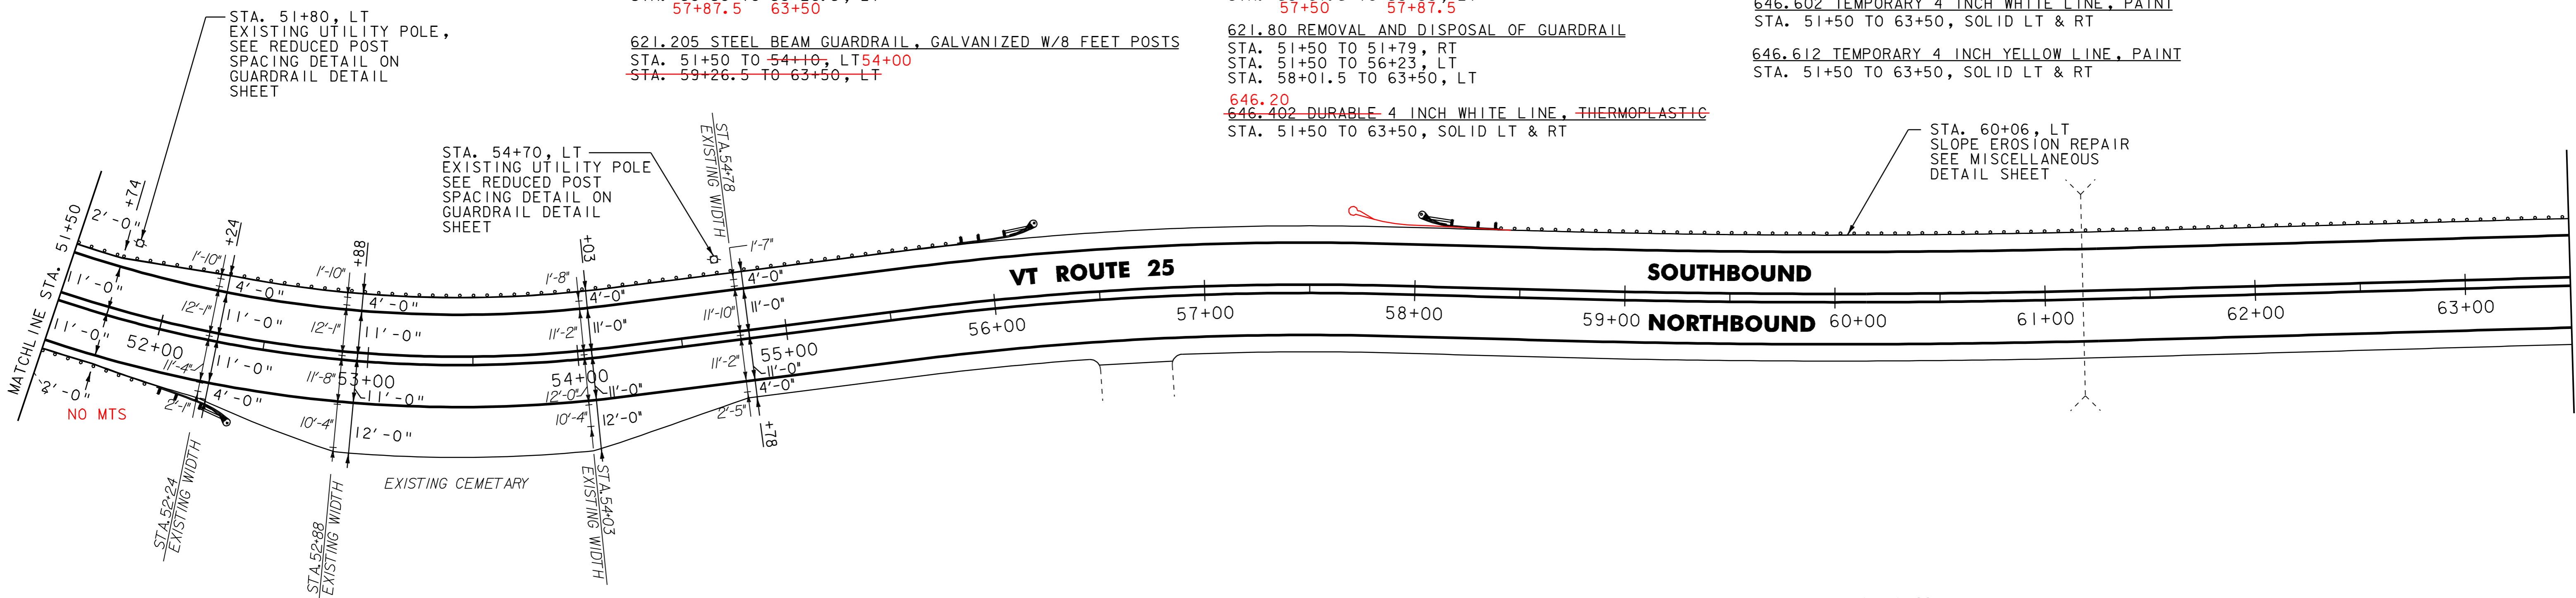

NOTES:

1. ALL EXISTING SIGNS NOT SHOWN SHALL BE RETAINED.
2. FOR LEGEND, SEE LAYOUT SHEET #1



NOT TO SCALE

PROJECT
LAYOUT
SHEET #20

PROJECT NAME: BRADFORD - ORANGE
PROJECT NUMBER: S1P 2213(I)

FILE NAME: p99b178.dgn
PROJECT LEADER: JLL
DESIGNED BY: STANTEC
IPARM FILE: p99b178120.i

PLOT DATE: 28-MAY-2010 13:4
DRAWN BY: STANTEC
CHECKED BY: JLL
SHEET 37 OF 84