

621.20  
~~621.205 STEEL BEAM GUARDRAIL, GALVANIZED W/8 FEET POSTS~~  
 STA. 63+50 TO 65+51.5, LT

621.50 MANUFACTURED TERMINAL SECTION, FLARED  
 STA. 65+51.5 TO 65+89, LT

621.80 REMOVAL AND DISPOSAL OF GUARDRAIL  
 STA. 63+50 TO 65+95, LT

646.20  
~~646.402 DURABLE 4 INCH WHITE LINE, THERMOPLASTIC~~  
 STA. 63+50 TO 75+50, SOLID LT & RT  
 STA. 72+88, DOUBLE SOLID LT (T.H. 57)

646.21  
~~646.412 DURABLE 4 INCH YELLOW LINE, THERMOPLASTIC~~  
 STA. 63+50 TO 75+50, SOLID LT & RT  
 STA. 72+88, DOUBLE SOLID LT (T.H. 57)

646.26  
~~646.482 DURABLE 24 INCH STOP BAR, THERMOPLASTIC~~  
 STA. 72+88, LT (T.H. 57)

646.492 DURABLE LETTER OR SYMBOL, THERMOPLASTIC  
 STA. 72+88, LT - "STOP"


646.602 TEMPORARY 4 INCH WHITE LINE, PAINT  
 STA. 63+50 TO 75+50, SOLID LT & RT  
 STA. 72+88, DOUBLE SOLID LT (T.H. 57)

646.612 TEMPORARY 4 INCH YELLOW LINE, PAINT  
 STA. 63+50 TO 75+50, SOLID LT & RT  
 STA. 72+88, DOUBLE SOLID LT (T.H. 57)

646.682 TEMPORARY 24 INCH STOP BAR, PAINT  
 STA. 72+88, LT (T.H. 57)

~~646.692 TEMPORARY LETTER OR SYMBOL, PAINT~~  
~~STA. 72+88, LT - "STOP"~~

675.50 REMOVING SIGNS  
 AS SHOWN - 6

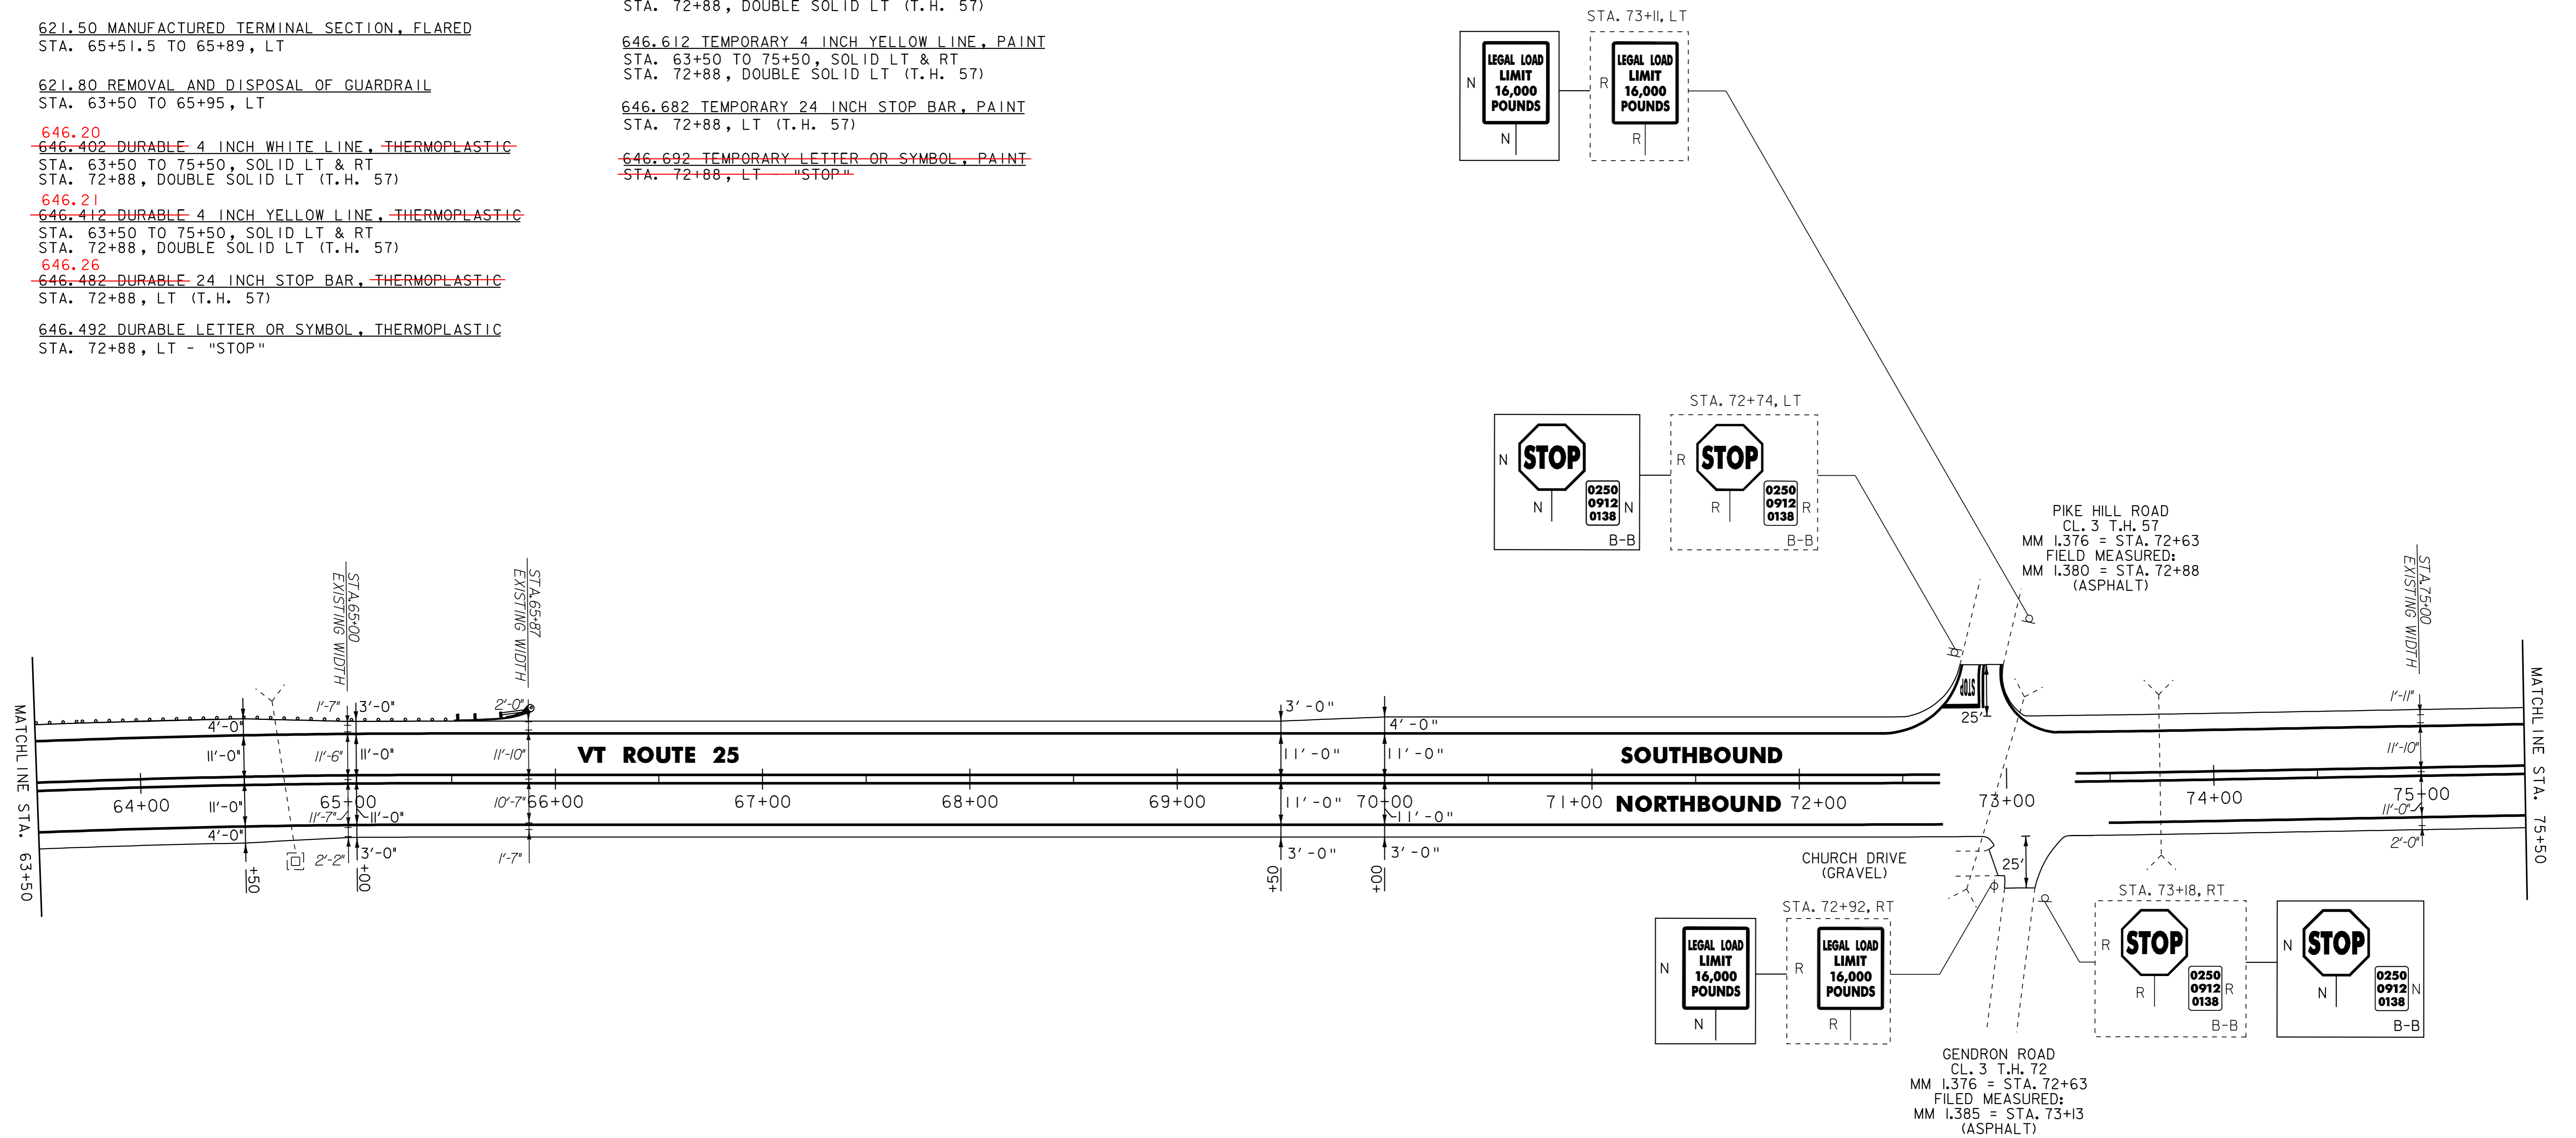

- NOTES:
1. ALL EXISTING SIGNS NOT SHOWN SHALL BE RETAINED.
  2. FOR LEGEND, SEE LAYOUT SHEET #1

<b>NOT TO SCALE</b>  <b>PROJECT LAYOUT SHEET #21</b>	PROJECT NAME: <u>BRADFORD - ORANGE</u>
	PROJECT NUMBER: <u>SIP 2213(I)</u>
	FILE NAME: <u>p99b178.dgn</u> PLOT DATE: <u>28-MAY-2010 13:4</u>
	PROJECT LEADER: <u>JLL</u> DRAWN BY: <u>SIANTEC</u>
DESIGNED BY: <u>SIANTEC</u> CHECKED BY: <u>JLL</u>	
<b>IPARM FILE: p99b178I21.i</b> SHEET <u>38</u> OF <u>84</u>	

