


604.412, 604.415, OR 604.418 REHAB.
 DI'S, CB'S OR MH'S, CLASS I, II OR III
 STA. 81+51, RT **NO WORK WAS DONE**

~~646.20~~
~~646.402 DURABLE 4 INCH WHITE LINE, THERMOPLASTIC~~
 STA. 75+50 TO 87+50, SOLID LT & RT

~~646.21~~
~~646.412 DURABLE 4 INCH YELLOW LINE, THERMOPLASTIC~~
 STA. 75+50 TO 87+50, SOLID LT & RT

646.602 TEMPORARY 4 INCH WHITE LINE, PAINT
 STA. 75+50 TO 87+50, SOLID LT & RT

646.612 TEMPORARY 4 INCH YELLOW LINE, PAINT
 STA. 75+50 TO 87+50, SOLID LT & RT

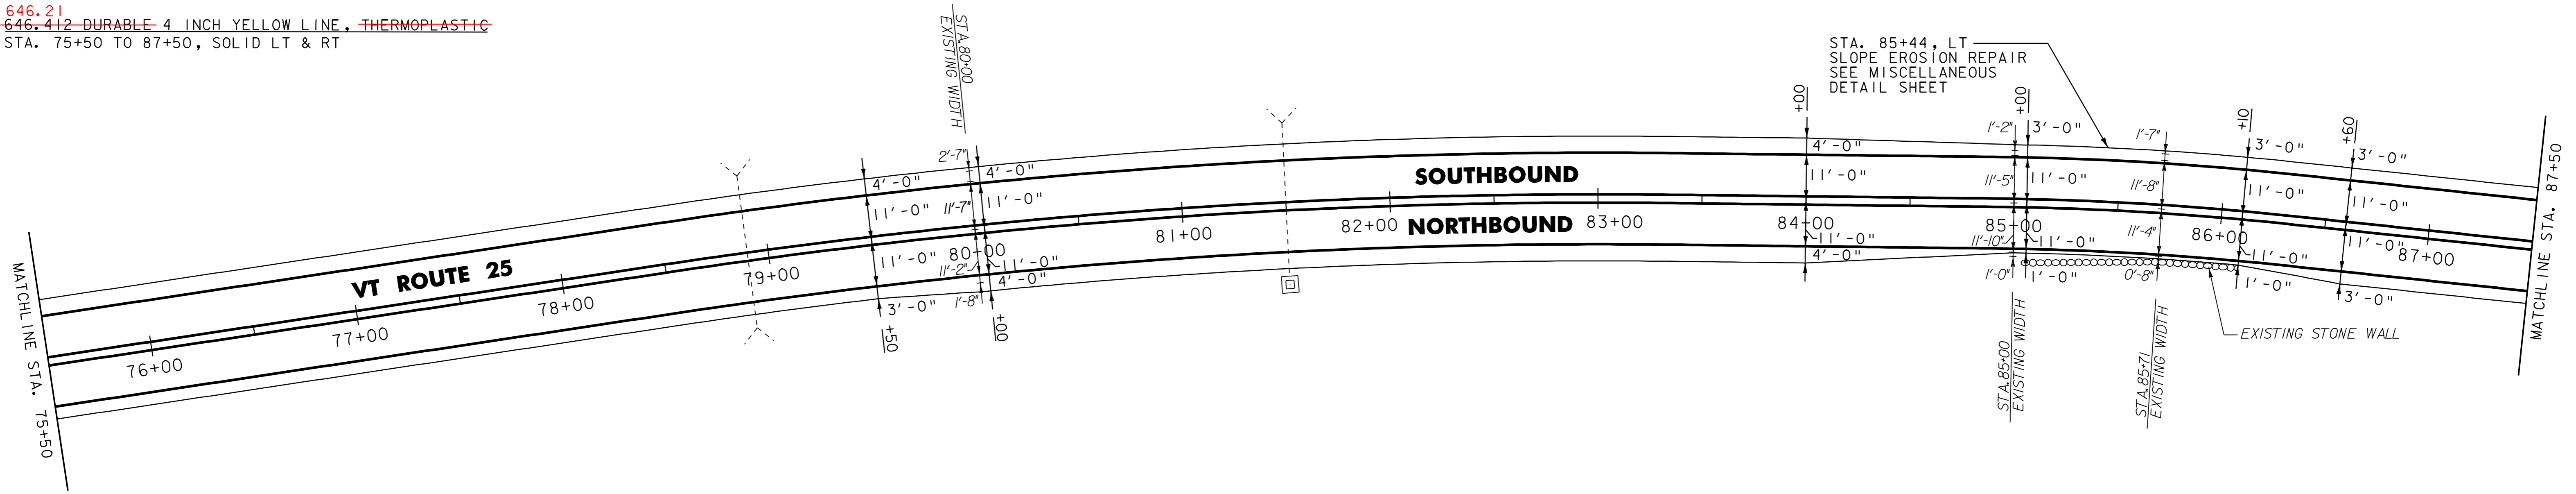

621.50 MANUFACTURED TERMINAL SECTION, FLARED
 STA. 98+18 TO 98+55.5, LT

621.80 REMOVAL AND DISPOSAL OF GUARDRAIL
 STA. 98+18 TO 98+55.5, LT


~~646.20~~
~~646.402 DURABLE 4 INCH WHITE LINE, THERMOPLASTIC~~
 STA. 87+50 TO 99+00, SOLID LT & RT

~~646.21~~
~~646.412 DURABLE 4 INCH YELLOW LINE, THERMOPLASTIC~~
 STA. 87+50 TO 99+00, SOLID LT & RT

646.602 TEMPORARY 4 INCH WHITE LINE, PAINT
 STA. 87+50 TO 99+00, SOLID LT & RT

646.612 TEMPORARY 4 INCH YELLOW LINE, PAINT
 STA. 87+50 TO 99+00, SOLID LT & RT

621.20 STEEL BEAM GUARDRAIL, GALVANIZED
 98+55.5 TO 99+00 LT

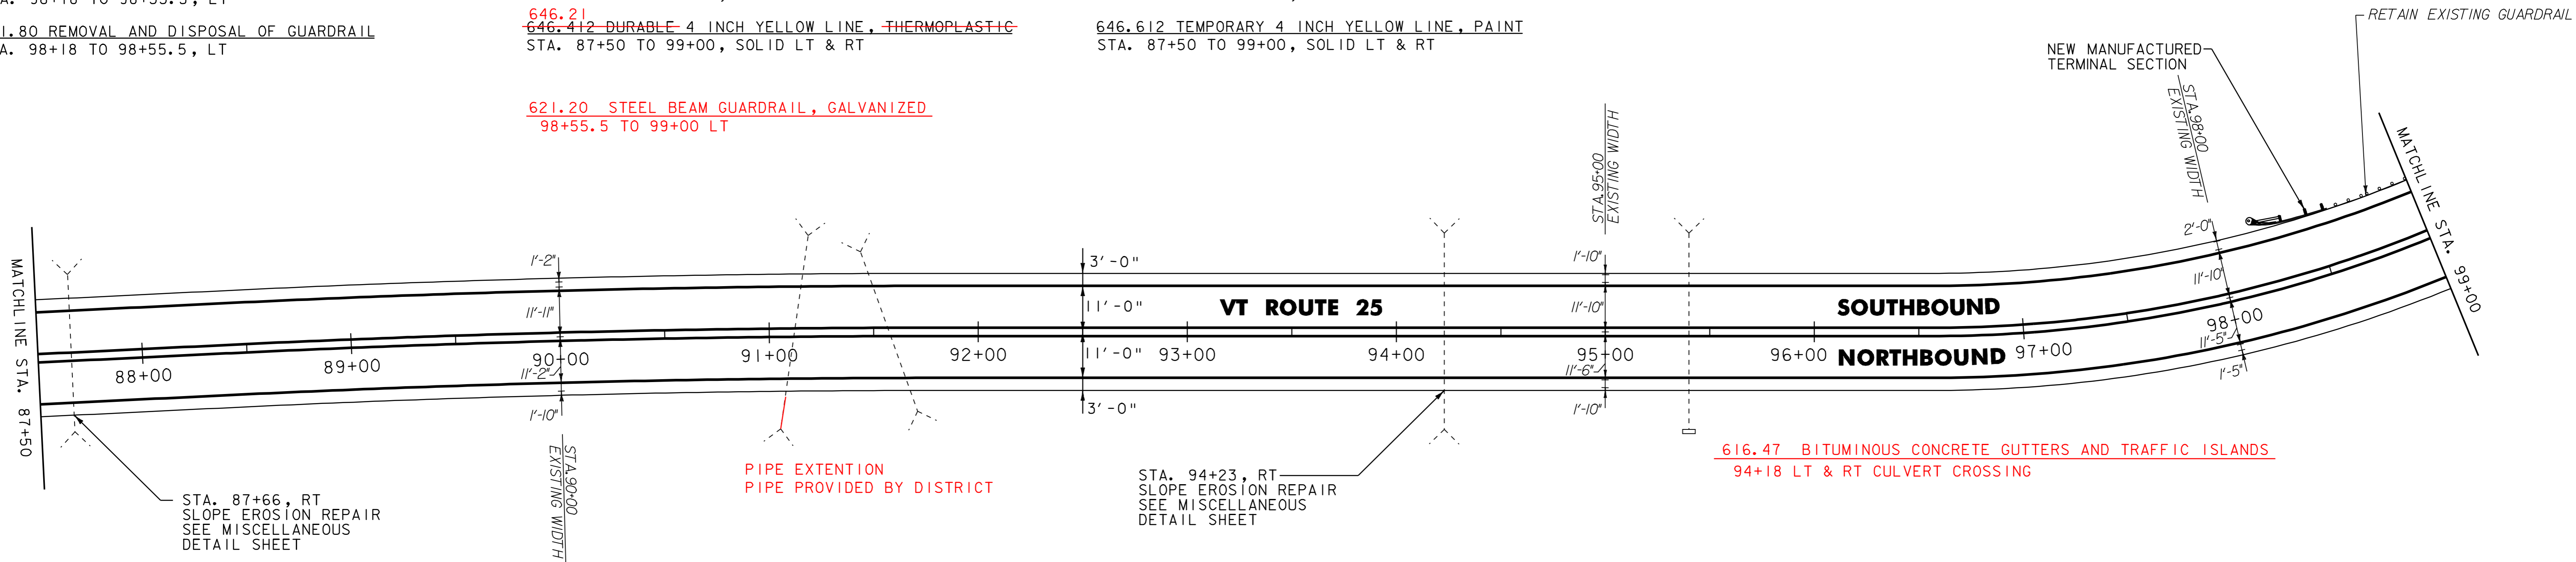

- NOTES:
1. ALL EXISTING SIGNS NOT SHOWN SHALL BE RETAINED.
 2. FOR LEGEND, SEE LAYOUT SHEET #1

NOT TO SCALE

PROJECT LAYOUT SHEET #22



PROJECT NAME: BRADFORD - ORANGE	FILE NAME: p99b178.dgn	PLOT DATE: 28-MAY-2010 13:4
PROJECT NUMBER: STP 2213(I)	PROJECT LEADER: JLL	DRAWN BY: STANTEC
	DESIGNED BY: STANTEC	CHECKED BY: JLL
	IPARM FILE: p99b178i22.i	SHEET 39 OF 84