

100+17.5 TO 100+90 RT (UP HONEY CORNERS RD)

621.20 STEEL BEAM GUARDRAIL, GALVANIZED  
STA. 103+71.5 TO 108+46.5, LT  
99+00 TO 101+50.5 LT

621.50 MANUFACTURED TERMINAL SECTION, FLARED  
STA. 101+50.5 TO 101+88, LT  
STA. 103+34 TO 103+71.5, LT  
STA. 108+46.5 TO 108+84, LT  
99+00 TO 100+17.5 RT


621.80 REMOVAL AND DISPOSAL OF GUARDRAIL  
STA. 101+50.5 TO 101+88, LT  
STA. 104+41 TO 108+84, LT

621.60 ANCHORS FOR STEEL BEAM RAIL  
STA 100+90 RT (AT TANGENT)  
STA 100+90 RT (RADUS ON HONEY CORNERS RD)

646.402 DURABLE 4 INCH WHITE LINE, THERMOPLASTIC  
STA. 99+00 TO 111+00, SOLID LT & RT  
646.412 DURABLE 4 INCH YELLOW LINE, THERMOPLASTIC  
STA. 99+00 TO 111+00, SOLID LT & RT

646.602 TEMPORARY 4 INCH WHITE LINE, PAINT  
STA. 99+00 TO 111+00, SOLID LT & RT  
646.612 TEMPORARY 4 INCH YELLOW LINE, PAINT  
STA. 99+00 TO 111+00, SOLID LT & RT

675.50 REMOVING SIGNS  
AS SHOWN - 3

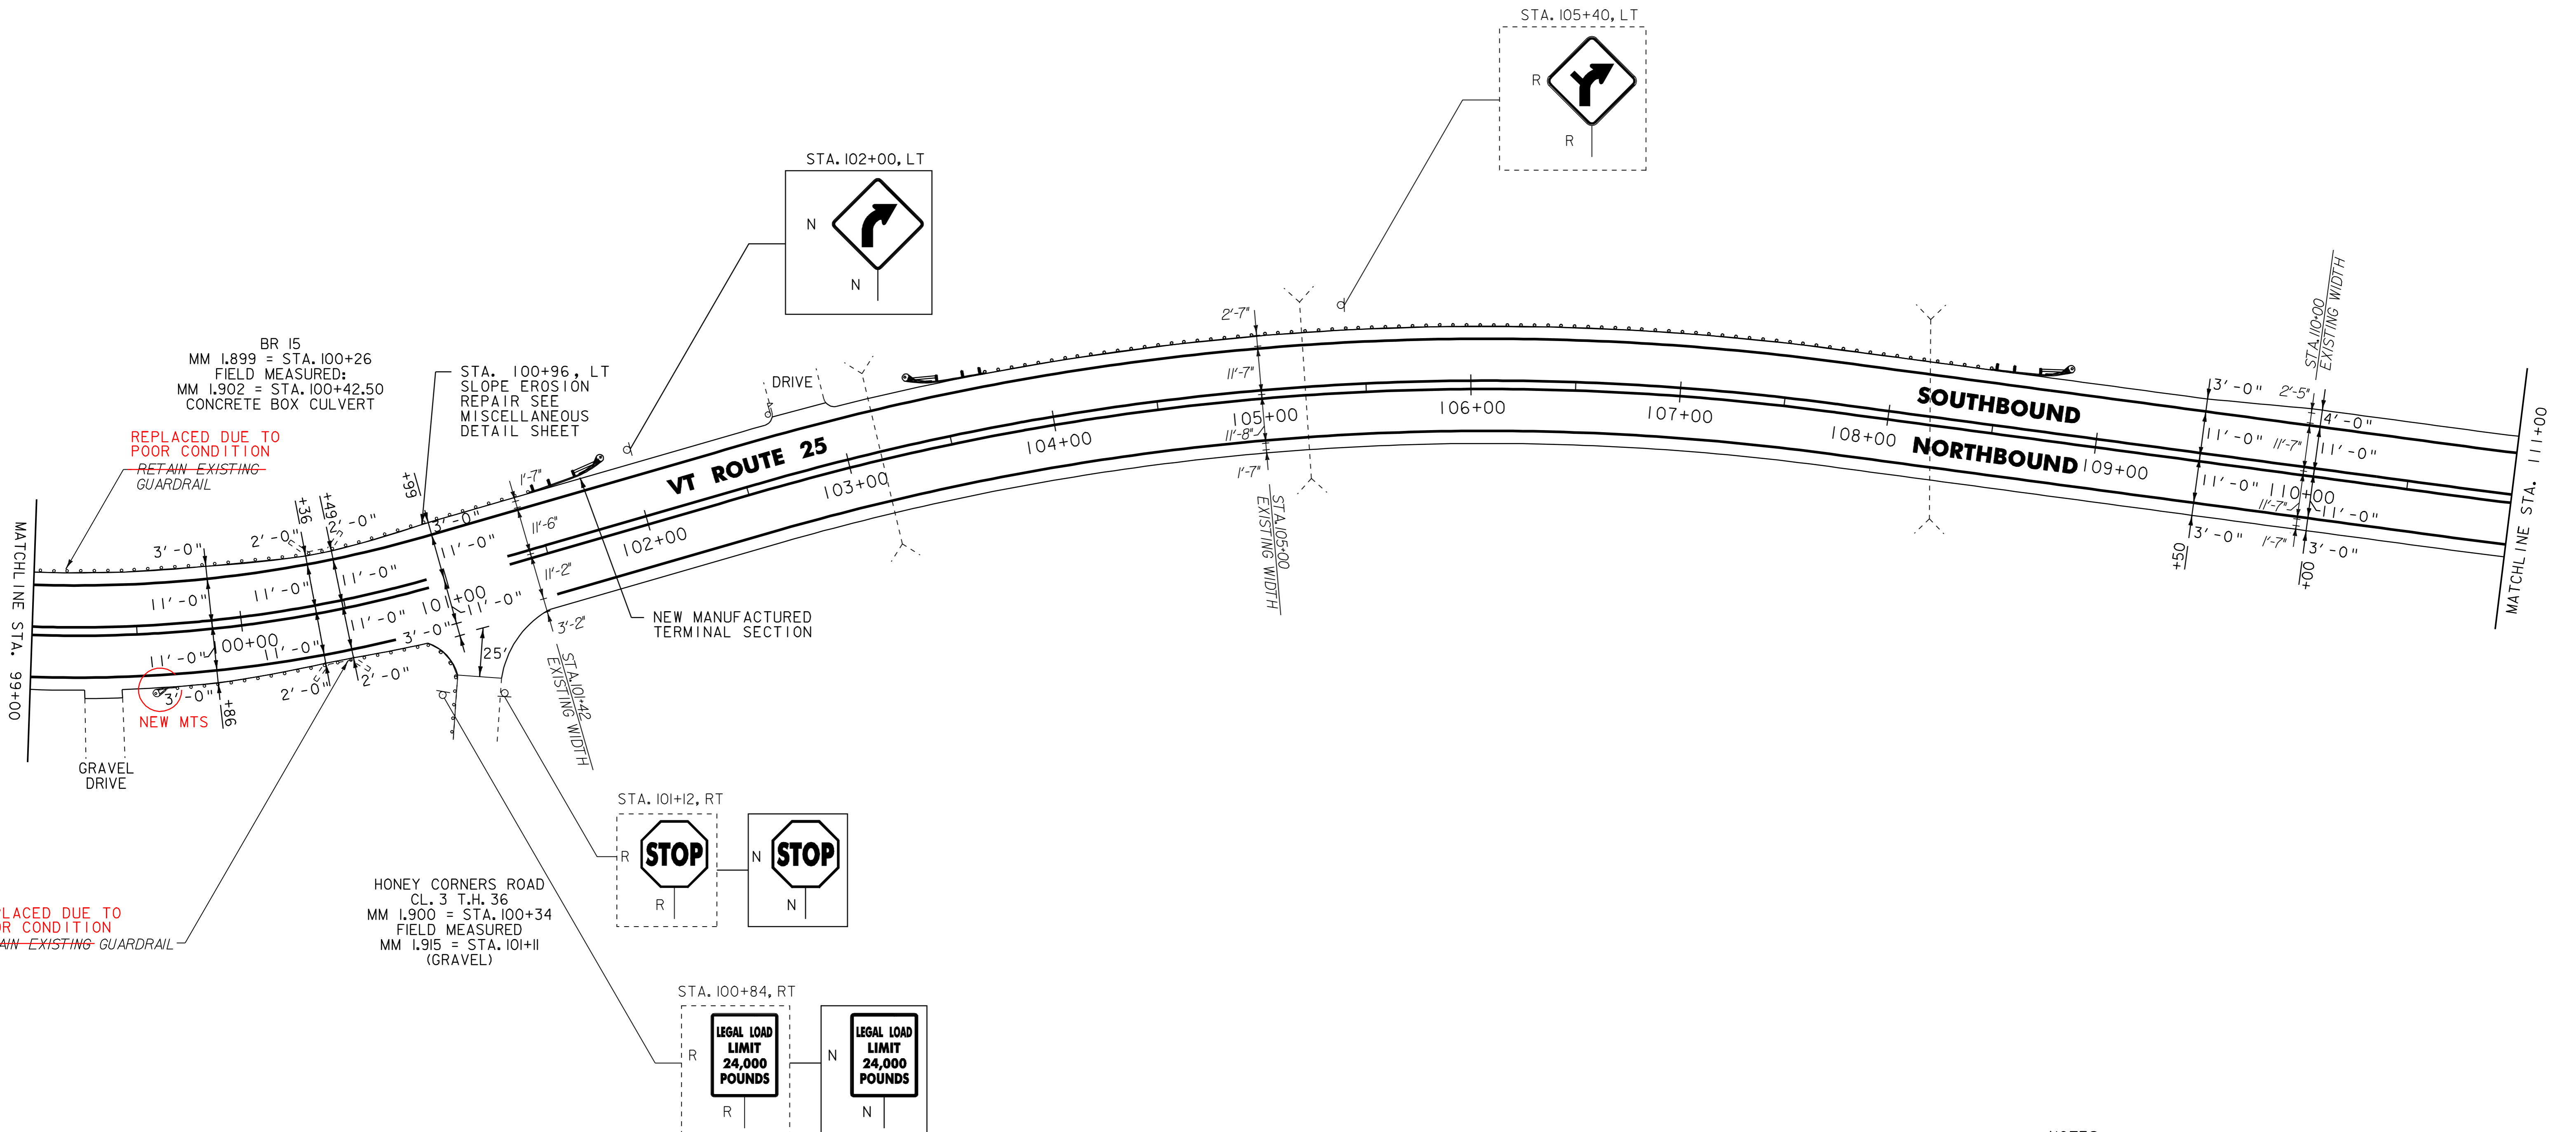

- NOTES:
1. ALL EXISTING SIGNS NOT SHOWN SHALL BE RETAINED.
  2. FOR LEGEND, SEE LAYOUT SHEET #1

<b>NOT TO SCALE</b>  <b>PROJECT LAYOUT SHEET #23</b>	PROJECT NAME: BRADFORD - ORANGE
	PROJECT NUMBER: STP 2213(I)
	FILE NAME: p99b178.dgn
	PLOT DATE: 28-MAY-2010 13:4
PROJECT LEADER: JLL	DRAWN BY: STANTEC
DESIGNED BY: STANTEC	CHECKED BY: JLL
IPARM FILE: p99b178I23.i	SHEET 40 OF 84

