

621.20 STEEL BEAM GUARDRAIL, GALVANIZED
 STA. 144+68 TO 144+93, RT
 STA. 146+05 TO 146+50, RT
 STA. 146+42.5 TO 146+50, LT

621.50 MANUFACTURED TERMINAL SECTION, FLARED
 STA. 144+55.5 TO 144+93, LT

621.60 ANCHOR FOR STEEL BEAM RAIL
 STA. 144+68, RT
 144+53.5

621.70 GUARDRAIL APPROACH SECTION, GALVANIZED TYPE I
 STA. 145+92.5 TO 146+42.5, LT
 (CONNECT TO EXISTING BRIDGE RAIL ON BR 17)

621.71 GUARDRAIL APPROACH SECTION, GALVANIZED TYPE II
 STA. 144+93 TO 145+05.5, LT
 STA. 144+93 TO 145+05.5, RT
 STA. 145+92.5 TO 146+05, RT
 (CONNECT ALL SECTIONS TO THE EXISTING BRIDGE RAIL ON BR 17)

621.80 REMOVAL AND DISPOSAL OF GUARDRAIL
 STA. 144+42 TO 145+05.5, LT
 STA. 144+56 TO 145+05.5, RT
 STA. 145+92 TO 146+50, LT
 STA. 145+92 TO 146+50, RT

646.20
~~646.402 DURABLE 4 INCH WHITE LINE, THERMOPLASTIC~~
 STA. 134+50 TO 146+50, SOLID LT & RT
 STA. 143+45, DOUBLE SOLID RT. (T.H. 49)

646.21
~~646.412 DURABLE 4 INCH YELLOW LINE, THERMOPLASTIC~~
 STA. 134+50 TO 134+64, DASHED LT, SOLID RT
 STA. 134+64 TO 146+50, SOLID LT & RT
 STA. 143+45, DOUBLE SOLID RT. (T.H. 49)

646.482 DURABLE 24 INCH STOP BAR, THERMOPLASTIC
 STA. 143+45, RT (T.H. 49)



646.492 DURABLE LETTER OR SYMBOL, THERMOPLASTIC
 STA. 143+45, RT - "STOP"

646.602 TEMPORARY 4 INCH WHITE LINE, PAINT
 STA. 134+50 TO 146+50, SOLID LT & RT
 STA. 143+45, DOUBLE SOLID RT. (T.H. 49)

646.612 TEMPORARY 4 INCH YELLOW LINE, PAINT
 STA. 134+50 TO 134+64, DASHED LT, SOLID RT
 STA. 134+64 TO 146+50, SOLID LT & RT
 STA. 143+45, DOUBLE SOLID RT. (T.H. 49)

646.682 TEMPORARY 24 INCH STOP BAR, PAINT
 STA. 143+45, RT (T.H. 49)

646.692 TEMPORARY LETTER OR SYMBOL, PAINT
 STA. 143+45, RT - "STOP"

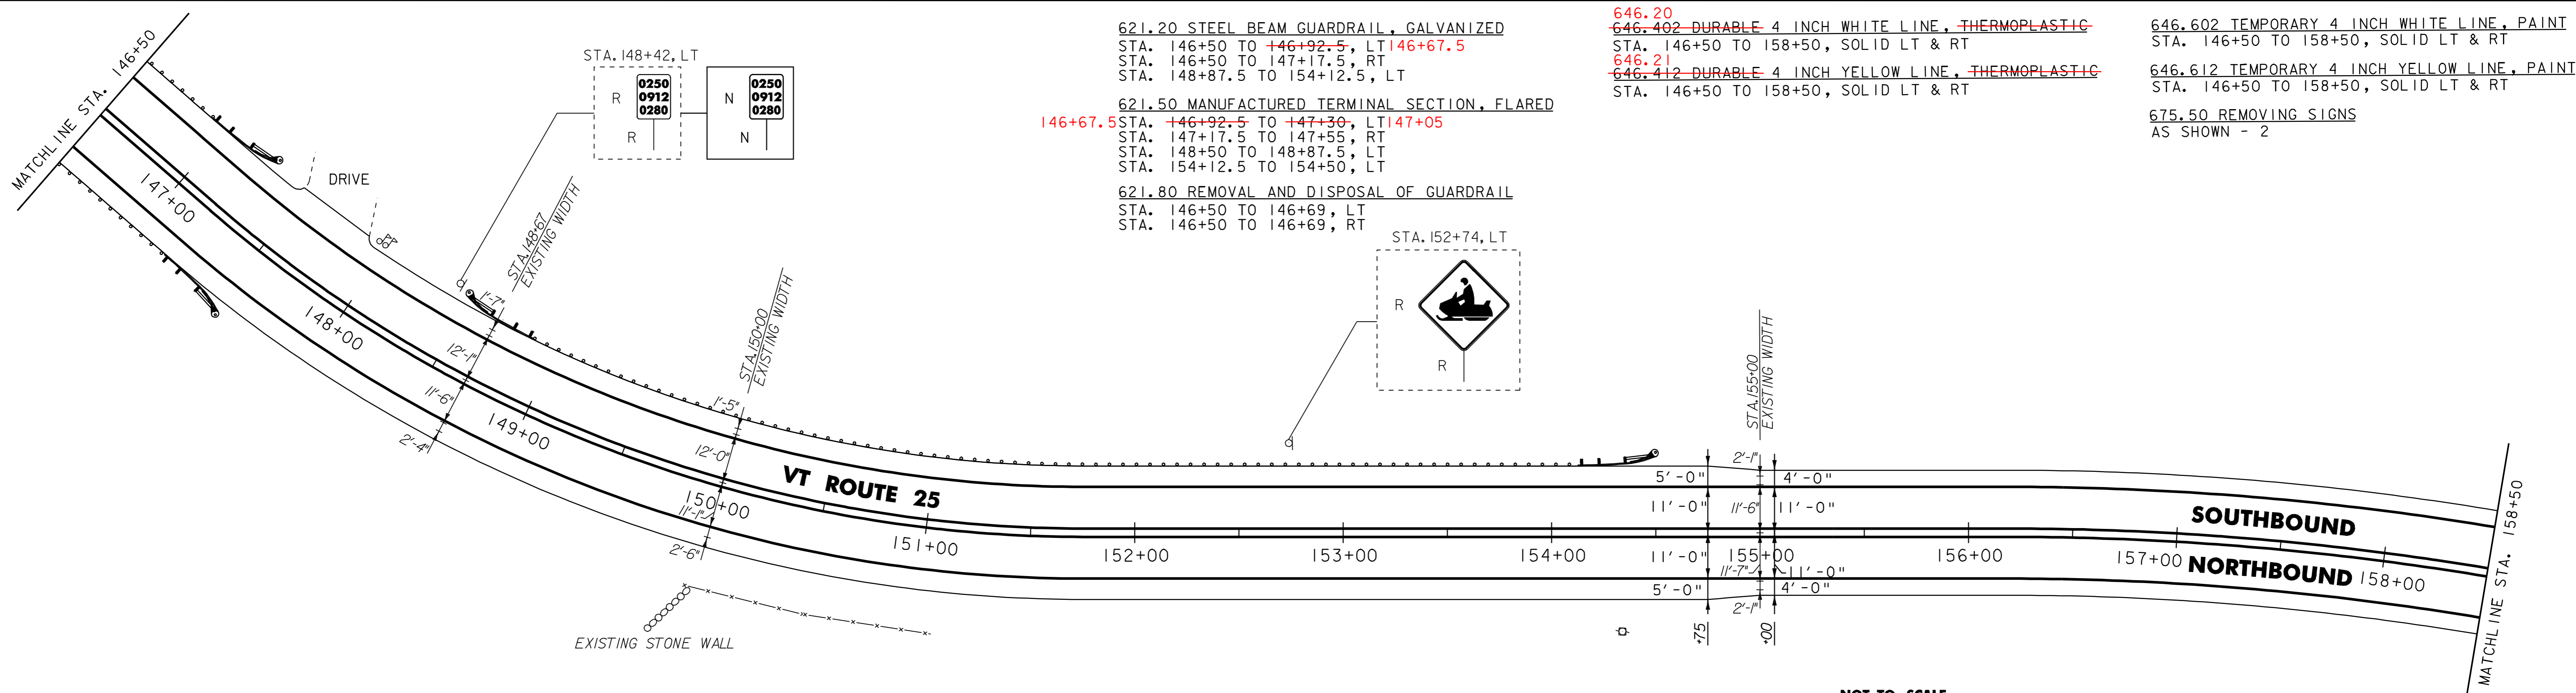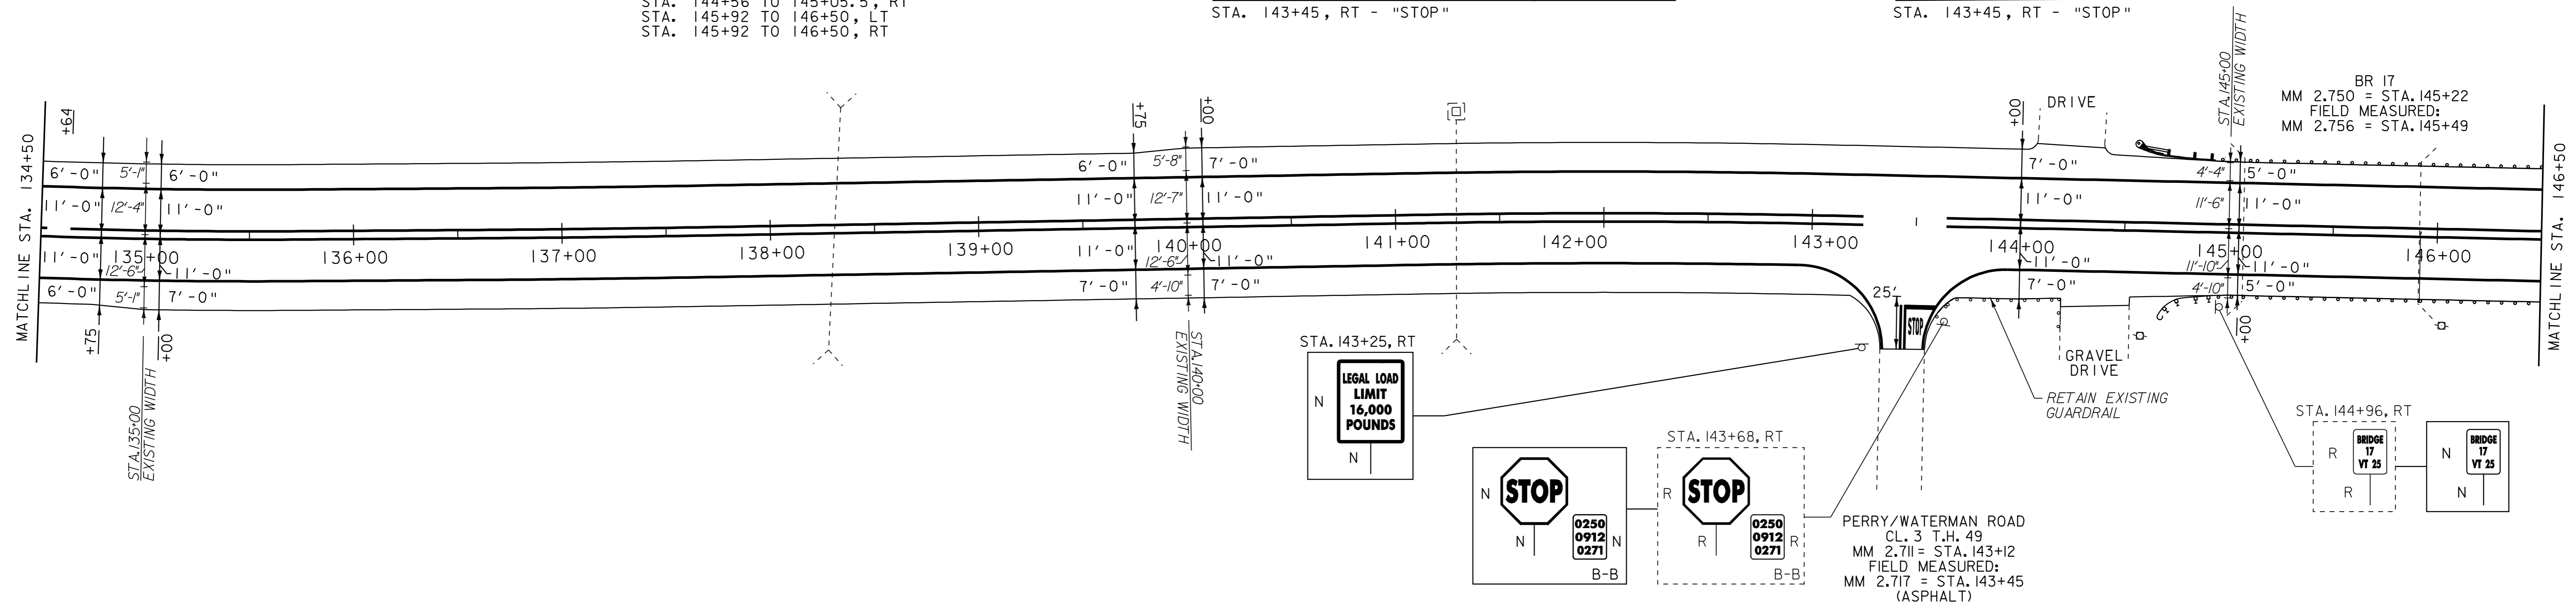

621.20 STEEL BEAM GUARDRAIL, GALVANIZED
 STA. 146+50 TO 146+92.5, LT 146+67.5
 STA. 146+50 TO 147+17.5, RT
 STA. 148+87.5 TO 154+12.5, LT

621.50 MANUFACTURED TERMINAL SECTION, FLARED
 STA. 146+92.5 TO 147+30, LT 147+05
 STA. 147+17.5 TO 147+55, RT
 STA. 148+50 TO 148+87.5, LT
 STA. 154+12.5 TO 154+50, LT

621.80 REMOVAL AND DISPOSAL OF GUARDRAIL
 STA. 146+50 TO 146+69, LT
 STA. 146+50 TO 146+69, RT

646.20
~~646.402 DURABLE 4 INCH WHITE LINE, THERMOPLASTIC~~
 STA. 146+50 TO 158+50, SOLID LT & RT
 646.21
~~646.412 DURABLE 4 INCH YELLOW LINE, THERMOPLASTIC~~
 STA. 146+50 TO 158+50, SOLID LT & RT

646.602 TEMPORARY 4 INCH WHITE LINE, PAINT
 STA. 146+50 TO 158+50, SOLID LT & RT

646.612 TEMPORARY 4 INCH YELLOW LINE, PAINT
 STA. 146+50 TO 158+50, SOLID LT & RT

675.50 REMOVING SIGNS
 AS SHOWN - 2

NOTES:
 1. ALL EXISTING SIGNS NOT SHOWN SHALL BE RETAINED.
 2. FOR LEGEND, SEE LAYOUT SHEET #1



NOT TO SCALE

PROJECT LAYOUT SHEET #25	PROJECT NAME: BRADFORD - ORANGE
	PROJECT NUMBER: S1P 2213(I)
	FILE NAME: p99b178.dgn
	PLOT DATE: 28-MAY-2010 13:4
DESIGNED BY: STANTEC	DRAWN BY: STANTEC
CHECKED BY: JLL	SHEET 42 OF 84