

621.20 STEEL BEAM GUARDRAIL, GALVANIZED
STA. 172+00 TO 176+00, RT

621.50 MANUFACTURED TERMINAL SECTION, FLARED
STA. 171+62.5 TO 172+00, RT
STA. 176+00 TO 176+37.5, RT

~~646.20~~
~~646.402 DURABLE 4 INCH WHITE LINE, THERMOPLASTIC~~
STA. 170+50 TO 182+50, SOLID LT & RT
STA. 173+03, DOUBLE SOLID LT (T.H. 48)

~~646.21~~
~~646.412 DURABLE 4 INCH YELLOW LINE, THERMOPLASTIC~~
STA. 170+50 TO 182+50, SOLID LT & RT
STA. 173+03, DOUBLE SOLID LT (T.H. 48)

~~646.26~~
~~646.482 DURABLE 24 INCH STOP BAR, THERMOPLASTIC~~
STA. 173+03, LT (T.H. 48)

646.492 DURABLE LETTER OR SYMBOL, THERMOPLASTIC
STA. 173+03, LT - "STOP"


646.602 TEMPORARY 4 INCH WHITE LINE, PAINT
STA. 170+50 TO 182+50, SOLID LT & RT
STA. 173+03, DOUBLE SOLID LT (T.H. 48)

646.612 TEMPORARY 4 INCH YELLOW LINE, PAINT
STA. 170+50 TO 182+50, SOLID LT & RT
STA. 173+03, DOUBLE SOLID LT (T.H. 48)

646.682 TEMPORARY 24 INCH STOP BAR, PAINT
STA. 173+03, LT (T.H. 48)

~~646.692 TEMPORARY LETTER OR SYMBOL, PAINT~~
~~STA. 173+03, LT - "STOP"~~

675.50 REMOVING SIGNS
AS SHOWN - 3

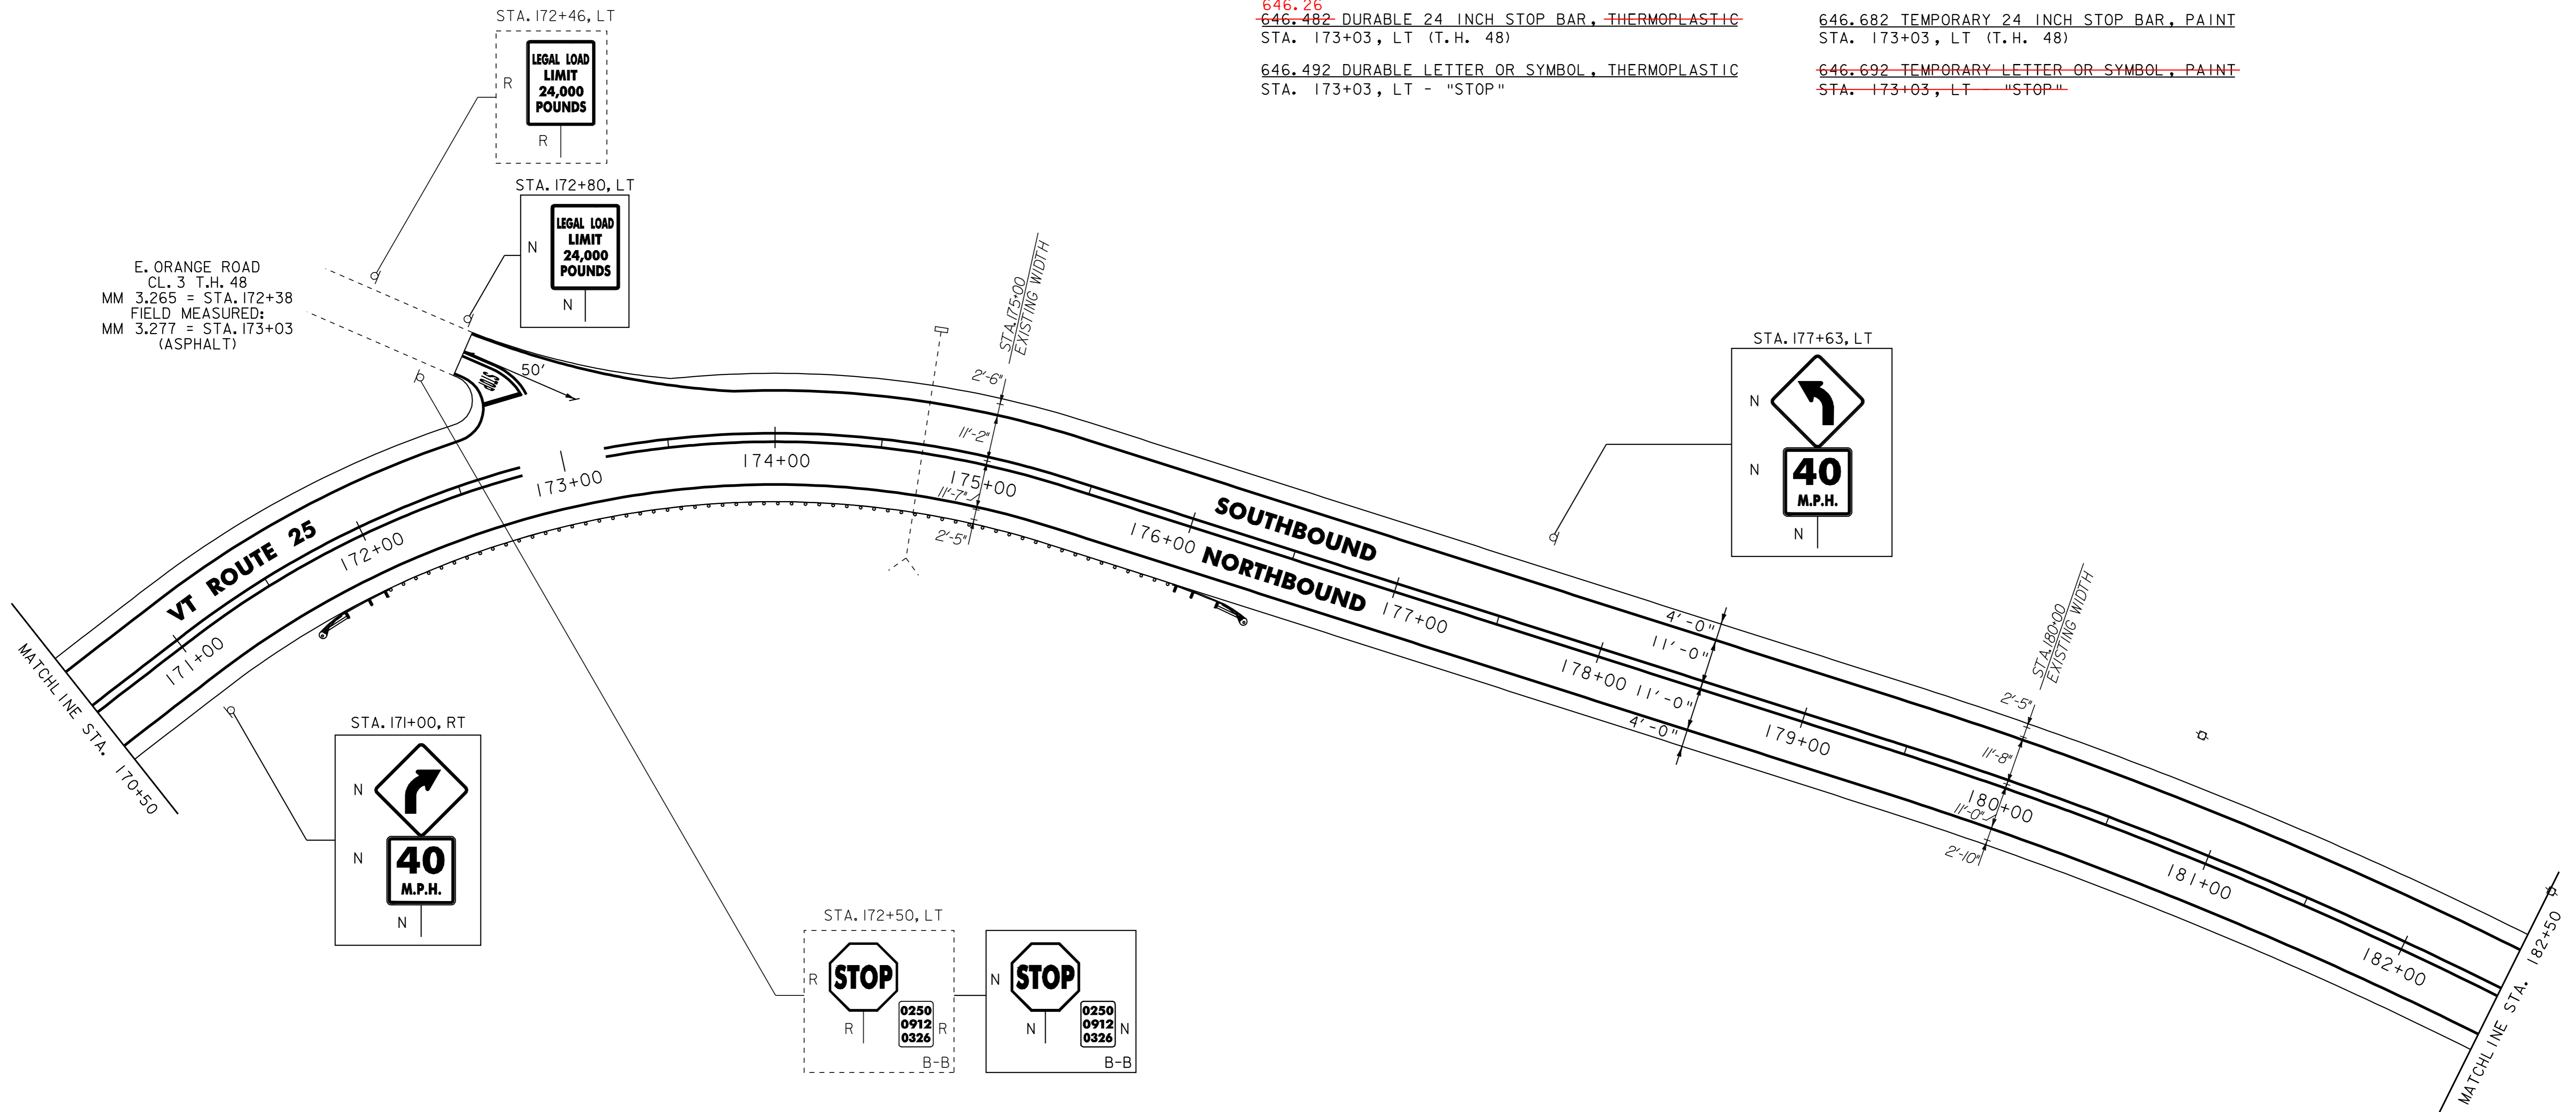

- NOTES:
1. ALL EXISTING SIGNS NOT SHOWN SHALL BE RETAINED.
 2. FOR LEGEND, SEE LAYOUT SHEET #1

NOT TO SCALE

PROJECT LAYOUT SHEET #27



PROJECT NAME: BRADFORD - ORANGE	FILE NAME: p99b178.dgn	PLOT DATE: 28-MAY-2010 13:4
PROJECT NUMBER: S1P 2213(I)	PROJECT LEADER: JLL	DRAWN BY: STANTEC
	DESIGNED BY: STANTEC	CHECKED BY: JLL
	IPARM FILE: p99b178i27.i	SHEET 44 OF 84