

621.20 STEEL BEAM GUARDRAIL GALVANIZED

STA. 183+12.5 TO 194+50, RT 187+89  
STA. 184+13.5 TO 187+88.5, LT  
STA. 188+14 TO 194+50 RT

621.50 MANUFACTURED TERMINAL SECTION, FLARED

STA. 182+75 TO 183+12.5, RT  
STA. 183+76 TO 184+13.5, LT  
STA. 187+88.5 TO 188+26, LT

621.60 ANCHOR

STA. 187+89 RT (DRIVE OPENING)  
STA. 188+14 RT (DRIVE OPENING)

646.20


646.402 DURABLE 4 INCH WHITE LINE, THERMOPLASTIC  
STA. 182+50 TO 194+50, SOLID LT & RT

646.21

646.412 DURABLE 4 INCH YELLOW LINE, THERMOPLASTIC  
STA. 182+50 TO 194+50, SOLID LT & RT

646.602 TEMPORARY 4 INCH WHITE LINE, PAINT  
STA. 182+50 TO 194+50, SOLID LT & RT

675.50 REMOVING SIGNS  
AS SHOWN - 5

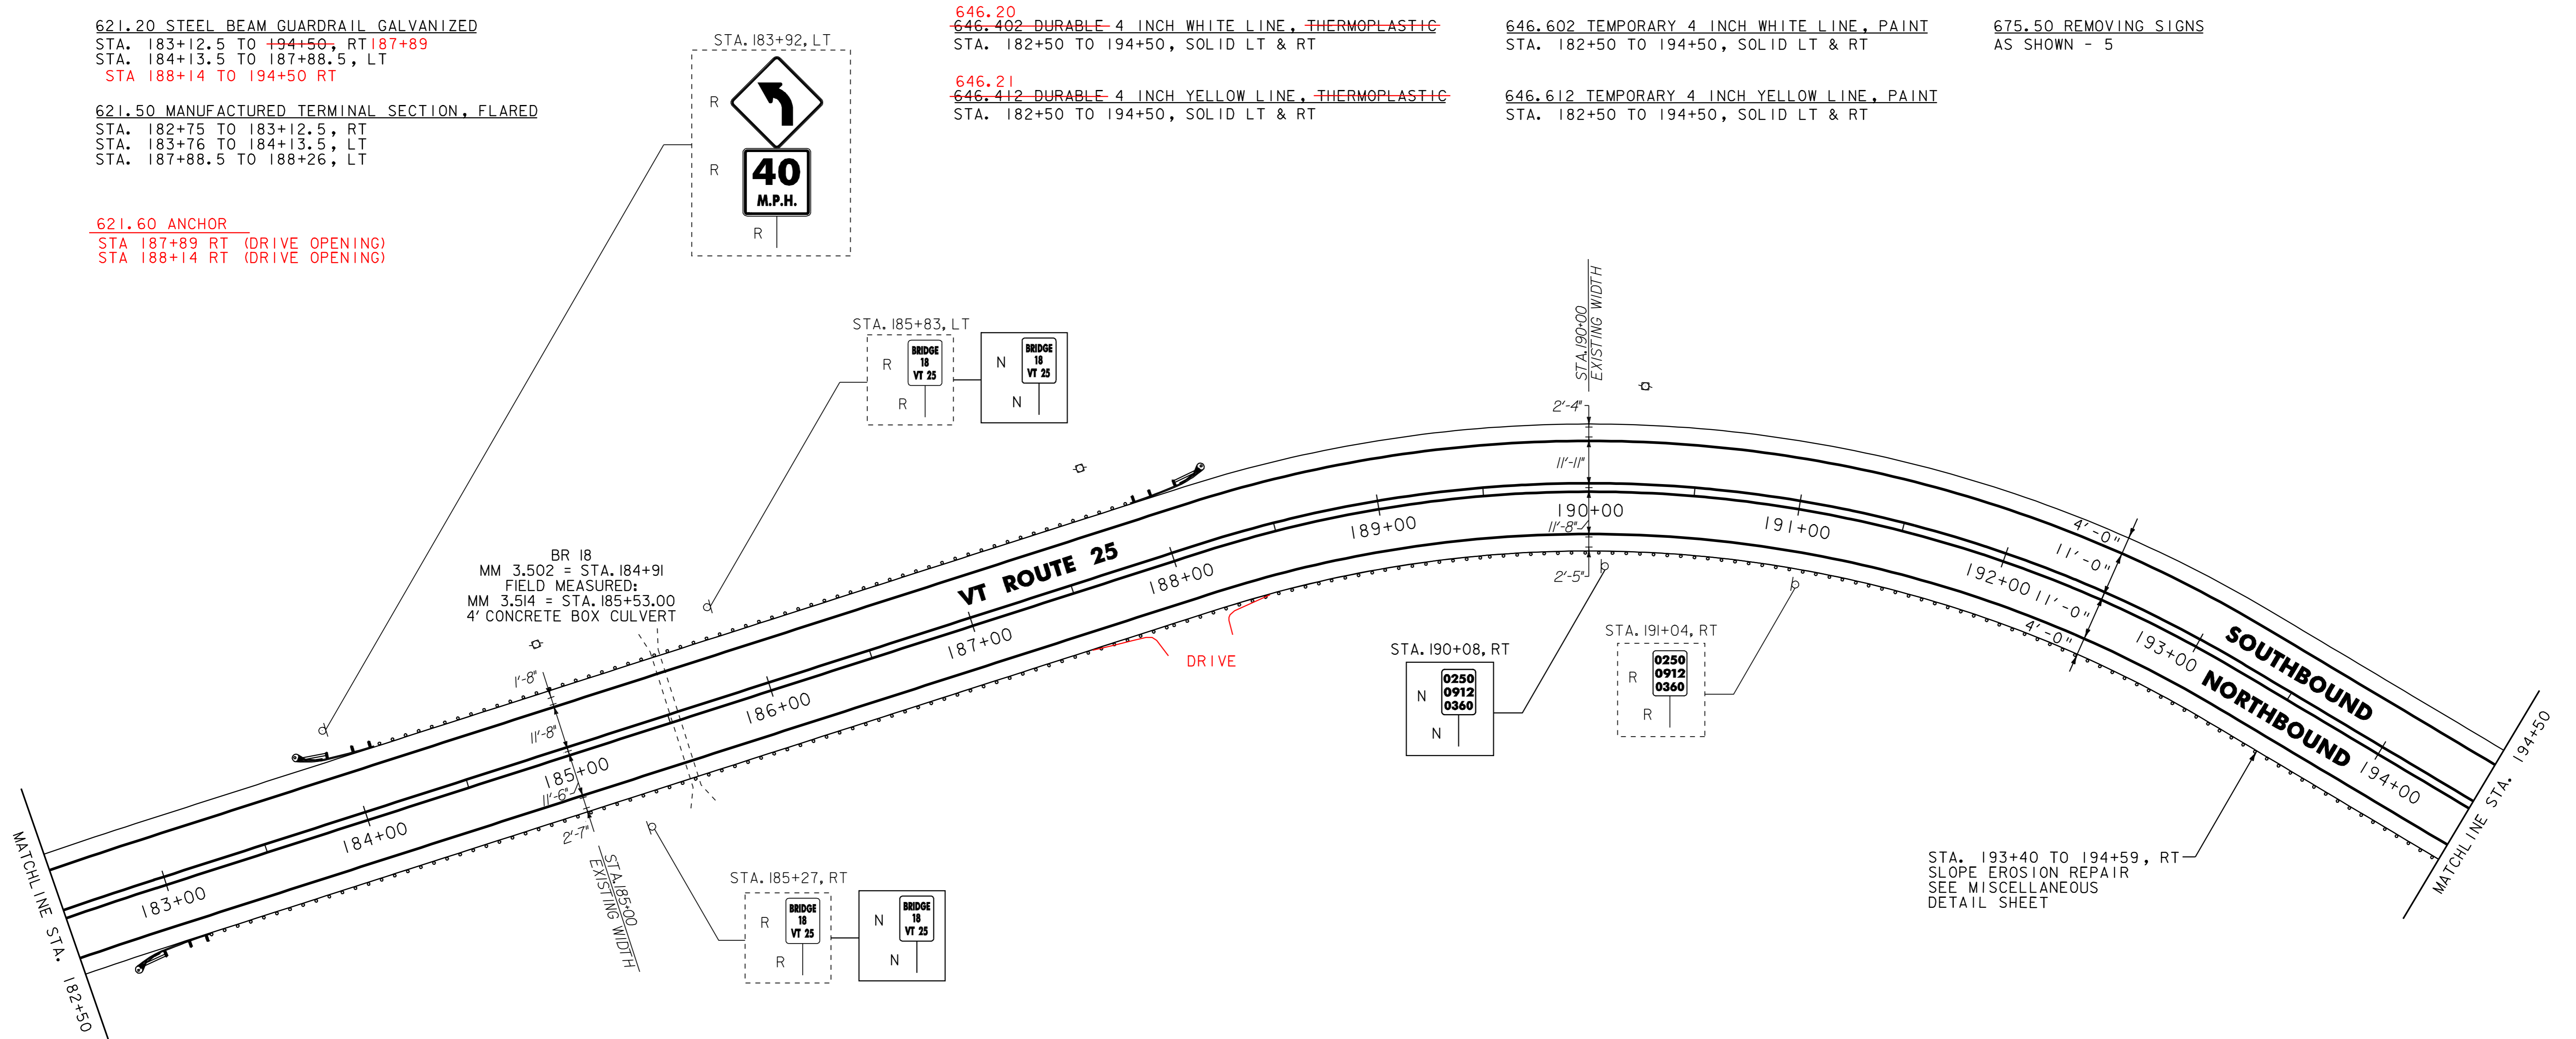

STA. 193+40 TO 194+59, RT  
SLOPE EROSION REPAIR  
SEE MISCELLANEOUS  
DETAIL SHEET

- NOTES:
1. ALL EXISTING SIGNS NOT SHOWN SHALL BE RETAINED.
  2. FOR LEGEND, SEE LAYOUT SHEET #1

NOT TO SCALE

**PROJECT LAYOUT SHEET #28**

PROJECT NAME: BRADFORD - ORANGE	FILE NAME: p99b178.dgn	PLOT DATE: 28-MAY-2010 13:4
PROJECT NUMBER: S1P 2213(I)	PROJECT LEADER: JLL	DRAWN BY: STANTEC
DESIGNED BY: STANTEC	CHECKED BY: JLL	SHEET 45 OF 84
IPARM FILE: p99b178128.i		

