

621.20 STEEL BEAM GUARDRAIL, GALVANIZED  
194+50 TO 196+50, RT


~~646.402 DURABLE 4 INCH WHITE LINE, THERMOPLASTIC~~  
646.20  
STA. 194+50 TO 206+50, SOLID LT & RT

646.602 TEMPORARY 4 INCH WHITE LINE, PAINT  
STA. 194+50 TO 206+50, SOLID LT & RT

621.50 MANUFACTURED TERMINAL SECTION, FLARED  
196+50 TO 196+87.5, RT

~~646.412 DURABLE 4 INCH YELLOW LINE, THERMOPLASTIC~~  
646.21  
STA. 194+50 TO 206+50, SOLID LT & RT

646.612 TEMPORARY 4 INCH YELLOW LINE, PAINT  
STA. 194+50 TO 206+50, SOLID LT & RT

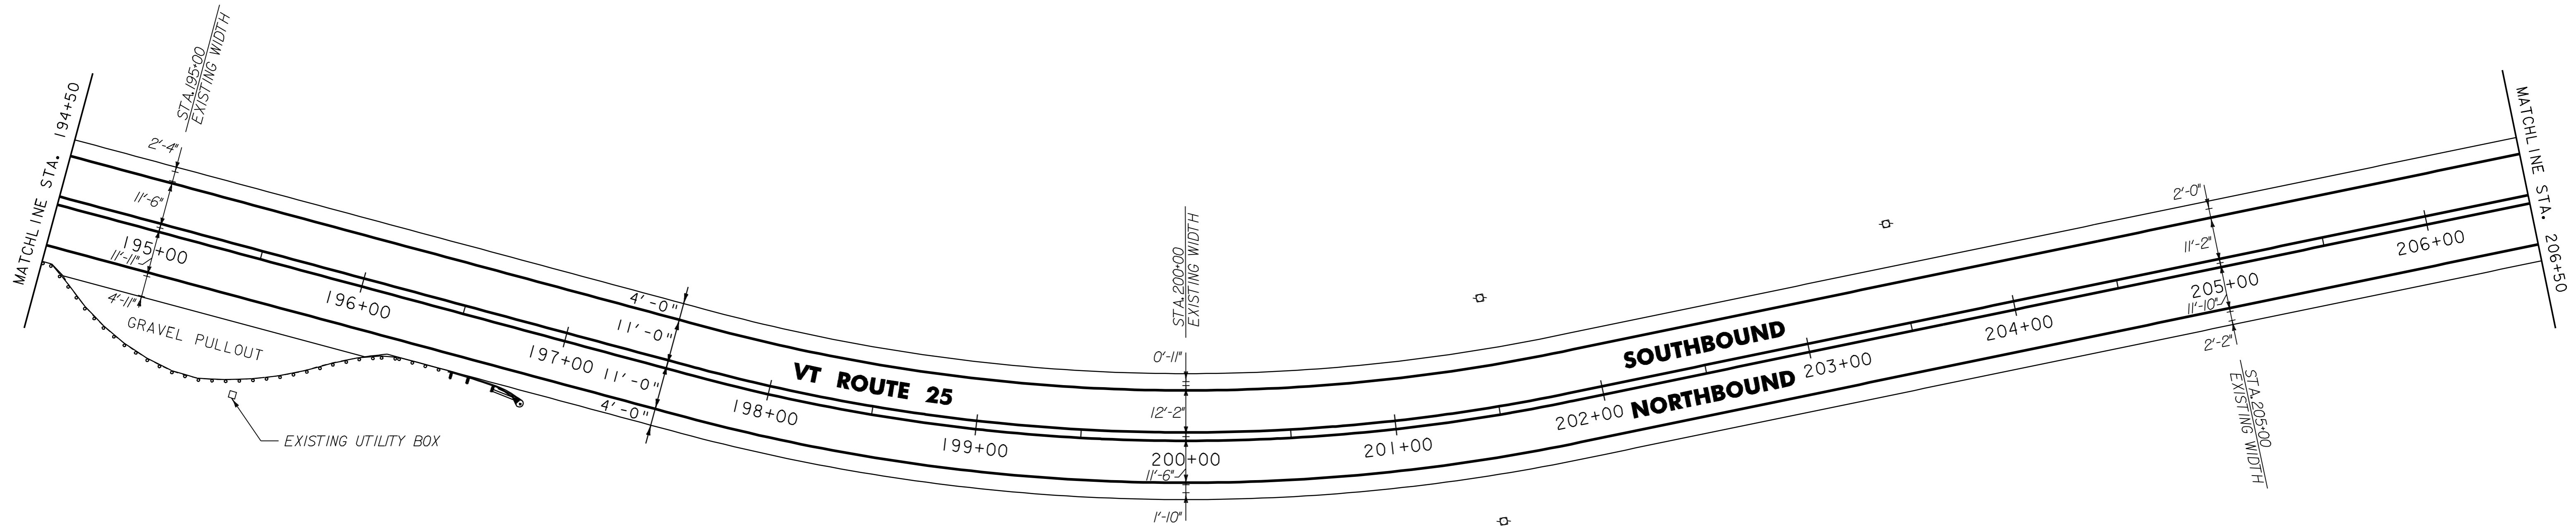

- NOTES:
1. ALL EXISTING SIGNS NOT SHOWN SHALL BE RETAINED.
  2. FOR LEGEND, SEE LAYOUT SHEET #1

NOT TO SCALE

**PROJECT LAYOUT SHEET #29**



PROJECT NAME: BRADFORD - ORANGE	FILE NAME: p99b178.dgn	PLOT DATE: 28-MAY-2010 13:4
PROJECT NUMBER: STP 2213(I)	PROJECT LEADER: JLL	DRAWN BY: STANTEC
	DESIGNED BY: STANTEC	CHECKED BY: JLL
	IPARM FILE: p99b178129.i	SHEET 46 OF 84