

525.60 BRIDGE RAILING REPAIR, TYPE III
 STA. 234+42.5 TO 234+67.5, RT
 STA. 234+62.5 TO 234+87.5, LT

604.412, 604.415, OR 604.418 REHAB.
 D.I.'S, CB'S OR MH'S, CLASS I, II OR III
 STA. 236+34, RT

616.47 BITUMINOUS CONCRETE GUTTERS AND TRAFFIC ISLANDS
 STA. 240+70 TO 240+86, LT
 STA. 242+11 TO 243+00, RT

~~617.10 RELOCATE MAILBOX, SINGLE SUPPORT~~
~~STA. 235+55, RT~~

621.20 STEEL BEAM GUARDRAIL, GALVANIZED
 STA. 233+31.25 TO 234+31.25, LT
 STA. 233+61.25 TO 234+11.25, RT
 STA. 235+12.5 TO 236+07.5, LT

621.205 STEEL BEAM GUARDRAIL, GALVANIZED W/8 FEET POSTS
 STA. 231+36.25 TP 233+61.25, RT

621.21 HD STEEL BEAM GUARDRAIL, GALVANIZED
 STA. 234+11.25 TO 234+42.5, RT
 STA. 234+31.25 TO 234+62.5, LT
 STA. 234+67.5 TO 234+92.5, RT
 STA. 234+87.5 TO 235+12.5, LT

621.50 MANUFACTURED TERMINAL SECTION, FLARED
 STA. 230+98.75 TO 231+36.25, RT
 STA. 232+93.75 TO 233+31.25, LT NO MTS
 STA. 234+92.5 TO 235+30, RT NO MTS
 STA. 237+12.5 TO 237+50, LT
 235+96.5 TO 236+34

621.80 REMOVAL AND DISPOSAL OF GUARDRAIL
 STA. 230+99 TO 235+13, RT
 STA. 234+27 TO 235+52, LT

646.20
~~646.402 DURABLE 4 INCH WHITE LINE, THERMOPLASTIC~~
 STA. 230+50 TO 243+00, SOLID LT & RT

646.21
~~646.412 DURABLE 4 INCH YELLOW LINE, THERMOPLASTIC~~
 STA. 230+50 TO 243+00, SOLID LT & RT


646.602 TEMPORARY 4 INCH WHITE LINE, PAINT
 STA. 230+50 TO 243+00, SOLID LT & RT

646.612 TEMPORARY 4 INCH YELLOW LINE, PAINT
 STA. 230+50 TO 243+00, SOLID LT & RT

675.50 REMOVING SIGNS
 AS SHOWN - 5

675.60 ERECTING SALVAGED SIGNS
 AS SHOWN - 1

621.60 ANCHOR
 234+92 RT
 234+28 LT

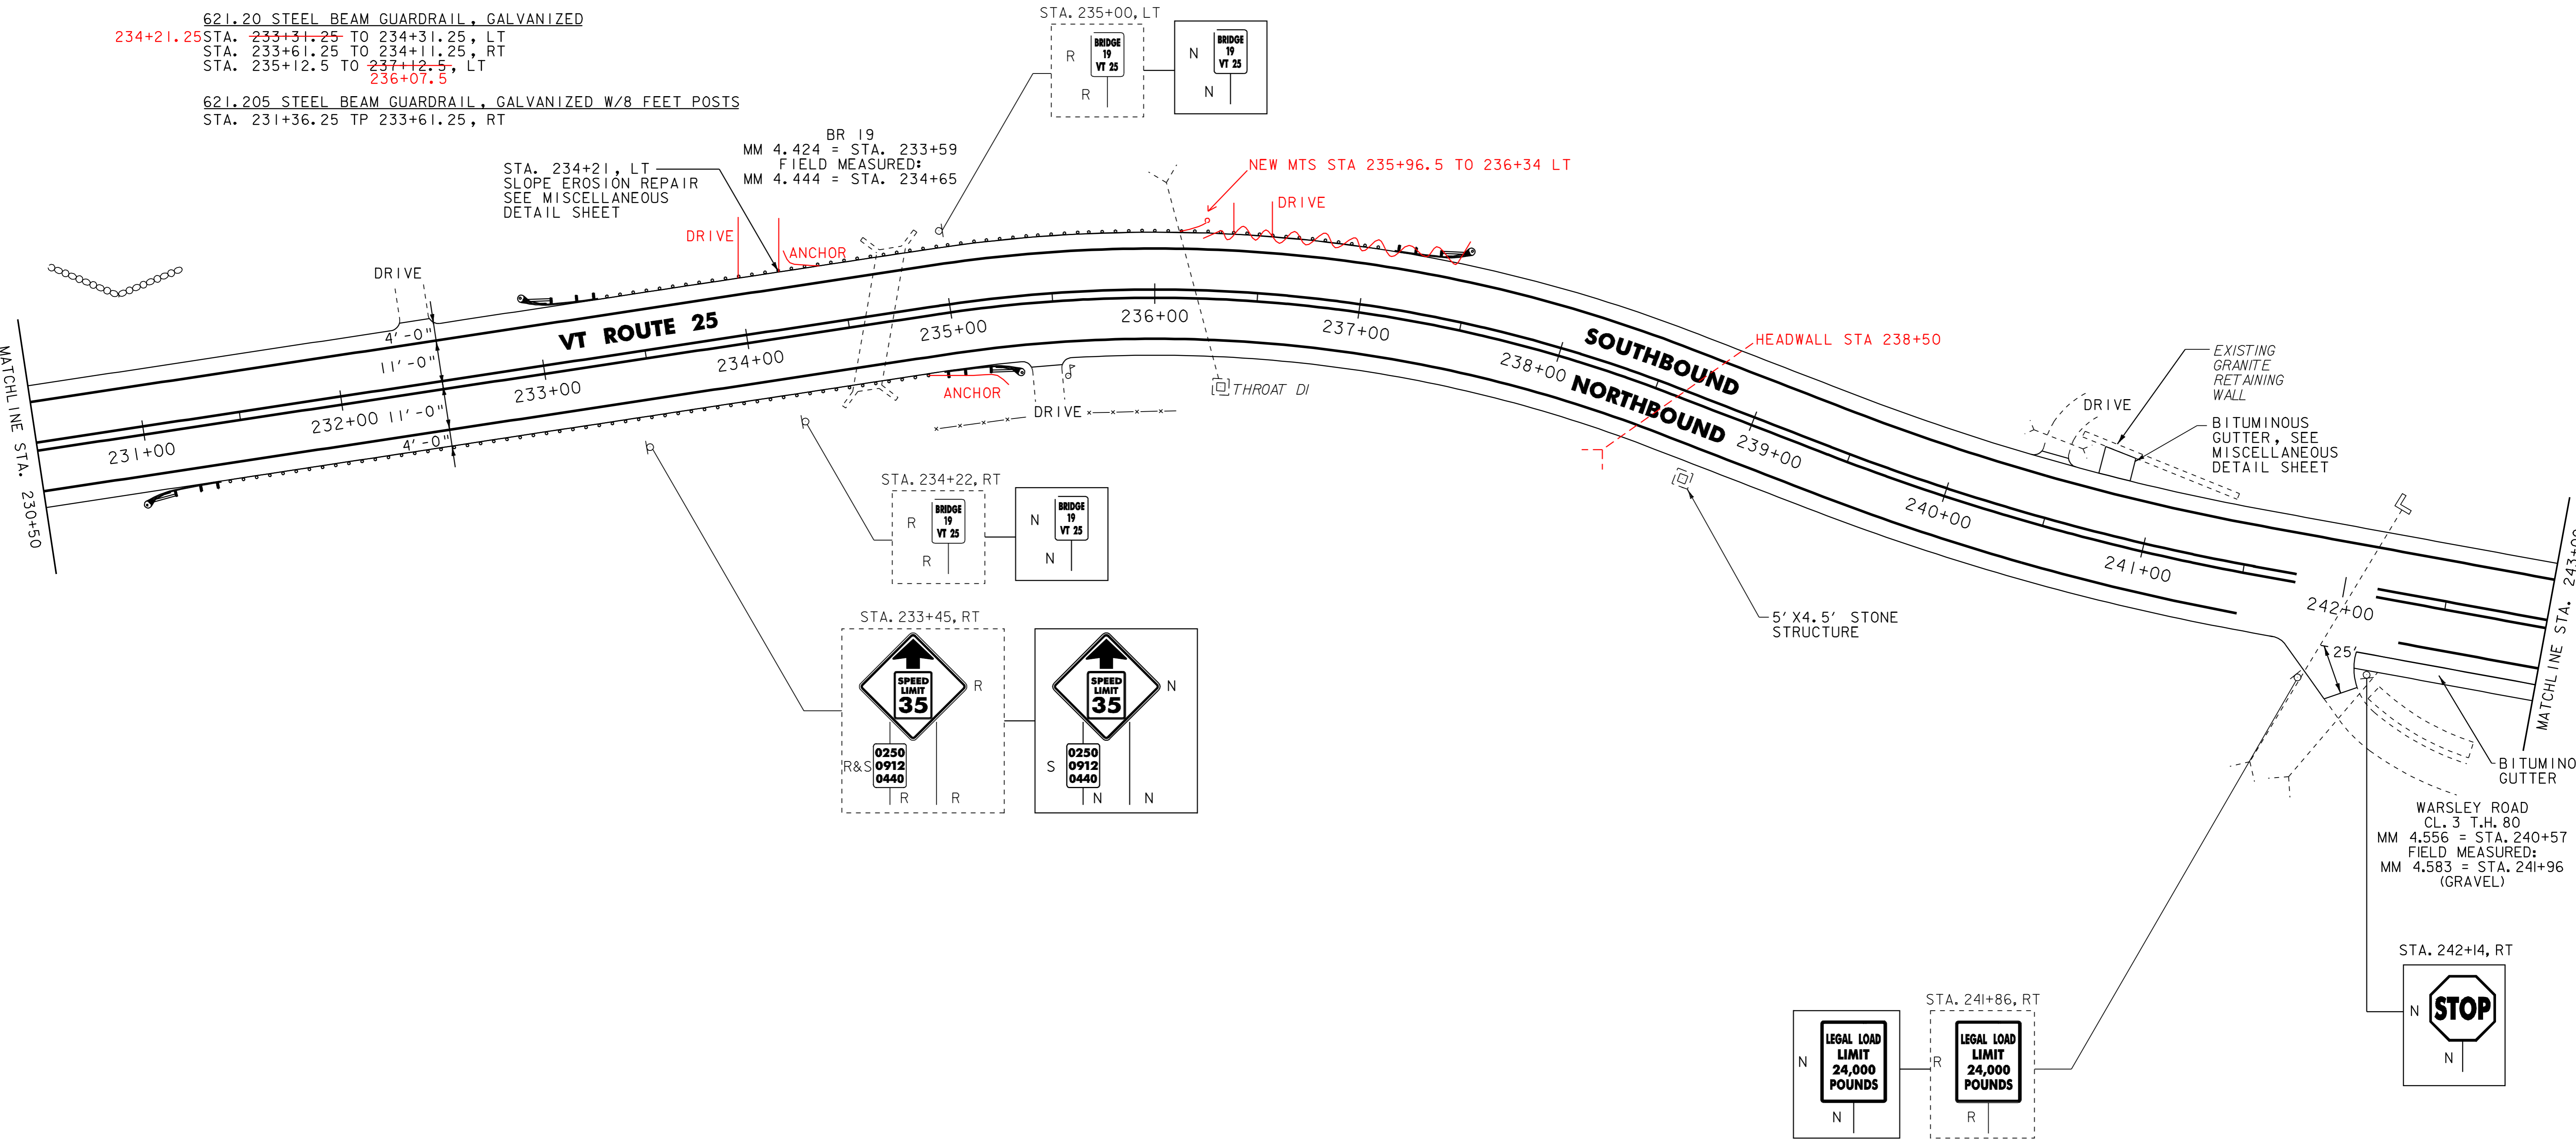

- NOTES:
1. ALL EXISTING SIGNS NOT SHOWN SHALL BE RETAINED.
 2. FOR LEGEND, SEE LAYOUT SHEET #1

NOT TO SCALE

PROJECT LAYOUT SHEET #31

PROJECT NAME: BRADFORD - ORANGE
 PROJECT NUMBER: STP 2213(I)

FILE NAME: p99b178.dgn PLOT DATE: 28-MAY-2010 13:4
 PROJECT LEADER: JLL DRAWN BY: STANTEC
 DESIGNED BY: STANTEC CHECKED BY: JLL
 IPARM FILE: p99b178131.i SHEET 48 OF 84

