

616.47 BITUMINOUS CONCRETE GUTTERS AND TRAFFIC ISLANDS
STA. 243+00 TO 245+86, RT


646.602 TEMPORARY 4 INCH WHITE LINE, PAINT
STA. 243+00 TO 255+50, SOLID LT & RT

675.50 REMOVING SIGNS
AS SHOWN - 6

~~646.20~~
~~646.402 DURABLE 4 INCH WHITE LINE, THERMOPLASTIC~~
STA. 243+00 TO 255+50, SOLID LT & RT

646.612 TEMPORARY 4 INCH YELLOW LINE, PAINT
STA. 243+00 TO 255+50, SOLID LT & RT

~~646.21~~
~~646.412 DURABLE 4 INCH YELLOW LINE, THERMOPLASTIC~~
STA. 243+00 TO 255+50, SOLID LT & RT

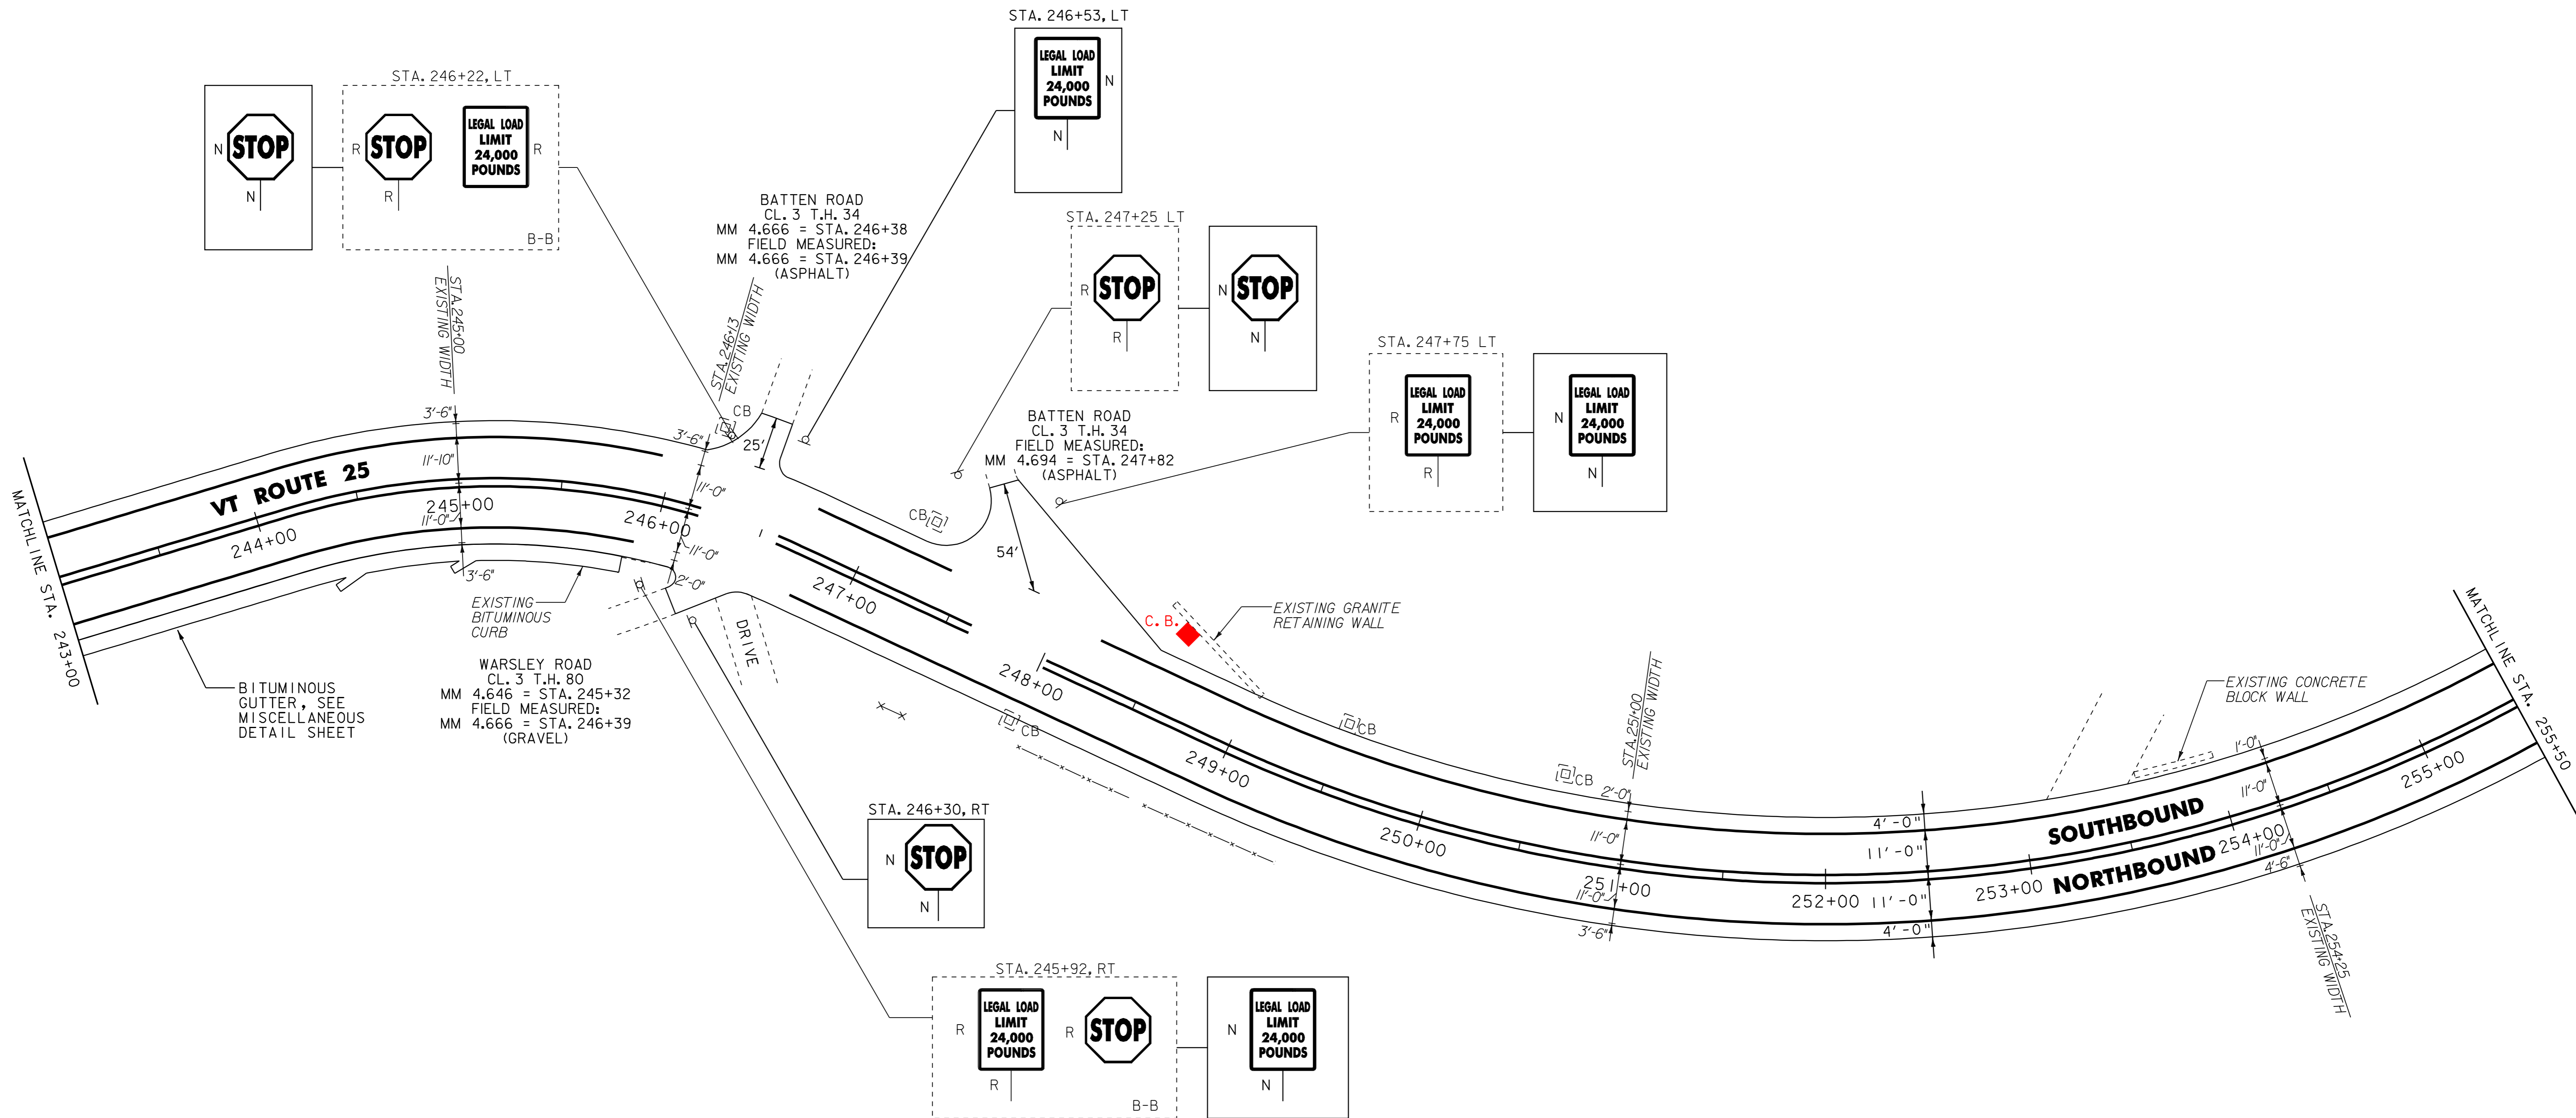

- NOTES:
1. ALL EXISTING SIGNS NOT SHOWN SHALL BE RETAINED.
 2. FOR LEGEND, SEE LAYOUT SHEET #1

<p>NOT TO SCALE</p> <p>PROJECT LAYOUT SHEET #32</p>	PROJECT NAME: BRADFORD - ORANGE
	PROJECT NUMBER: STP 2213(I)
	FILE NAME: p99b178.dgn
	PLOT DATE: 28-MAY-2010 13:4
DESIGNED BY: STANTEC	DRAWN BY: STANTEC
CHECKED BY: JLL	
IPARM FILE: p99b178i32.i	SHEET 49 OF 84

