

604.412, 604.415, OR 604.418 REHAB.  
 D.I.'S, C.B.'S OR M.H.'S, CLASS I, II OR III  
 STA. 265+88, LT

616.47 BITUMINOUS CONCRETE GUTTERS AND TRAFFIC ISLANDS  
 STA. 259+88 TO 261+96, RT

621.20 STEEL BEAM GUARDRAIL, GALVANIZED — NO SBGR  
 STA. 261+02.5 TO 261+15, RT

621.50 MANUFACTURED TERMINAL SECTION, FLARED  
~~STA. 260+65 TO 261+02.5, RT~~ STA 260+71.5 TO 261+09 RT  
 STA 262+87.5 TO 263+25 RT

621.51 MANUFACTURED TERMINAL SECTION, TANGENT  
~~STA. 261+15 TO 261+65, RT~~ STA 261+09 TO 261+59 RT

621.80 REMOVAL AND DISPOSAL OF GUARDRAIL  
 STA. 260+73 TO 261+64, RT  
 STA 263+25 TO 262+87.5 RT


646.20  
~~646.402 DURABLE 4 INCH WHITE LINE, THERMOPLASTIC~~  
 STA. 255+50 TO 267+50, SOLID LT & RT

646.21  
~~646.412 DURABLE 4 INCH YELLOW LINE, THERMOPLASTIC~~  
 STA. 255+50 TO 267+50, SOLID LT & RT

646.602 TEMPORARY 4 INCH WHITE LINE, PAINT  
 STA. 255+50 TO 267+50, SOLID LT & RT

646.612 TEMPORARY 4 INCH YELLOW LINE, PAINT  
 STA. 255+50 TO 267+50, SOLID LT & RT

604.412, 604.415, OR 604.418  
 STA 261+44 LT

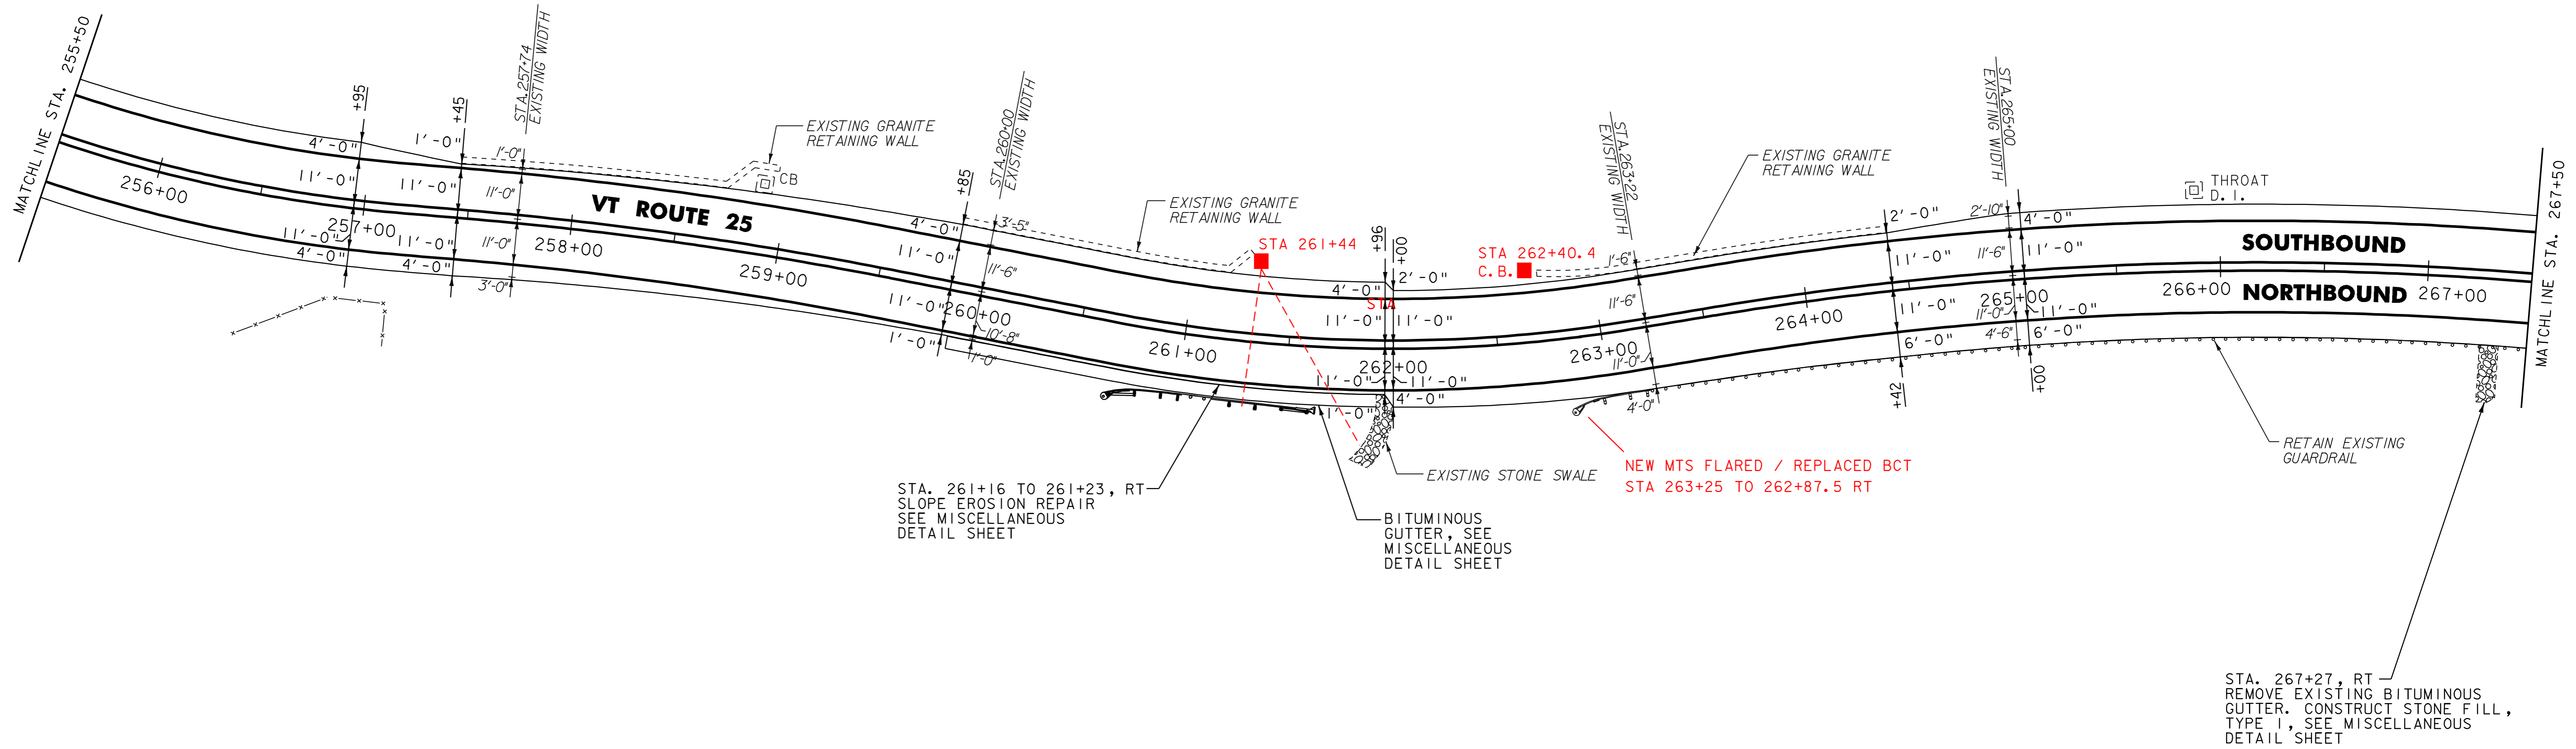

STA. 261+16 TO 261+23, RT  
 SLOPE EROSION REPAIR  
 SEE MISCELLANEOUS  
 DETAIL SHEET

BITUMINOUS  
 GUTTER, SEE  
 MISCELLANEOUS  
 DETAIL SHEET

NEW MTS FLARED / REPLACED BCT  
 STA 263+25 TO 262+87.5 RT

STA. 267+27, RT  
 REMOVE EXISTING BITUMINOUS  
 GUTTER. CONSTRUCT STONE FILL,  
 TYPE I, SEE MISCELLANEOUS  
 DETAIL SHEET

- NOTES:
1. ALL EXISTING SIGNS NOT SHOWN SHALL BE RETAINED.
  2. FOR LEGEND, SEE LAYOUT SHEET #1

NOT TO SCALE

**PROJECT  
 LAYOUT  
 SHEET #33**



PROJECT NAME: BRADFORD - ORANGE	FILE NAME: p99b178.dgn	PLOT DATE: 28-MAY-2010 13:4
PROJECT NUMBER: S1P_2213(I)	PROJECT LEADER: JLL	DRAWN BY: STANTEC
	DESIGNED BY: STANTEC	CHECKED BY: JLL
	IPARM FILE: p99b178i33.i	SHEET 50 OF 84