

604.412, 604.415, OR 604.418 REHAB.  
 DI'S, CB'S OR MH'S, CLASS I, ~~OR~~  
 STA. 281+25, RT

621.20 STEEL BEAM GUARDRAIL, GALVANIZED  
 STA. ~~281+83~~ TO 292+00, LT  
 280+00

621.205 STEEL BEAM GUARDRAIL, GALVANIZED W/8 FEET POSTS  
 STA. ~~280+00 TO 281+83~~, LT

621.80 REMOVAL AND DISPOSAL OF GUARDRAIL  
 STA. 280+00 TO 292+00, LT

646.20  
~~646.402 DURABLE 4 INCH WHITE LINE, THERMOPLASTIC~~  
 STA. 280+00 TO 292+00, SOLID LT & RT  
 STA. 291+19, DOUBLE SOLID RT (T.H. 25)

646.21  
~~646.412 DURABLE 4 INCH YELLOW LINE, THERMOPLASTIC~~  
 STA. 280+00 TO 292+00, SOLID LT & RT  
 STA. 291+19, DOUBLE SOLID RT (T.H. 25)

646.26  
~~646.482 DURABLE 24 INCH STOP BAR, THERMOPLASTIC~~  
 STA. 291+19, RT (T.H. 25)

646.492 DURABLE LETTER OR SYMBOL, THERMOPLASTIC  
 STA. 291+19, RT - "STOP"

646.602 TEMPORARY 4 INCH WHITE LINE, PAINT  
 STA. 280+00 TO 292+00, SOLID LT & RT  
 STA. 291+19, DOUBLE SOLID RT (T.H. 25)


646.612 TEMPORARY 4 INCH YELLOW LINE, PAINT  
 STA. 280+00 TO 292+00, SOLID LT & RT  
 STA. 291+19, DOUBLE SOLID RT (T.H. 25)

646.682 TEMPORARY 24 INCH STOP BAR, PAINT  
 STA. 291+19, RT (T.H. 25)

646.692 TEMPORARY LETTER OR SYMBOL, PAINT  
 STA. 291+19, RT - "STOP"

675.50 REMOVING SIGNS  
 AS SHOWN - 4

675.60 ERECTING SALVAGED SIGNS  
 AS SHOWN - 1

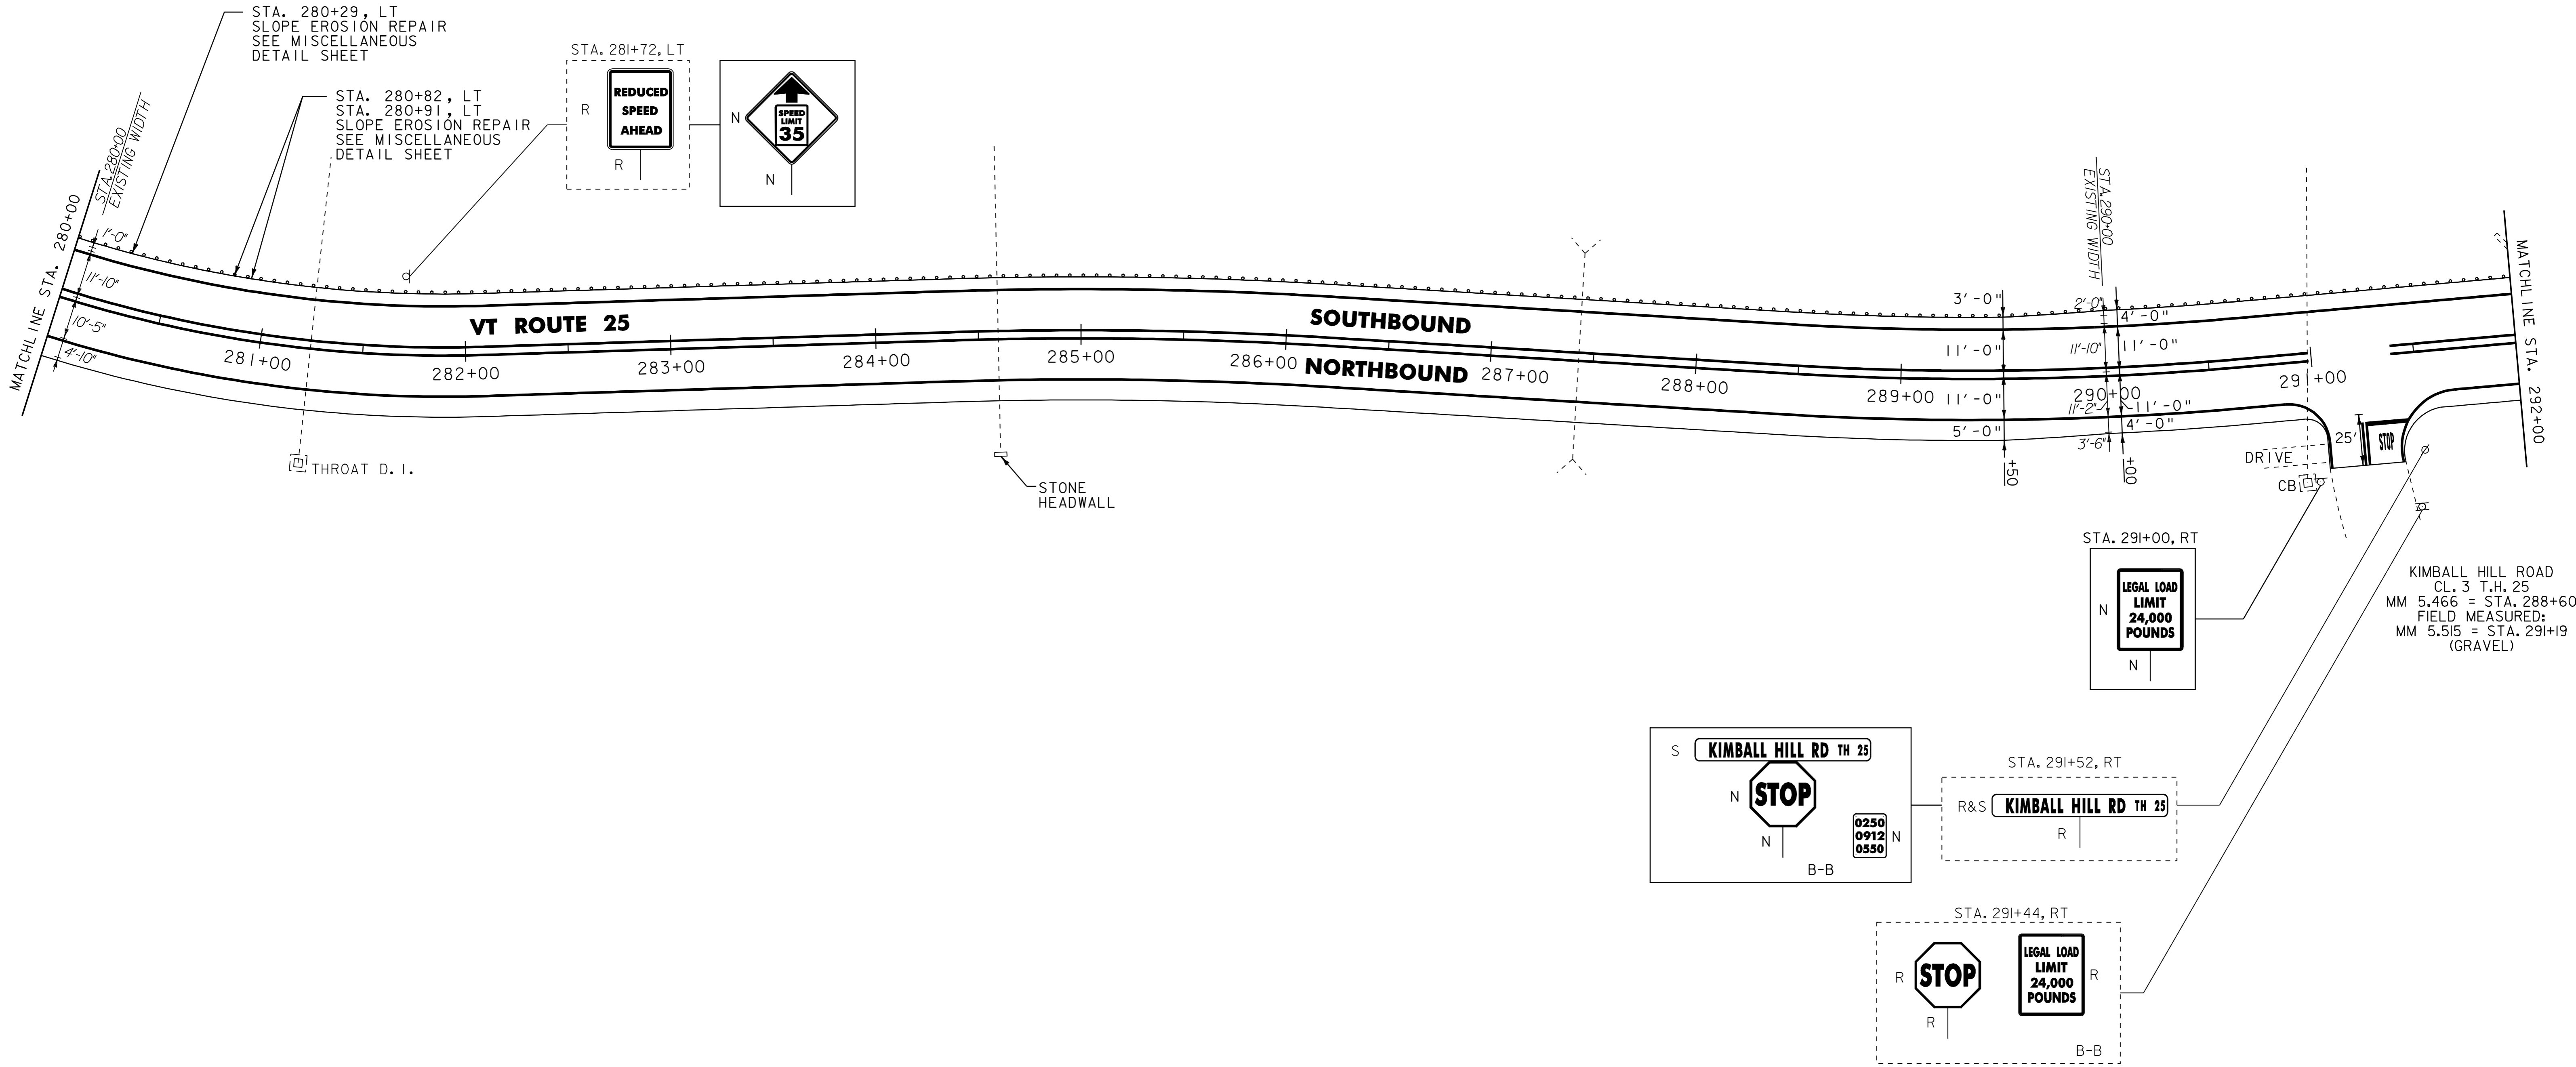

- NOTES:
1. ALL EXISTING SIGNS NOT SHOWN SHALL BE RETAINED.
  2. FOR LEGEND, SEE LAYOUT SHEET #1

NOT TO SCALE

**PROJECT LAYOUT SHEET #35**



PROJECT NAME: BRADFORD - ORANGE	FILE NAME: p99b178.dgn	PLOT DATE: 28-MAY-2010 13:4
PROJECT NUMBER: STP 2213(I)	PROJECT LEADER: JLL	DRAWN BY: STANTEC
DESIGNED BY: STANTEC	CHECKED BY: JLL	SHEET 52 OF 84
IPARM FILE: p99b178i35.i		