

525.60 BRIDGE RAILING REPAIR, TYPE III  
 STA. 300+77 TO 301+27, LT  
 STA. 301+06 TO 301+56, RT

604.412, 604.415, OR 604.418 REHAB.  
 DI'S, CB'S OR MH'S, CLASS I, ~~++~~ OR ~~+++~~  
 STA. 293+55, RT  
 STA. 298+50, RT

616.35 TREATED TIMBER CURB  
~~STA. 300+30 TO 303+00, RT~~

621.20 STEEL BEAM GUARDRAIL, GALVANIZED  
 STA. 292+00 TO 294+16.13, LT  
~~STA. 298+64.5 TO 300+52, LT~~  
 STA. 300+14 TO 300+81, RT  
 STA. 301+52 TO 302+03, LT  
 STA. 301+81 TO 303+50, RT

621.21 HD STEEL BEAM GUARDRAIL, GALVANIZED  
 STA. 300+52 TO 300+77, LT  
 STA. 300+81 TO 301+06, RT  
 STA. 301+27 TO 301+52, LT  
 STA. 301+56 TO 301+81, RT

621.50 MANUFACTURED TERMINAL SECTION, FLARED  
 STA. 294+16.13 TO 294+53.63, LT  
 STA. 298+27 TO 298+64.5, LT

621.60 ANCHOR FOR STEEL BEAM RAIL  
~~STA. 300+14, RT 300+04~~  
~~STA. 302+03, LT 302+16.5~~

621.80 REMOVAL AND DISPOSAL OF GUARDRAIL  
 STA. 292+00 TO 294+58, LT  
 STA. 298+25 TO 301+91, LT  
 STA. 300+15 TO 303+50, RT

STA 300+87.5 TO 300+00 RT  
 STA 301+50 TO 301+75 RT

646.20  
~~646.402 DURABLE 4 INCH WHITE LINE, THERMOPLASTIC~~  
 STA. 292+00 TO 303+50, SOLID LT & RT  
 STA. 299+52, DOUBLE SOLID RT (T.H. 24)

646.21  
~~646.412 DURABLE 4 INCH YELLOW LINE, THERMOPLASTIC~~  
 STA. 292+00 TO 303+50, SOLID LT & RT  
 STA. 299+52, DOUBLE SOLID RT (T.H. 24)

646.26  
~~646.482 DURABLE 24 INCH STOP BAR, THERMOPLASTIC~~  
 STA. 299+52, RT (T.H. 24)

646.492 DURABLE LETTER OR SYMBOL, THERMOPLASTIC  
 STA. 299+52, RT - "STOP"

646.602 TEMPORARY 4 INCH WHITE LINE, PAINT  
 STA. 292+00 TO 303+50, SOLID LT & RT  
 STA. 299+52, DOUBLE SOLID RT (T.H. 24)



646.612 TEMPORARY 4 INCH YELLOW LINE, PAINT  
 STA. 292+00 TO 303+50, SOLID LT & RT  
 STA. 299+52, DOUBLE SOLID RT (T.H. 24)

646.682 TEMPORARY 24 INCH STOP BAR, PAINT  
 STA. 299+52, RT (T.H. 24)

~~646.692 TEMPORARY LETTER OR SYMBOL, PAINT~~  
~~STA. 299+52, RT - "STOP"~~

675.50 REMOVING SIGNS  
 AS SHOWN - 6

621.205 STEEL BEAM GUARDRAIL, GALVANIZED W/ 8' POSTS  
 STA 298+64 TO 300+52 LT

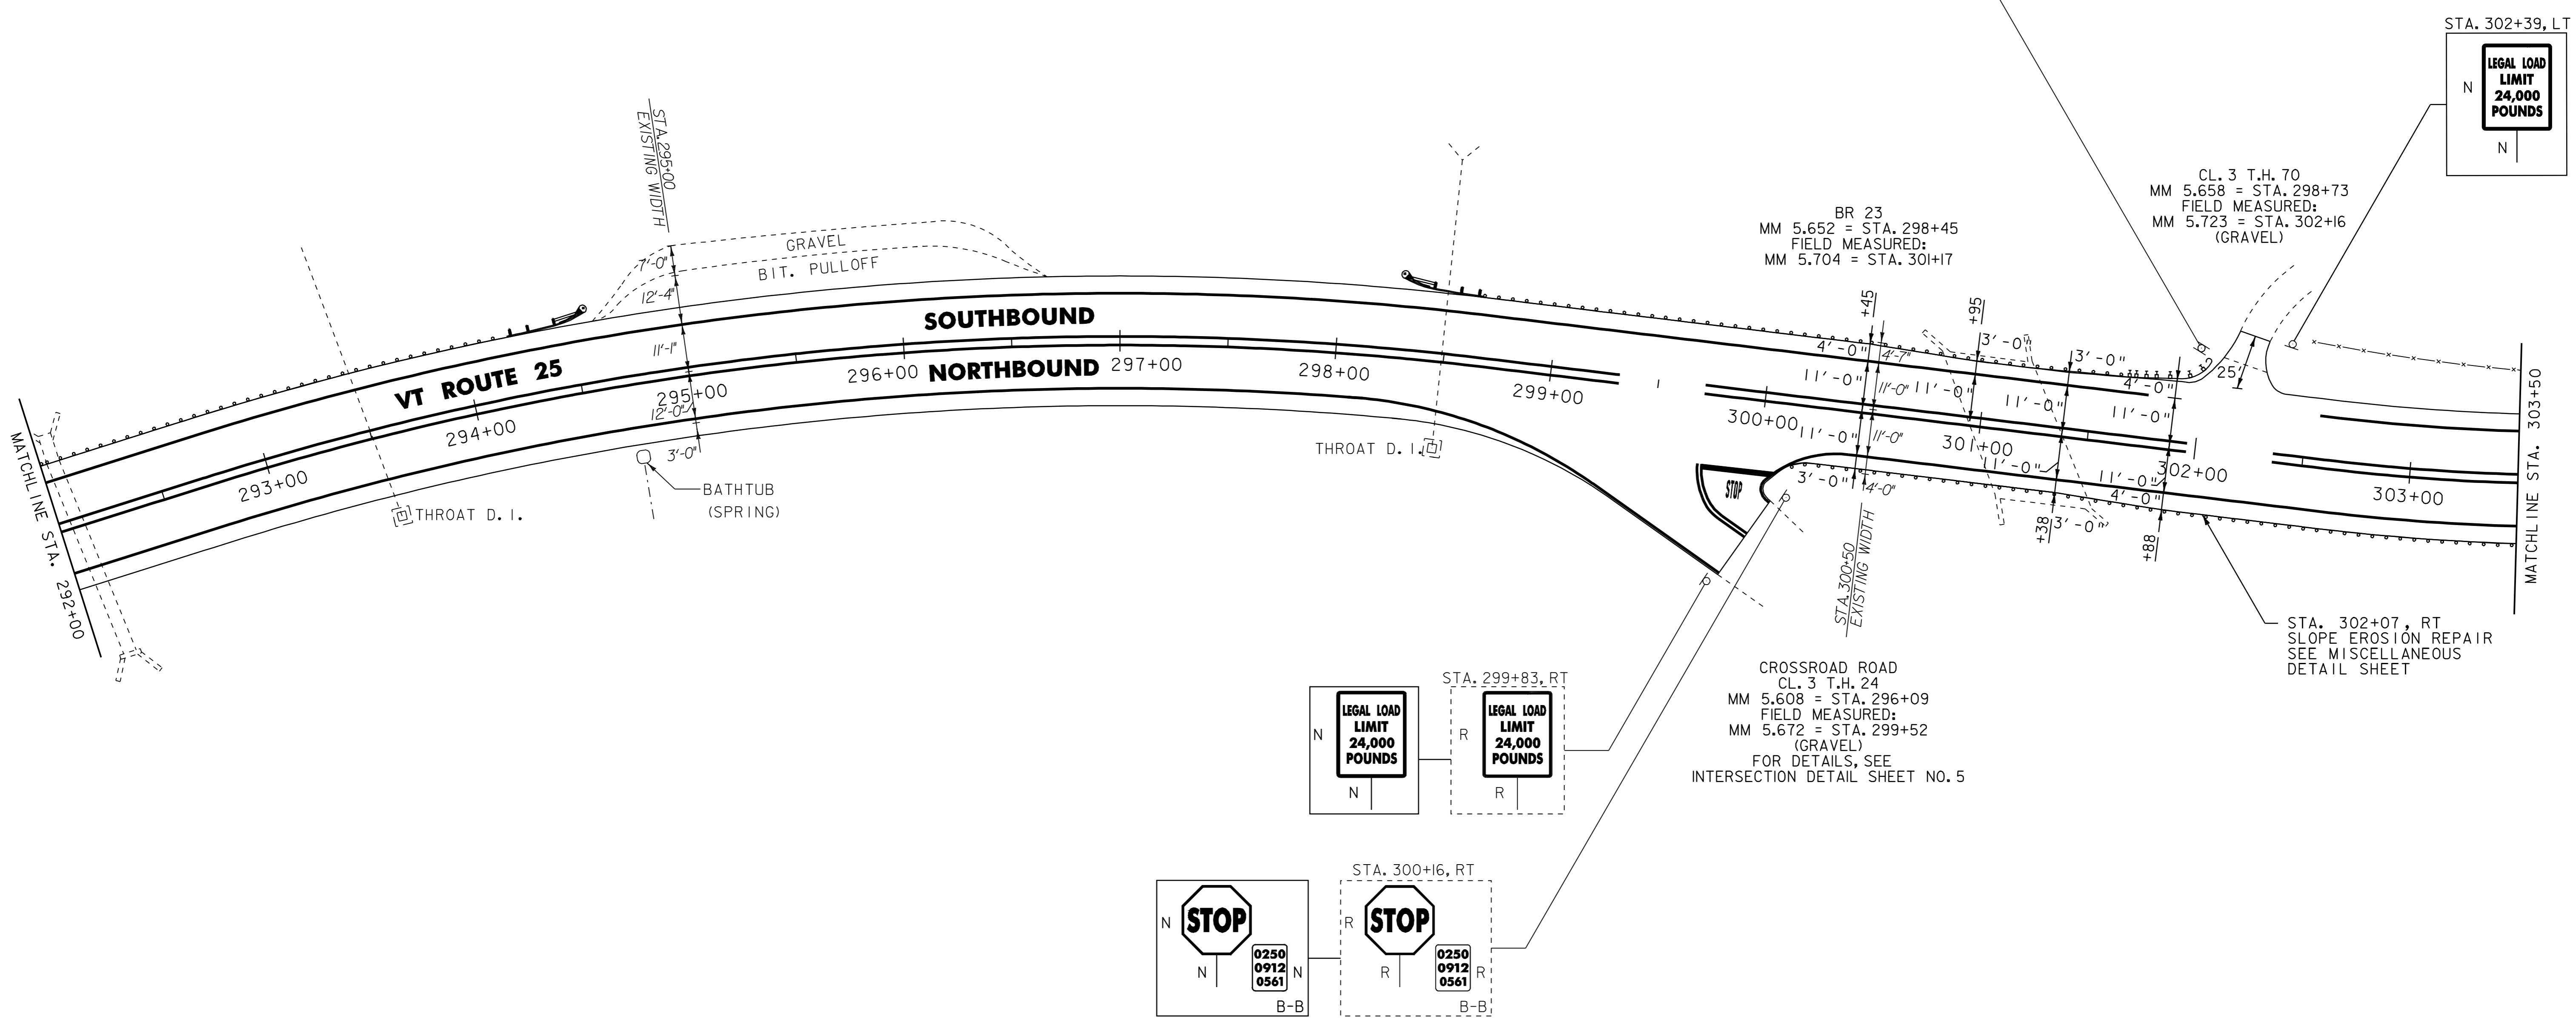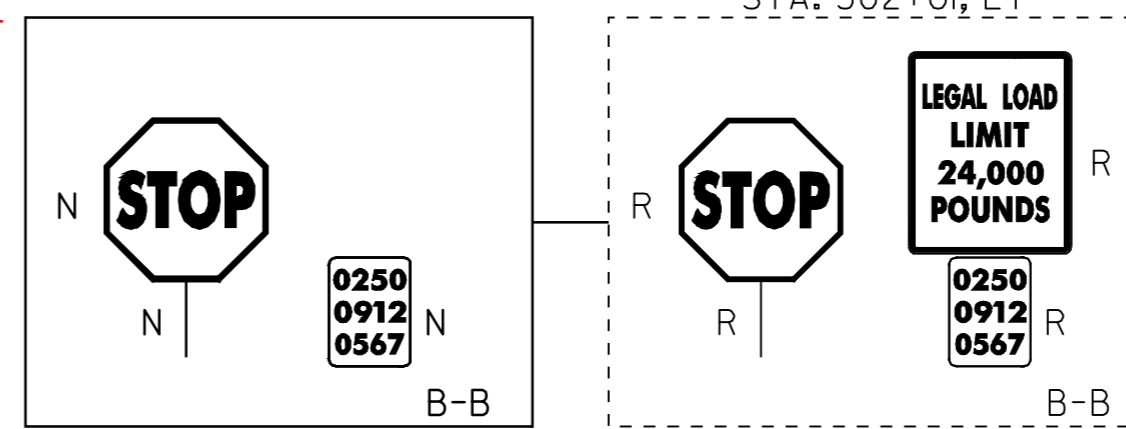

NOTES:  
 1. ALL EXISTING SIGNS NOT SHOWN SHALL BE RETAINED.  
 2. FOR LEGEND, SEE LAYOUT SHEET #1

NOT TO SCALE



**PROJECT LAYOUT SHEET #36**

PROJECT NAME: BRADFORD - ORANGE	FILE NAME: p99b178.dgn	PLOT DATE: 28-MAY-2010 13:4
PROJECT NUMBER: S1P_2213(I)	PROJECT LEADER: JLL	DRAWN BY: STANTEC
	DESIGNED BY: STANTEC	CHECKED BY: JLL
	IPARM FILE: p99b178i36.i	SHEET 53 OF 84