

604.412, 604.415, OR 604.418 REHAB.
D.I.'S, CB'S OR MH'S, CLASS I, II OR III
STA. 307+02, LT

621.20 STEEL BEAM GUARDRAIL, GALVANIZED
STA. 303+50 TO 305+18.5, RT 310+00
~~STA. 308+56 TO 310+43.5, RT~~
STA. 310+85 TO 315+50, RT
310+00

621.205 STEEL BEAM GUARDRAIL, GALVANIZED W/8 FEET POSTS
STA. 305+18.5 TO 308+56, RT
310+00 310+64

621.60 ANCHOR FOR STEEL BEAM
STA. 310+43.5, RT
STA. 310+85, RT


621.80 REMOVAL AND DISPOSAL OF GUARDRAIL
STA. 303+50 TO 310+49, RT
STA. 310+83 TO 315+50, RT

646.20
~~646.402 DURABLE 4 INCH WHITE LINE, THERMOPLASTIC~~
STA. 303+50 TO 315+50, SOLID LT & RT

646.21
~~646.412 DURABLE 4 INCH YELLOW LINE, THERMOPLASTIC~~
STA. 303+50 TO 315+50, SOLID LT & RT

646.602 TEMPORARY 4 INCH WHITE LINE, PAINT
STA. 303+50 TO 315+50, SOLID LT & RT

646.612 TEMPORARY 4 INCH YELLOW LINE, PAINT
STA. 303+50 TO 315+50, SOLID LT & RT

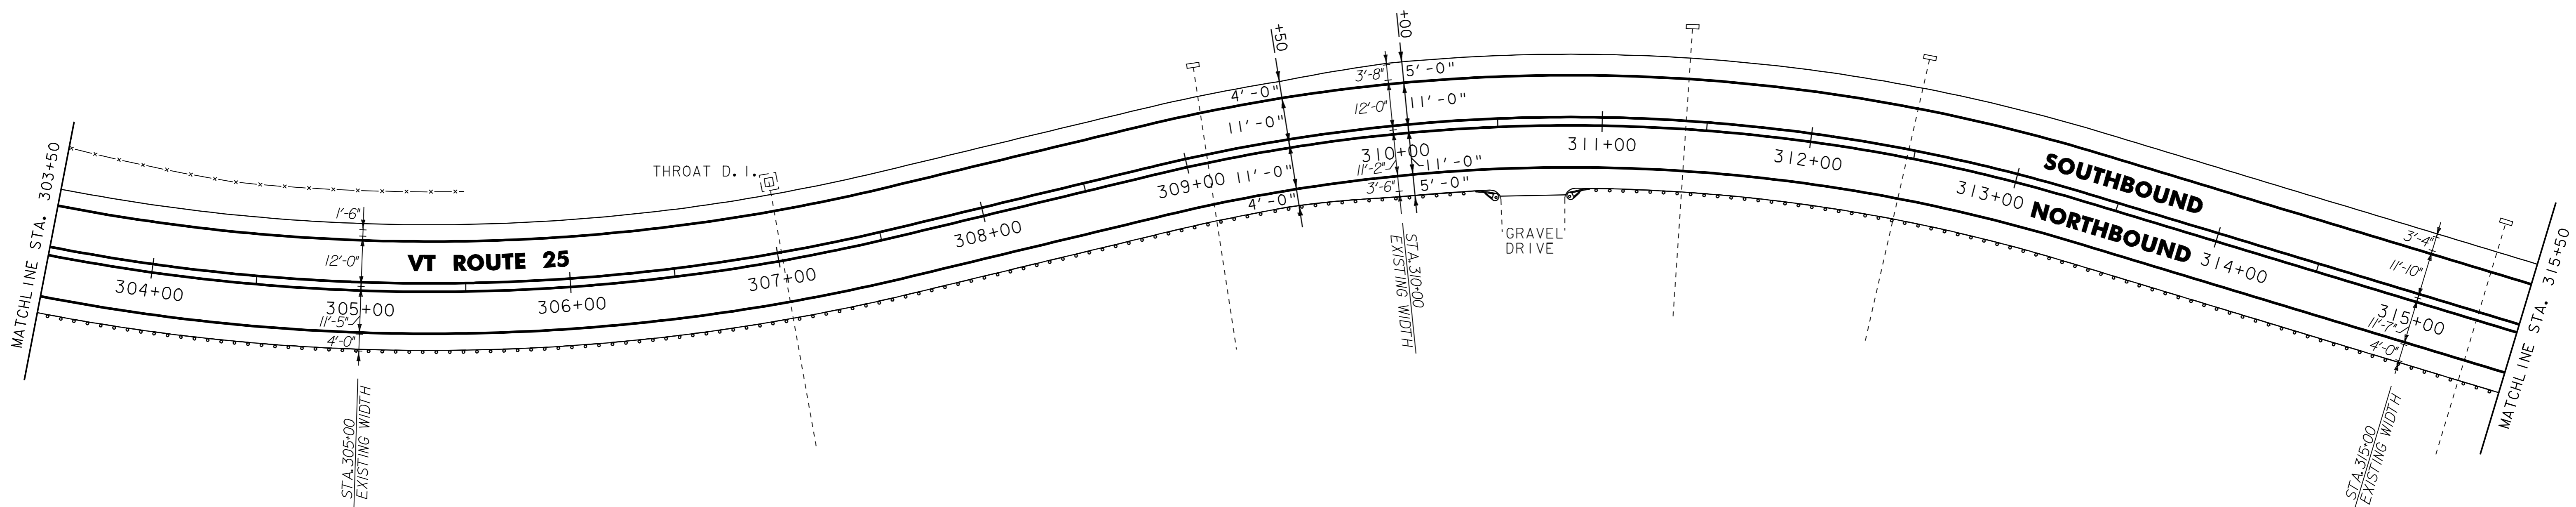

- NOTES:
1. ALL EXISTING SIGNS NOT SHOWN SHALL BE RETAINED.
 2. FOR LEGEND, SEE LAYOUT SHEET #1

NOT TO SCALE

**PROJECT
LAYOUT
SHEET #37**



PROJECT NAME: BRADFORD - ORANGE	FILE NAME: p99b178.dgn	PLOT DATE: 28-MAY-2010 13:4
PROJECT NUMBER: STP 2213(I)	PROJECT LEADER: JLL	DRAWN BY: STANTEC
	DESIGNED BY: STANTEC	CHECKED BY: JLL
	IPARM FILE: p99b178i37.i	SHEET 54 OF 84