

621.20 STEEL BEAM GUARDRAIL, GALVANIZED  
STA. 315+50 TO 319+97.5, RT

621.60 ANCHOR FOR STEEL BEAM RAIL  
STA. 319+97.5, RT  
319+00 RT


621.80 REMOVAL AND DISPOSAL OF GUARDRAIL  
STA. 315+50 TO 319+28, RT

~~646.20~~  
~~646.402 DURABLE 4 INCH WHITE LINE, THERMOPLASTIC~~  
STA. 315+50 TO 327+50, SOLID LT & RT

646.21  
646.412 DURABLE 4 INCH YELLOW LINE, THERMOPLASTIC  
STA. 315+50 TO 319+18, SOLID LT & RT  
STA. 319+18 TO 326+83, SOLID LT, DASHED RT  
STA. 326+83 TO 327+50, DASHED LT, SOLID RT

646.602 TEMPORARY 4 INCH WHITE LINE, PAINT  
STA. 315+50 TO 327+50, SOLID LT & RT

646.612 TEMPORARY 4 INCH YELLOW LINE, PAINT  
STA. 315+50 TO 319+18, SOLID LT & RT  
STA. 219+18 TO 326+83, SOLID LT, DASHED RT  
STA. 326+83 TO 327+50, DASHED LT, SOLID RT

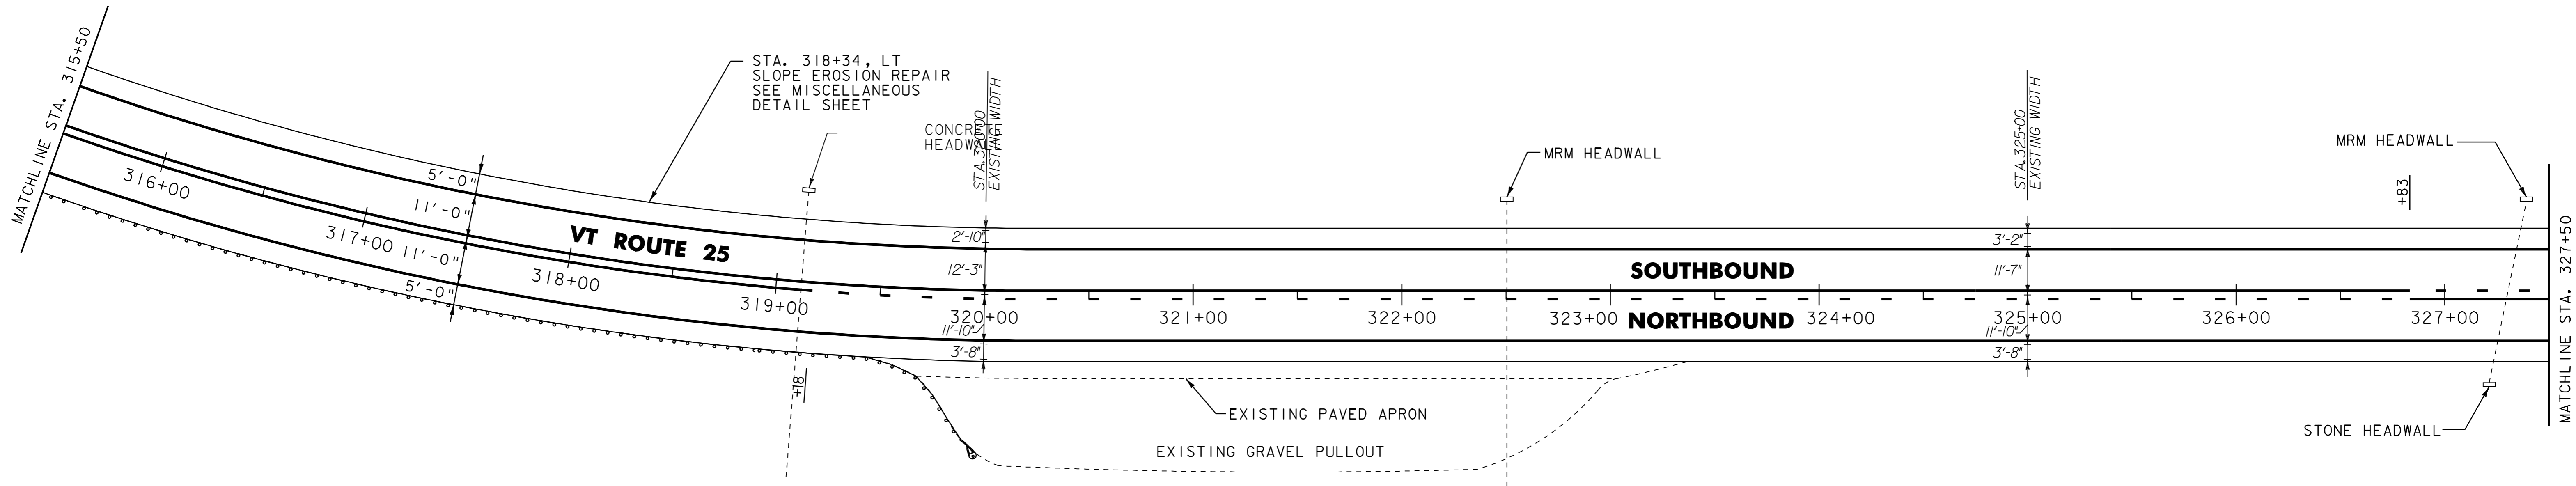


~~646.20~~  
~~646.402 DURABLE 4 INCH WHITE LINE, THERMOPLASTIC~~  
STA. 327+50 TO 339+50, SOLID LT & RT

646.21  
~~646.412 DURABLE 4 INCH YELLOW LINE, THERMOPLASTIC~~  
STA. 327+50 TO 335+28, DASHED LT, SOLID RT  
STA. 335+28 TO 339+50, SOLID LT & RT

646.602 TEMPORARY 4 INCH WHITE LINE, PAINT  
STA. 327+50 TO 339+50, SOLID LT & RT

646.612 TEMPORARY 4 INCH YELLOW LINE, PAINT  
STA. 292+00 TO 303+50, SOLID LT & RT  
STA. 299+52, DOUBLE SOLID RT (T.H. 24)

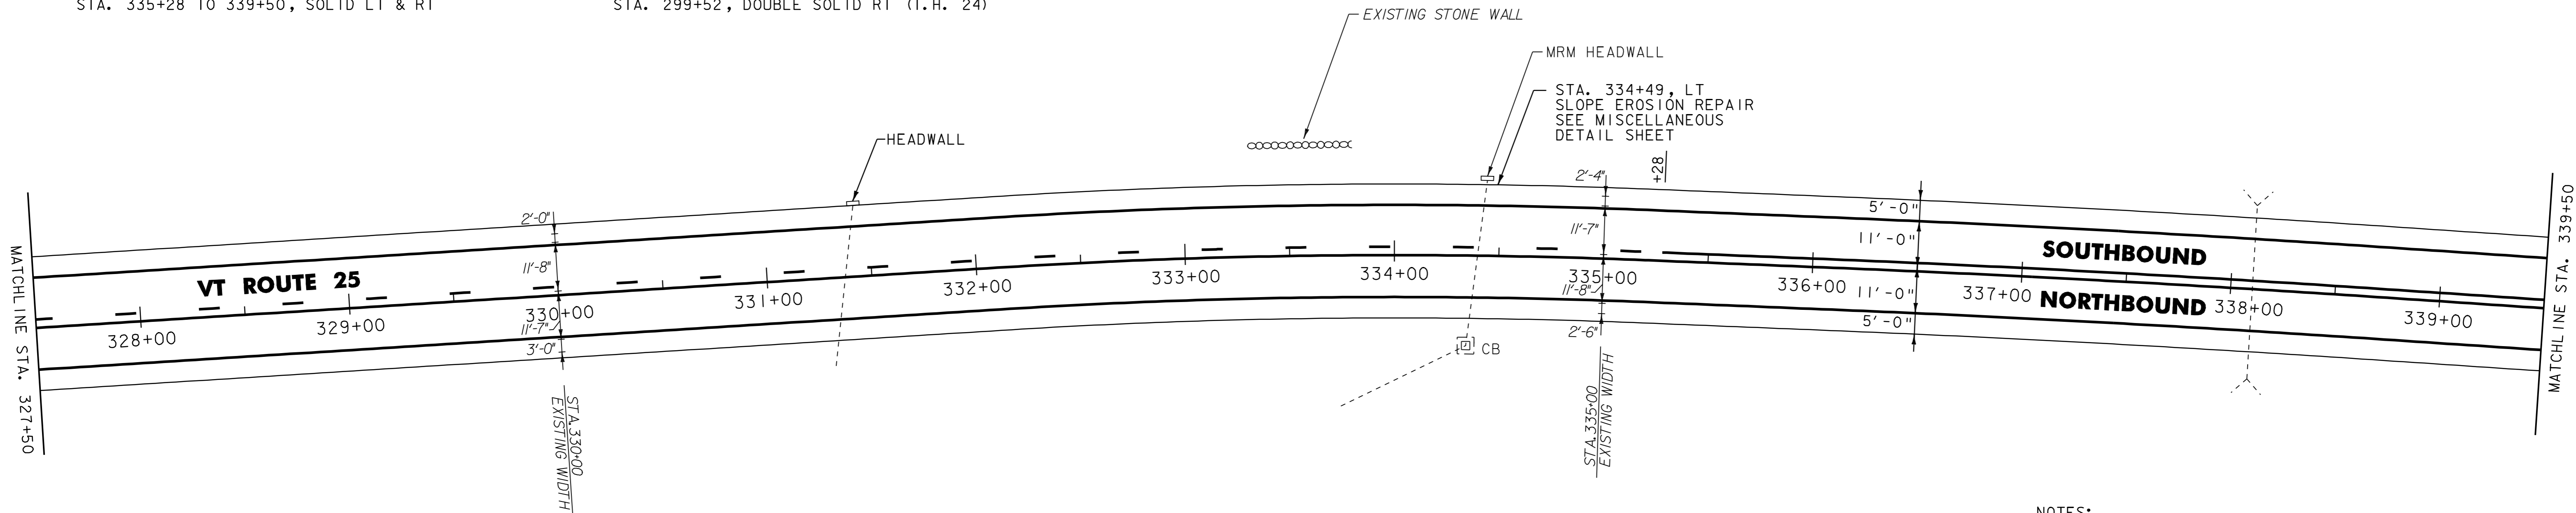

- NOTES:
1. ALL EXISTING SIGNS NOT SHOWN SHALL BE RETAINED.
  2. FOR LEGEND, SEE LAYOUT SHEET #1

NOT TO SCALE

**PROJECT LAYOUT SHEET #38**



PROJECT NAME: BRADFORD - ORANGE	FILE NAME: p99b178.dgn	PLOT DATE: 28-MAY-2010 13:4
PROJECT NUMBER: S1P_2213(I)	PROJECT LEADER: JLL	DRAWN BY: STANTEC
DESIGNED BY: STANTEC	CHECKED BY: JLL	SHEET 55 OF 84
IPARM FILE: p99b178i38.i		