

604.412, 604.415, OR 604.418 REHAB.
 D1'S, CB'S OR MH'S, CLASS I, II OR III
 ORANGE STA. 0+03, LT **NO WORK WAS DONE**

621.20 STEEL BEAM GUARDRAIL, GALVANIZED
 ORANGE STA. 1+30 TO 7+00, RT 2+80 TO 3+12.5
 ORANGE STA 3+35.5 TO 7+00 RT
 621.50 MANUFACTURED TERMINAL SECTION, FLARED
 ORANGE STA. 0+92.5 TO 1+30, RT


621.80 REMOVAL AND DISPOSAL OF GUARDRAIL
 ORANGE STA. 3+36 TO 7+00, RT
 646.20
 646.402 DURABLE 4 INCH WHITE LINE, THERMOPLASTIC
 TOPSHAM STA. 339+50 TO ORANGE STA. 7+00, SOLID LT & RT

646.21
 646.412 DURABLE 4 INCH YELLOW LINE, THERMOPLASTIC
 TOPSHAM STA. 339+50 TO ORANGE STA. 7+00, SOLID LT & RT
 646.602 TEMPORARY 4 INCH WHITE LINE, PAINT
 TOPSHAM STA. 339+50 TO ORANGE STA. 7+00, SOLID LT & RT

646.612 TEMPORARY 4 INCH YELLOW LINE, PAINT
 TOPSHAM STA. 339+50 TO ORANGE STA. 7+00, SOLID LT & RT
 675.50 REMOVING SIGNS
 AS SHOWN - 2

621.205 STEEL BEAM GUARDRAIL, GALVANIZED W/ 8' POSTS
 ORANGE STA 1+30 TO 2+80 RT

**TOPSHAM STA 342+78 BK=
 ORANGE STA 0+00 AHD**

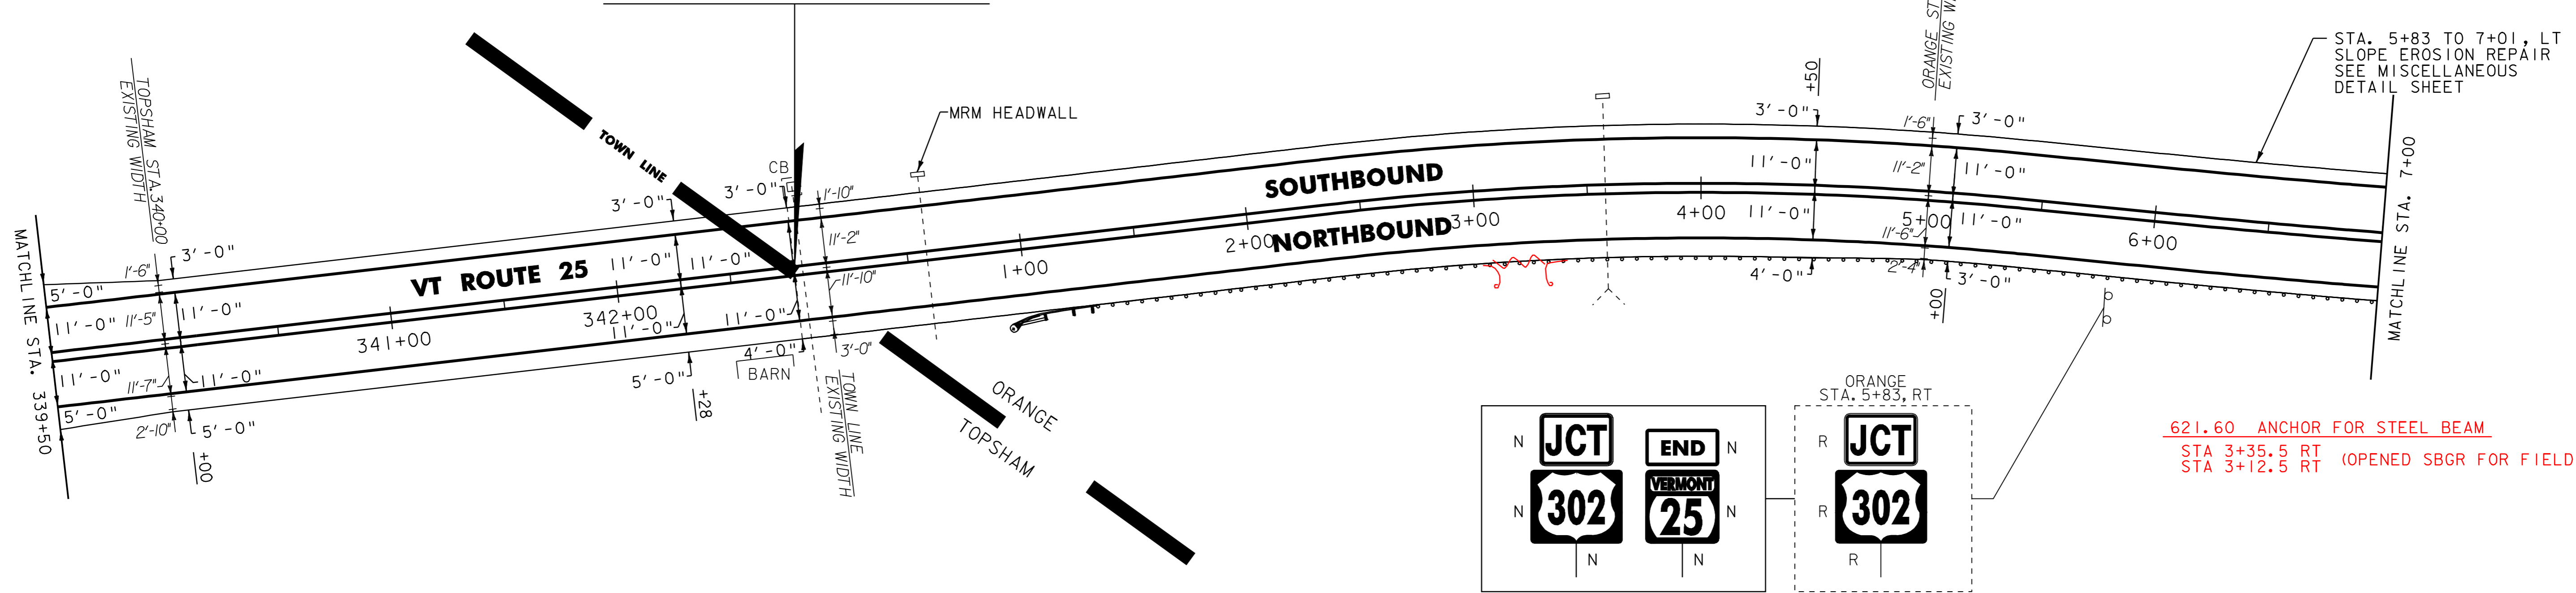

621.60 ANCHOR FOR STEEL BEAM
 STA 3+35.5 RT
 STA 3+12.5 RT (OPENED SBGR FOR FIELD DRIVE)

621.60 ANCHOR FOR STEEL BEAM
 14+50 LT (REPLACED BCT)

621.80 REMOVAL & DISPOSAL OF GUARDRAIL
 14+50 TO 14+87.5 RT
 14+50 TO 14+75 LT

621.20 STEEL BEAM GUARDRAIL, GALVANIZED
 ORANGE STA. 7+00 TO 8+80, RT

621.50 MANUFACTURED TERMINAL SECTION, FLARED
 STA. 8+80 TO 9+17.5, RT
 STA 13+84 TO 14+21.5 RT (REPLACED BCT)
 621.80 REMOVAL AND DISPOSAL OF GUARDRAIL
 ORANGE STA. 7+00 TO 7+33, RT
 646.20
 646.402 DURABLE 4 INCH WHITE LINE, THERMOPLASTIC
 STA. 7+00 TO 14+50, SOLID LT & RT
 646.21
 646.412 DURABLE 4 INCH YELLOW LINE, THERMOPLASTIC
 STA. 7+00 TO 14+50, SOLID LT & RT

646.492 DURABLE LETTER OR SYMBOL, THERMOPLASTIC
 STA. 8+03, RT - "STOP"
 STA. 8+43, RT - "AHEAD"


646.602 TEMPORARY 4 INCH WHITE LINE, PAINT
 STA. 7+00 TO 14+50, SOLID LT & RT

646.612 TEMPORARY 4 INCH YELLOW LINE, PAINT
 STA. 7+00 TO 14+50, SOLID LT & RT

646.692 TEMPORARY LETTER OR SYMBOL, PAINT
 STA. 8+03, RT - "STOP"
 STA. 8+43, RT - "AHEAD"

675.50 REMOVING SIGNS
 AS SHOWN - 4

STA. 7+90 TO 8+60, LT
 SLOPE EROSION REPAIR
 SEE MISCELLANEOUS
 DETAIL SHEET

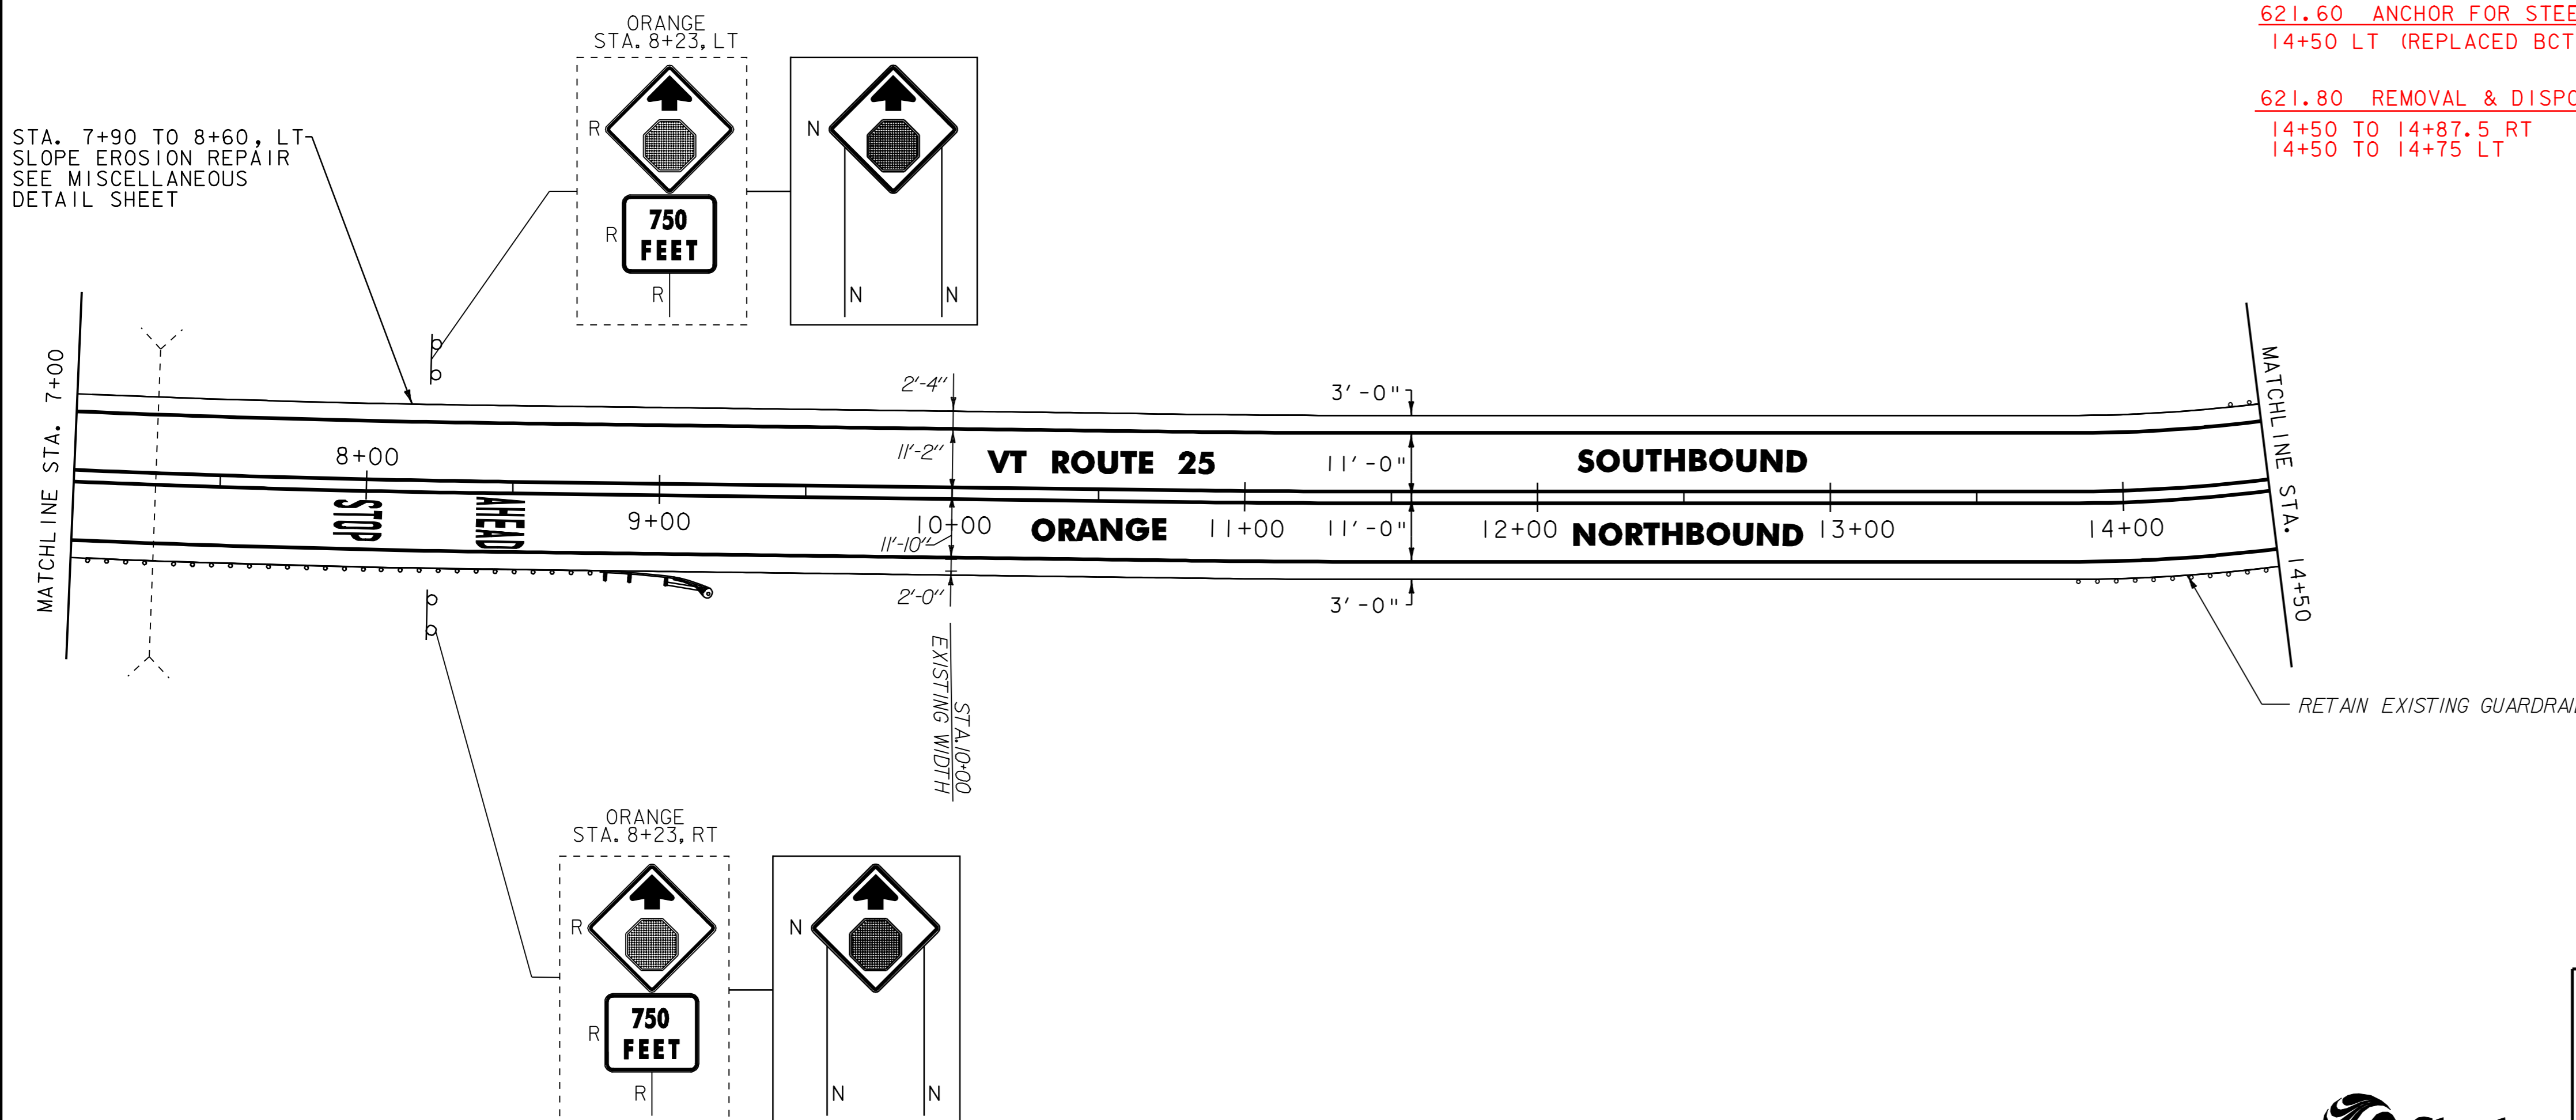

- NOTES:
1. ALL EXISTING SIGNS NOT SHOWN SHALL BE RETAINED.
 2. FOR LEGEND, SEE LAYOUT SHEET #1

NOT TO SCALE

**PROJECT
 LAYOUT
 SHEET #39**



PROJECT NAME: BRADFORD - ORANGE	FILE NAME: p99b178.dgn	PLOT DATE: 28-MAY-2010 13:4
PROJECT NUMBER: SIP 2213(I)	PROJECT LEADER: JLL	DRAWN BY: STANTEC
	DESIGNED BY: STANTEC	CHECKED BY: JLL
	IPARM FILE: p99b178139.i	SHEET 56 OF 84