

646.20 4 INCH WHITE LINE  
~~646.402 DURABLE 4 INCH WHITE LINE, THERMOPLASTIC~~  
 VT ROUTE 25 STA. 14+50 TO STA. 14+94, SOLID LT & RT

646.21 4 INCH YELLOW LINE  
~~646.412 DURABLE 4 INCH YELLOW LINE, THERMOPLASTIC~~  
 VT ROUTE 25 STA. 14+50 TO STA. 15+20, DOUBLE SOLID RT

646.26 8 INCH WHITE LINE  
~~646.442 DURABLE 8 INCH WHITE LINE, THERMOPLASTIC~~  
 STA. 15+13 TO STA. 15+76, RT (TRIANGULAR ISLAND & DIAGONALS)

646.26 24 INCH STOP BAR  
~~646.482 DURABLE 24 INCH STOP BAR, THERMOPLASTIC~~  
 STA. 15+00, RT

646.492 DURABLE LETTER OR SYMBOL, THERMOPLASTIC  
 STA. 15+02, RT - "STOP"

646.602 TEMPORARY 4 INCH WHITE LINE, PAINT  
 VT ROUTE 25 STA. 14+50 TO STA. 14+94, SOLID LT & RT

646.612 TEMPORARY 4 INCH YELLOW LINE, PAINT  
 VT ROUTE 25 STA. 14+50 TO STA. 15+20, DOUBLE SOLID RT


646.642 TEMPORARY 8 INCH WHITE LINE, PAINT  
 STA. 15+13 TO STA. 15+76, RT (TRIANGULAR ISLAND & DIAGONALS)

646.682 TEMPORARY 24 INCH STOP BAR, PAINT  
 STA. 15+00, RT

646.692 TEMPORARY LETTER OR SYMBOL, PAINT  
 STA. 15+02, RT - "STOP"

675.50 REMOVING SIGNS  
 AS SHOWN - 2

**END PROJECT STP 2213(1)**  
**STA 16+31.52**

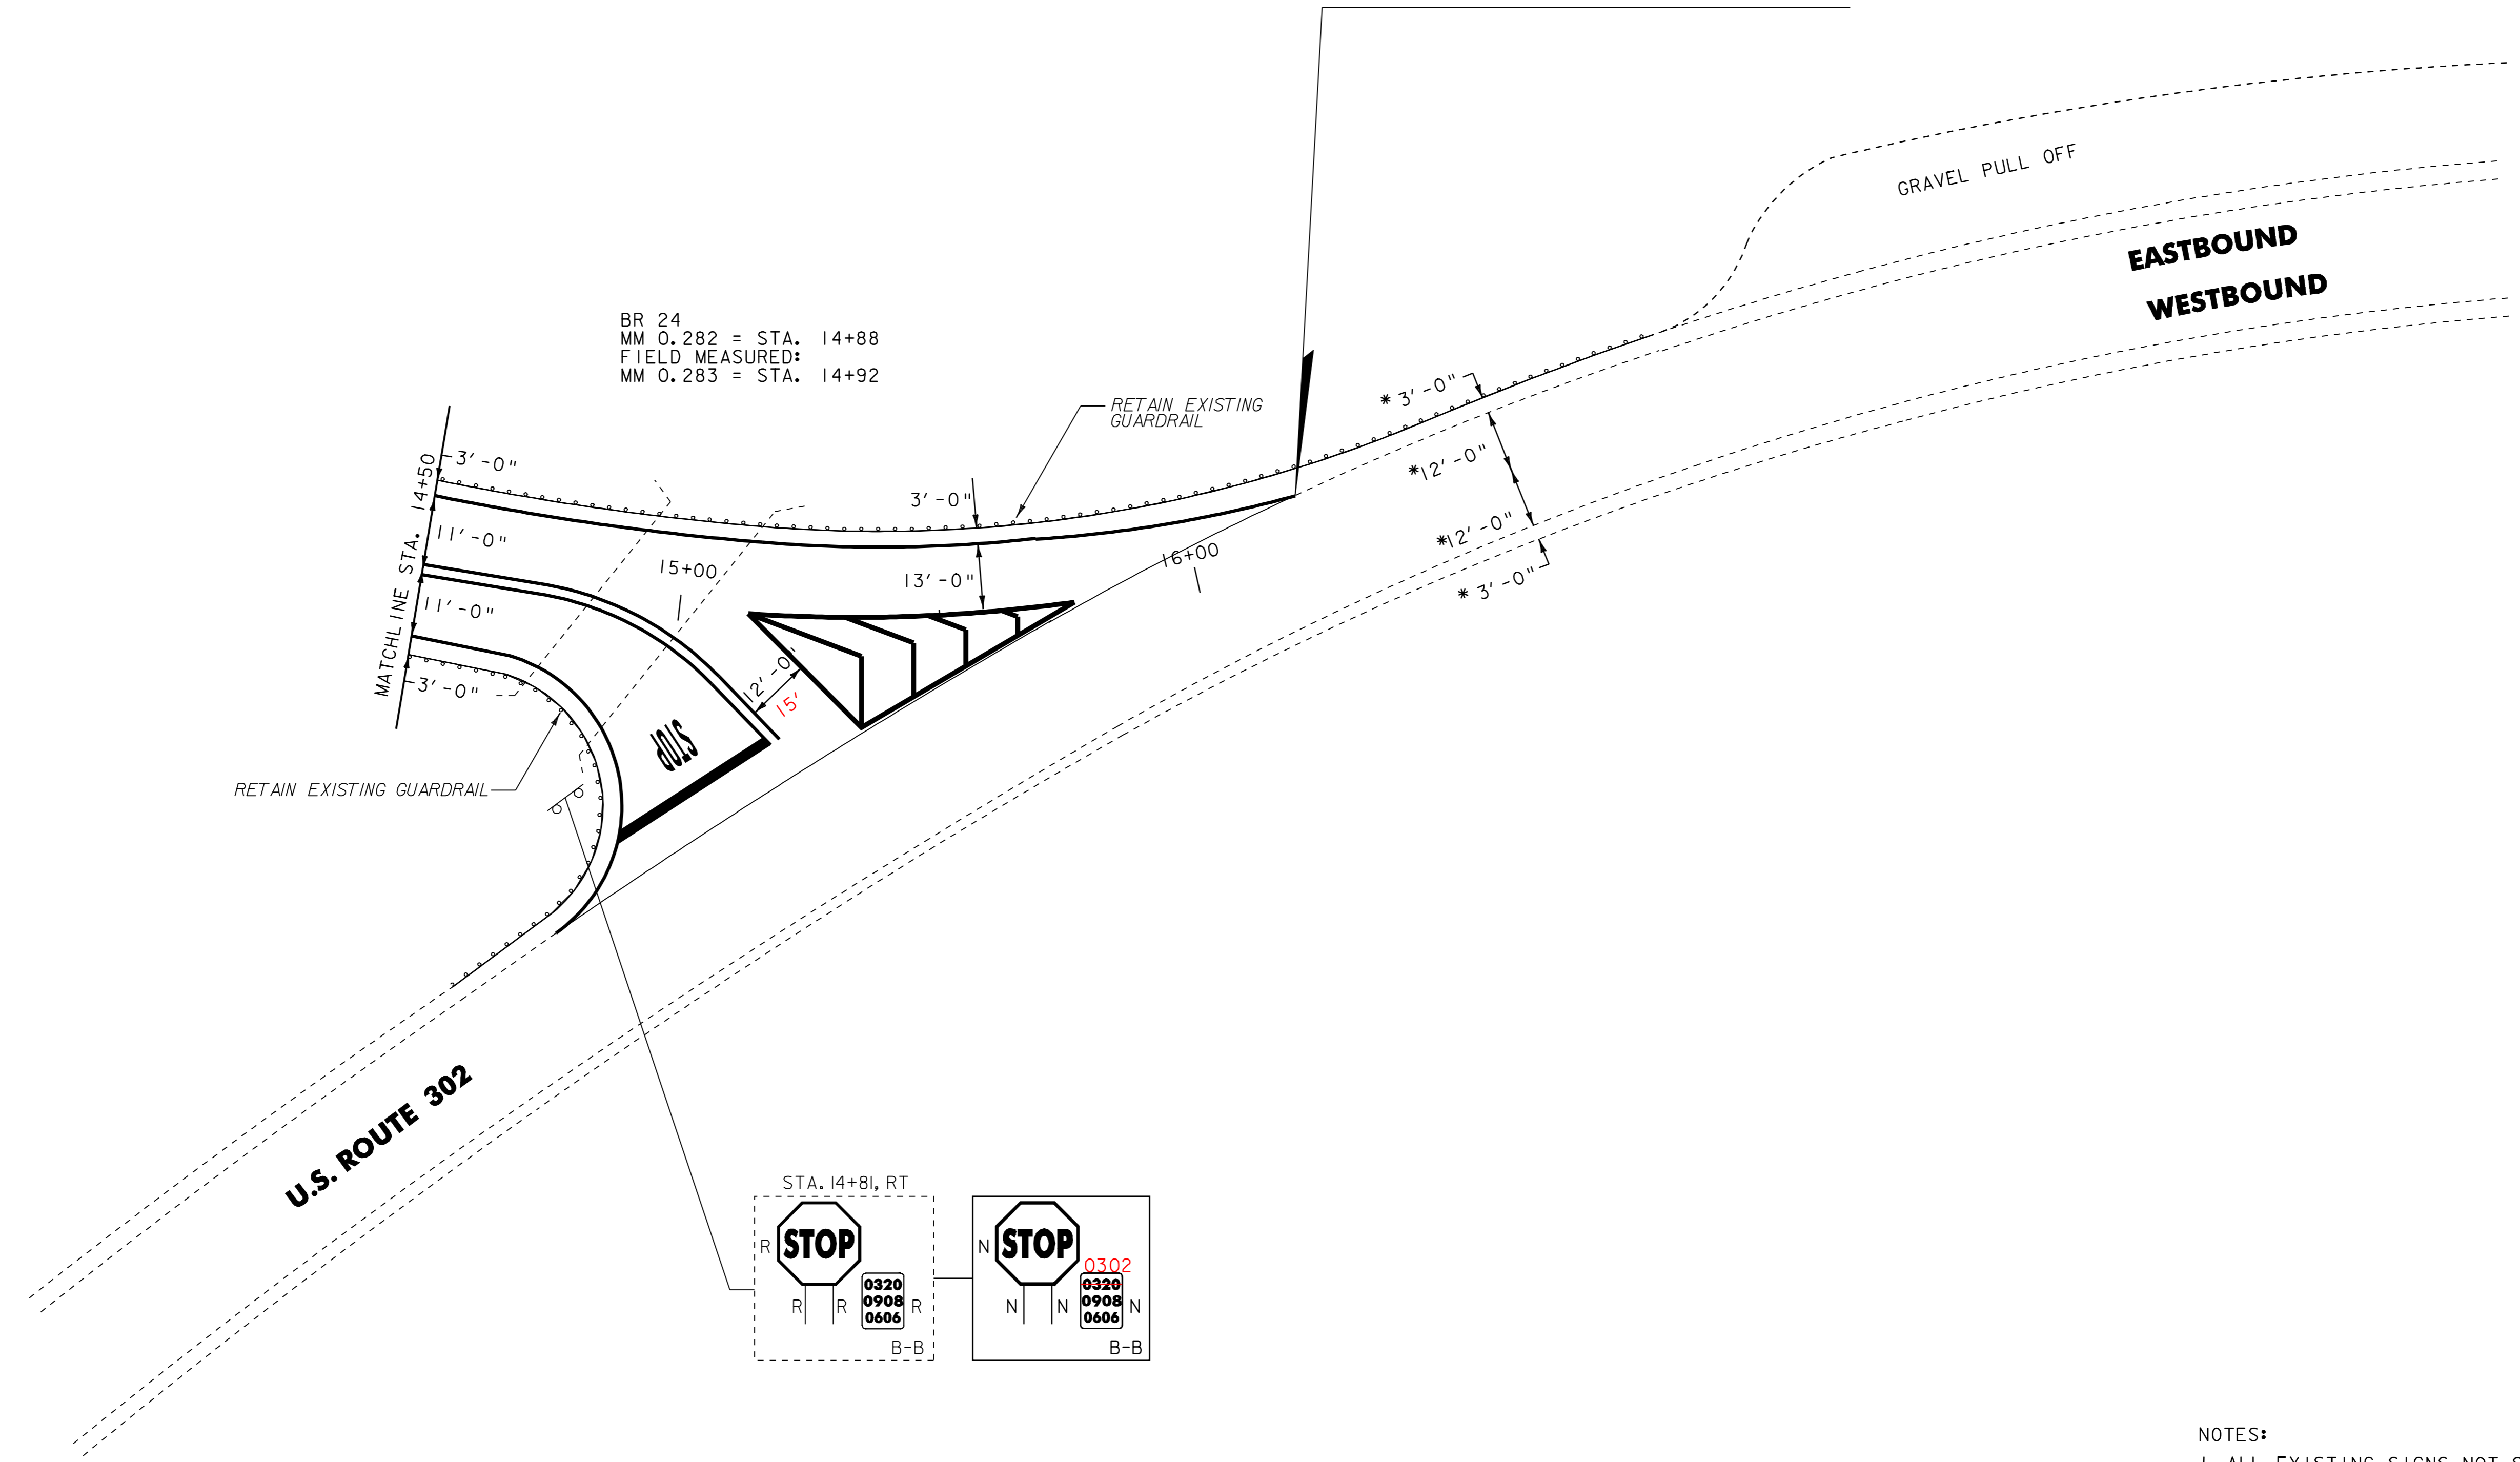

- NOTES:
1. ALL EXISTING SIGNS NOT SHOWN SHALL BE RETAINED.
  2. FOR LEGEND, SEE LAYOUT SHEET #1

NOT TO SCALE

<b>PROJECT LAYOUT SHEET #40</b>	PROJECT NAME: BRADFORD - ORANGE
	PROJECT NUMBER: STP 2213(1)
	FILE NAME: p99b178.dgn
	PLOT DATE: 28-MAY-2010 13:4
PROJECT LEADER: JLL	DRAWN BY: STANTEC
DESIGNED BY: STANTEC	CHECKED BY: JLL
IPARM FILE: p99b178140.i	SHEET 57 OF 84

