

646.20  
~~646.402 DURABLE 4 INCH WHITE LINE, THERMOPLASTIC~~  
 CORINTH:  
 STA. 70+24 DOUBLE SOLID RT (T.H. I)

646.21  
~~646.412 DURABLE 4 INCH YELLOW LINE, THERMOPLASTIC~~  
 CORINTH:  
 STA. 70+24 DOUBLE SOLID RT (T.H. I)

646.26  
~~646.482 DURABLE 24" STOP BAR, THERMOPLASTIC~~  
 CORINTH:  
 STA. 70+25 RT (T.H. I)

646.492 DURABLE LETTER OR SYMBOL, THERMOPLASTIC  
 CORINTH:  
 STA. 70+40 RT - "STOP"


646.602 TEMPORARY 4 INCH WHITE LINE, PAINT  
 CORINTH:  
 STA. 70+24 DOUBLE SOLID RT (T.H. I)

646.612 TEMPORARY 4 INCH YELLOW LINE, PAINT  
 CORINTH:  
 STA. 70+24 DOUBLE SOLID RT (T.H. I)

646.682 TEMPORARY 24" STOP BAR, PAINT  
 CORINTH:  
 STA. 70+25 RT (T.H. I)

646.692 TEMPORARY LETTER OR SYMBOL, PAINT  
 CORINTH:  
 STA. 70+40 RT - "STOP"

675.50 REMOVING SIGNS  
 AS SHOWN - I

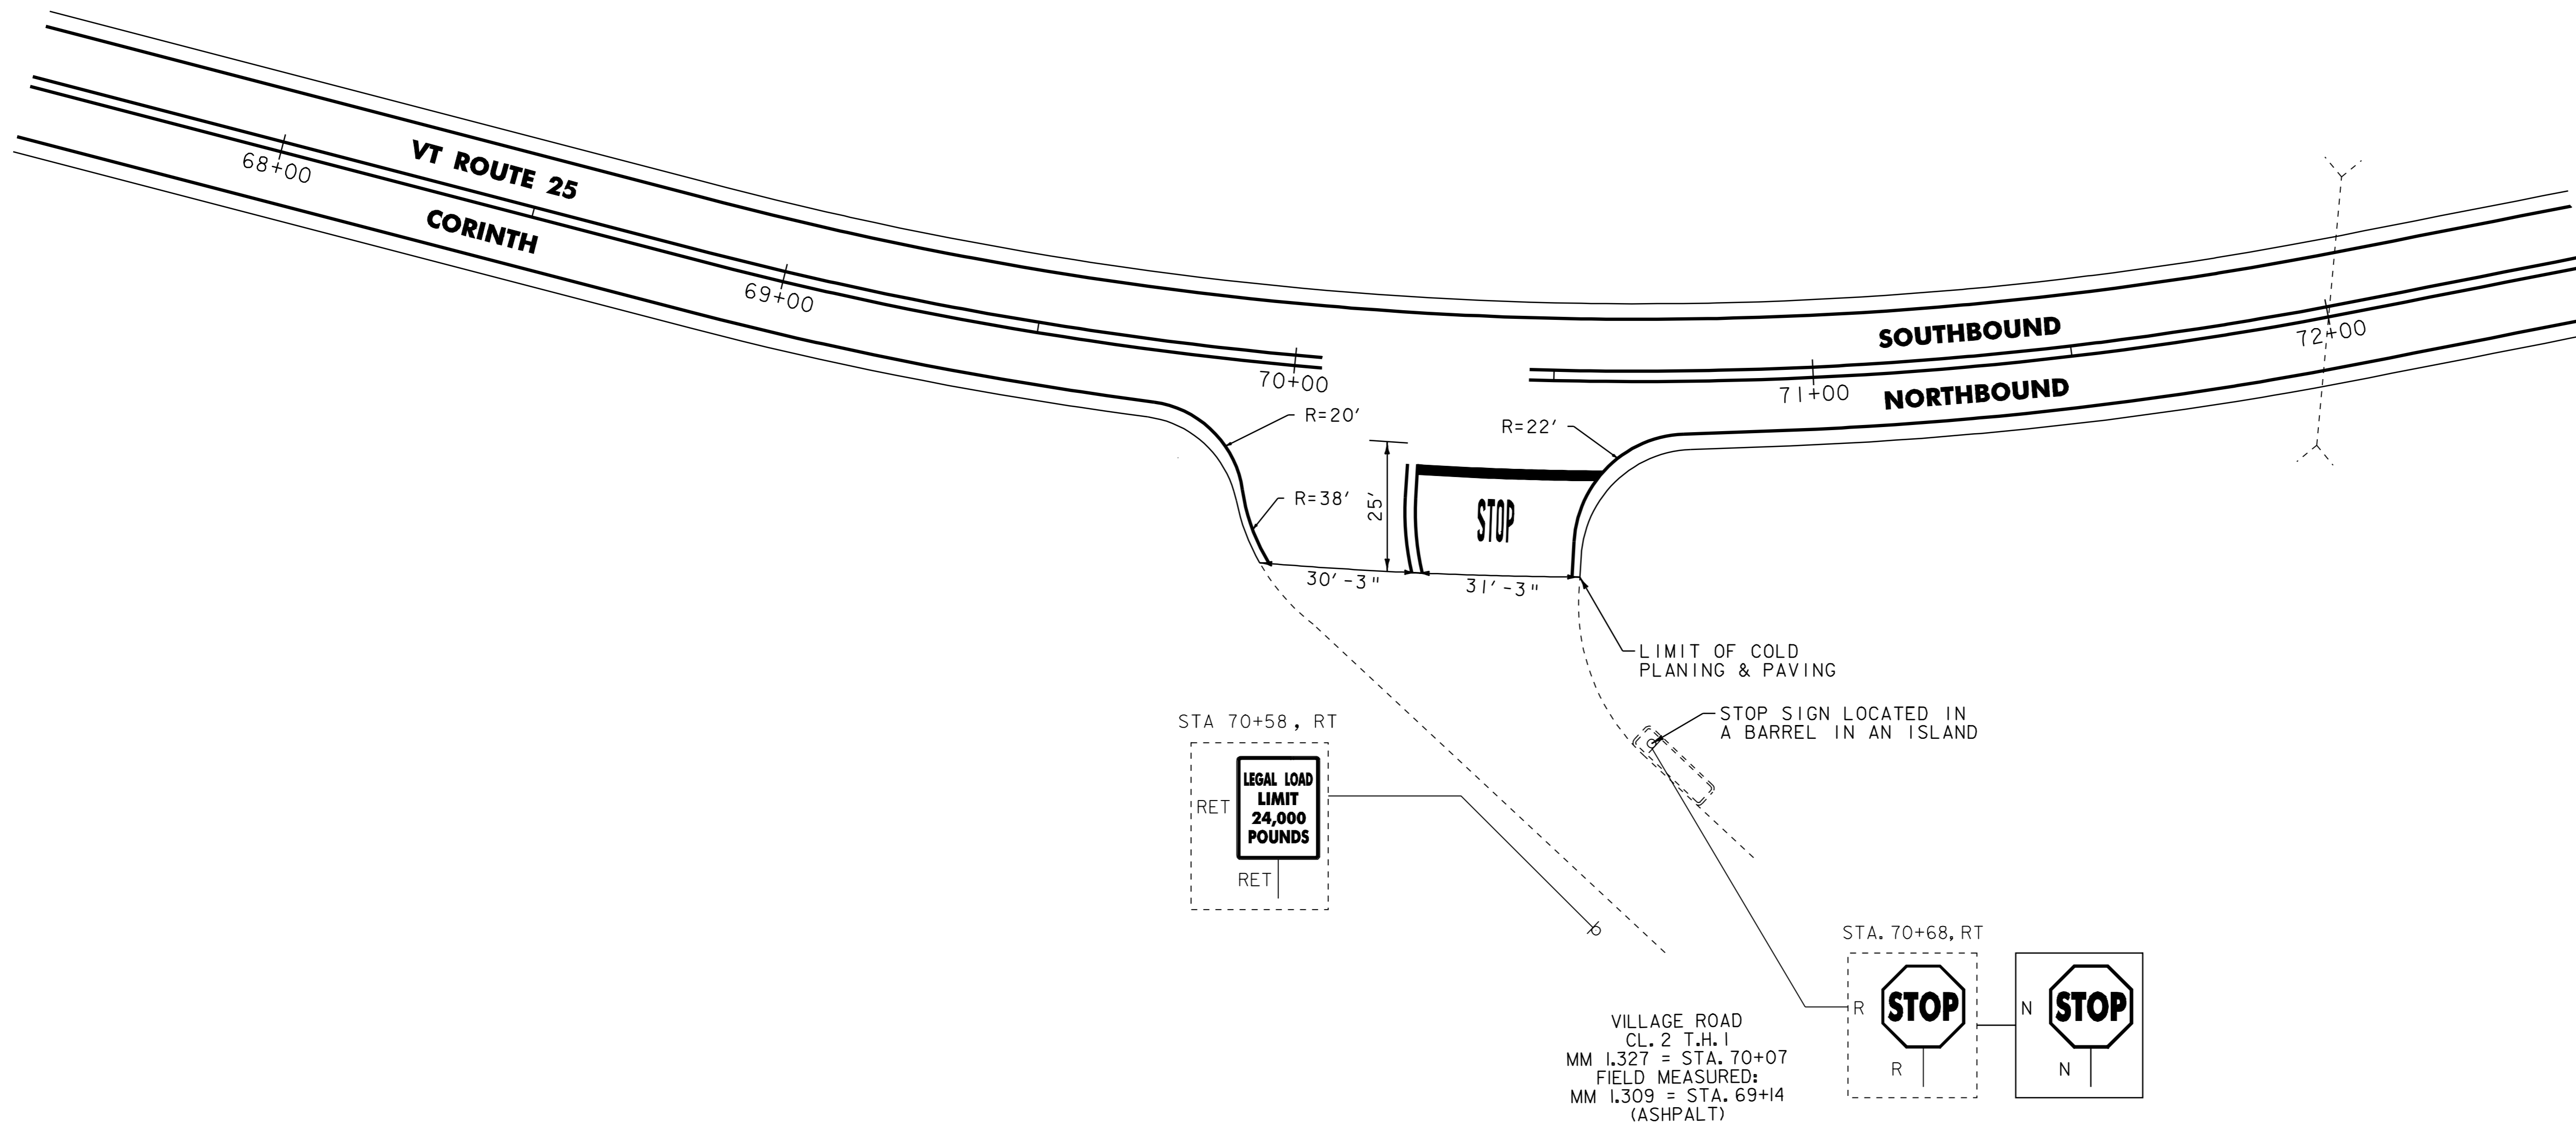

**T.H.1 - VILLAGE ROAD  
 CORINTH MM 1.309 = STA. 69+14**

NOTE:

1. PAVING LIMIT ON ALL TOWN HIGHWAYS SHALL BE MEASURED 25 FT. BACK FROM VT ROUTE 25 EDGE OF SHOULDER UNLESS DENOTED OTHERWISE ON THE PLANS OR AS DIRECTED BY THE RESIDENT ENGINEER.

NOT TO SCALE

SIGN LEGEND  
 R = REMOVE  
 S = SALVAGE  
 N = NEW  
 RET = RETAIN  
 B-B = BACK TO BACK  
 EXISTING = -----  
 NEW = \_\_\_\_\_



**INTERSECTION  
 DETAIL SHEET  
 NO. 1**

PROJECT NAME: BRADFORD - ORANGE  
 PROJECT NUMBER: STP 2213(I)  
 FILE NAME: p99b178.dgn PLOT DATE: 28-MAY-2010 13:4  
 PROJECT LEADER: JLL DRAWN BY: STANTEC  
 DESIGNED BY: STANTEC CHECKED BY: JLL  
 IPARM FILE: z99b178int01.i SHEET 58 OF 84