

~~621.20 STEEL BEAM GUARDRAIL, GALVANIZED  
STA. 74+50 TO 76+65, RT~~

~~621.50 MANUFACTURED TERMINAL SECTION, FLARED  
STA. 76+65 TO 77+02.5, RT  
(SEE DRAINAGE AT M.T.S. DETAIL SHEET)~~

~~621.81 REMOVAL AND DISPOSAL OF GUIDE POSTS  
STA. 74+50 TO 76+59, RT~~

~~646.20  
646.402 DURABLE 4 INCH WHITE LINE, THERMOPLASTIC  
STA. 74+50 TO 86+50, SOLID LT & RT~~


~~646.21  
646.412 DURABLE 4 INCH YELLOW LINE, THERMOPLASTIC  
STA. 74+50 TO 82+63, SOLID LT & RT  
STA. 82+63 TO 86+50, SOLID LT, DASHED RT~~

646.602 TEMPORARY 4 INCH WHITE LINE, PAINT  
STA. 74+50 TO 86+50, SOLID LT & RT

646.612 TEMPORARY 4 INCH YELLOW LINE, PAINT  
STA. 74+50 TO 82+63, SOLID LT & RT  
STA. 82+63 TO 86+50, SOLID LT, DASHED RT

675.50 REMOVING SIGNS  
AS SHOWN - 7

675.60 ERECTING SALVAGED SIGNS  
AS SHOWN - 2

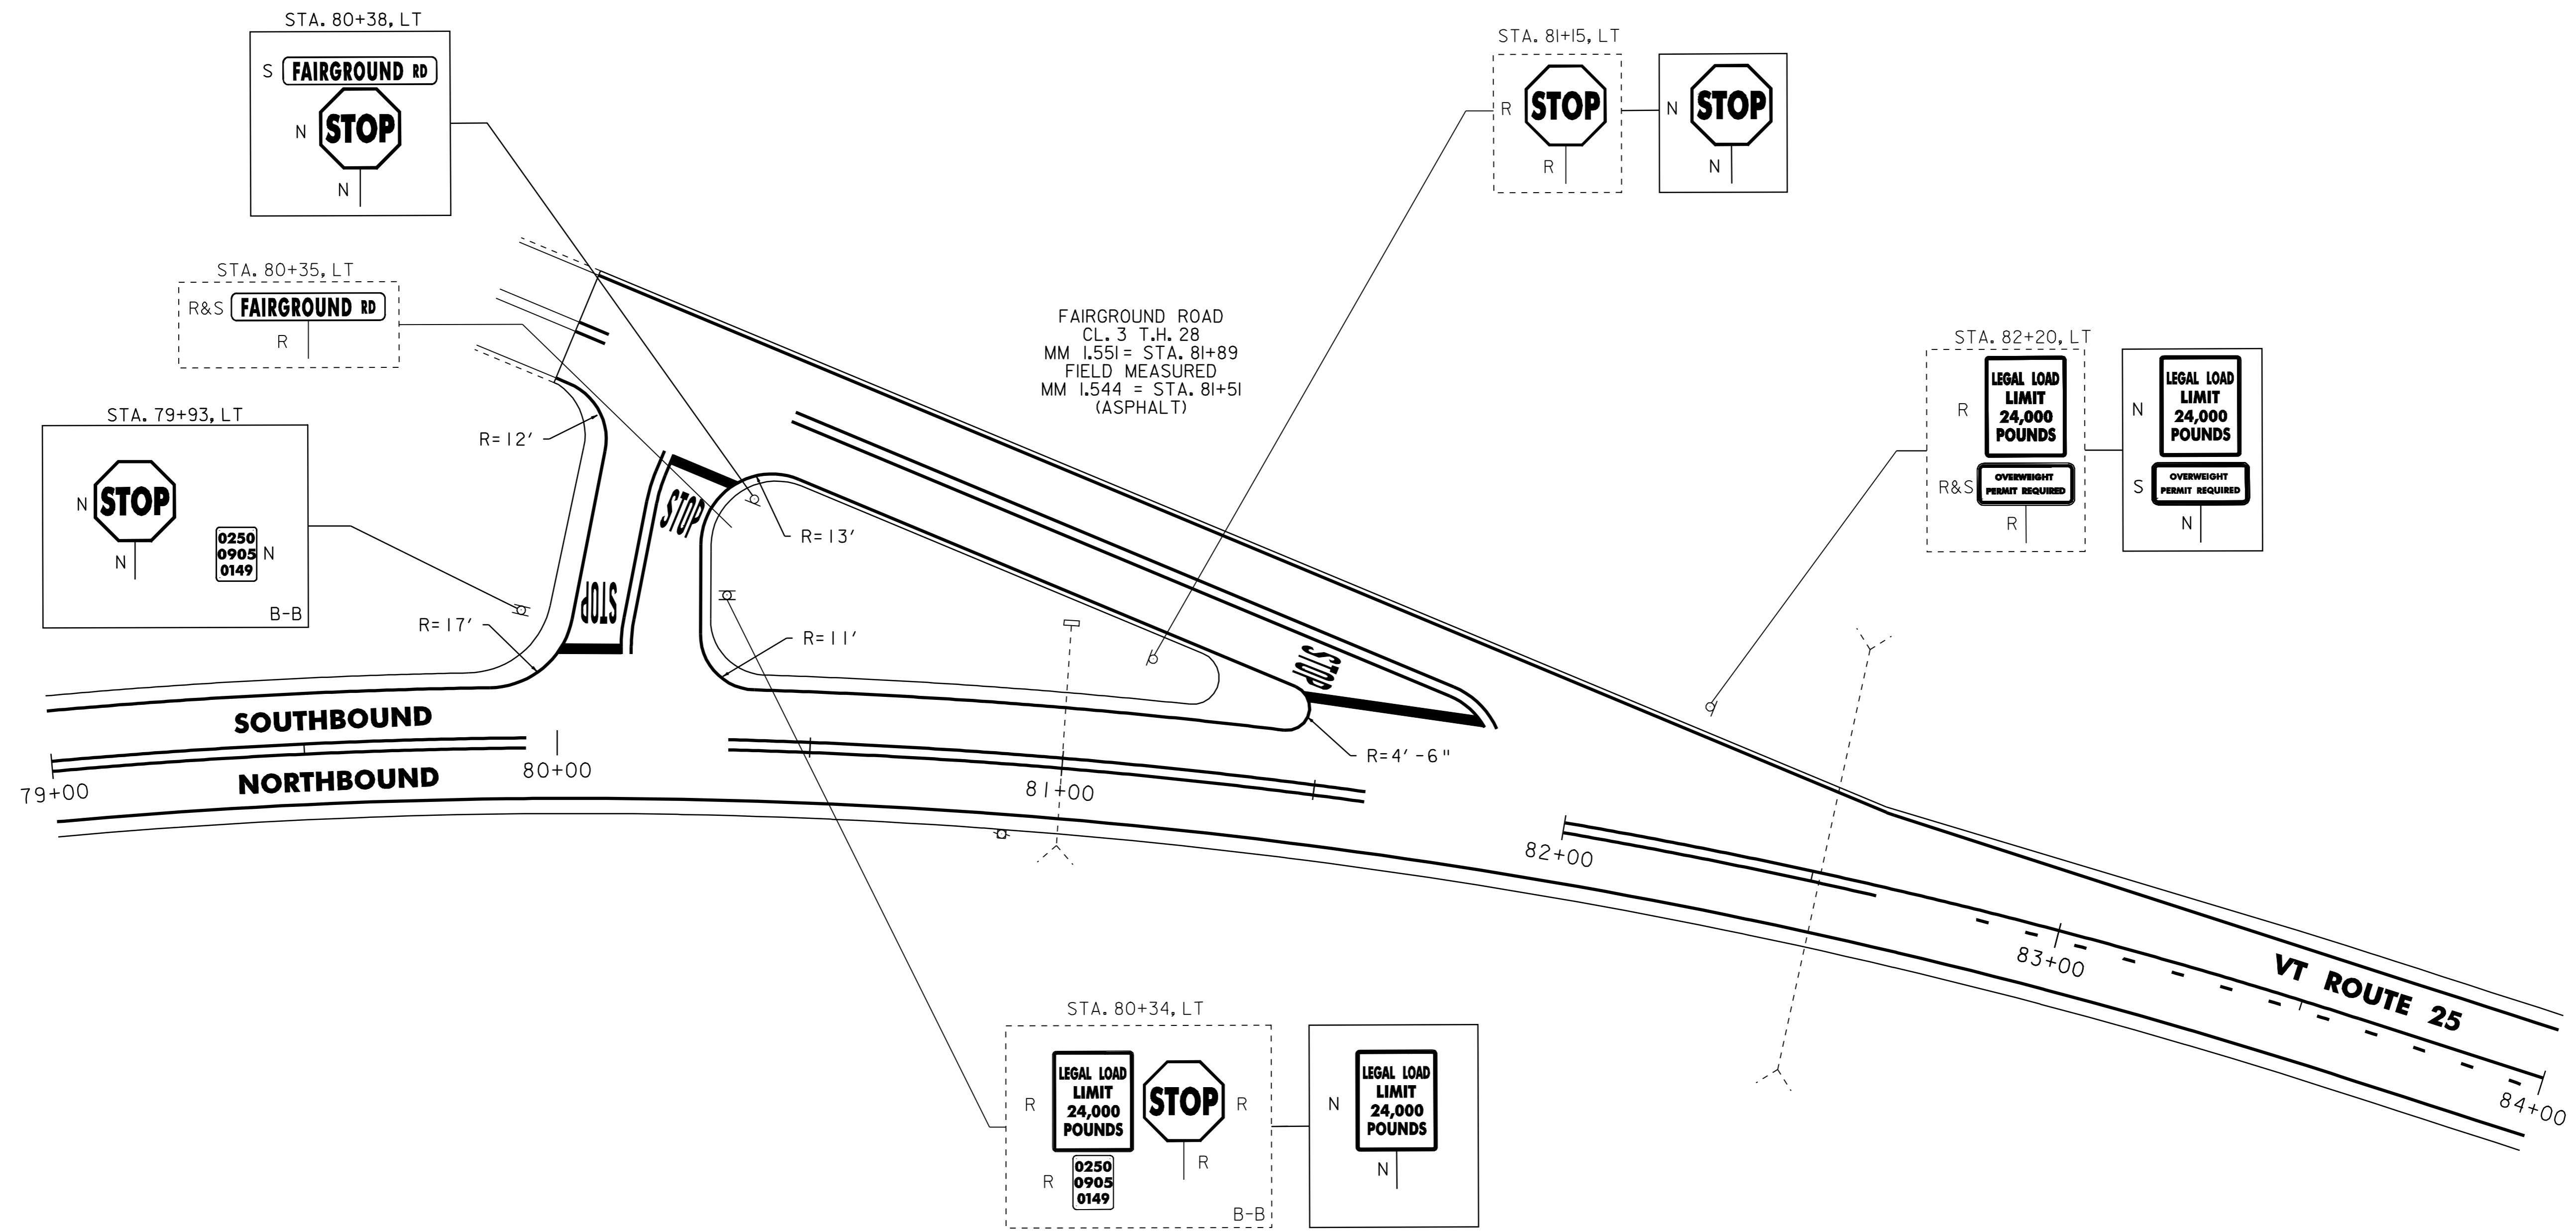

**T.H.28 - FAIRGROUND ROAD  
CORINTH MM 1.544 = STA. 81+51**

NOTE:

1. PAVING LIMIT ON ALL TOWN HIGHWAYS SHALL BE MEASURED 25 FT. BACK FROM VT ROUTE 25 EDGE OF SHOULDER UNLESS DENOTED OTHERWISE ON THE PLANS OR AS DIRECTED BY THE RESIDENT ENGINEER.

NOT TO SCALE

**INTERSECTION  
DETAIL SHEET  
NO. 2**

**SIGN LEGEND**  
R = REMOVE  
S = SALVAGE  
N = NEW  
RET = RETAIN  
B-B = BACK TO BACK  
EXISTING =         
NEW =       



PROJECT NAME: BRADFORD - ORANGE  
PROJECT NUMBER: STP 2213(I)  
FILE NAME: p99b178.dgn PLOT DATE: 28-MAY-2010 13:4  
PROJECT LEADER: JLL DRAWN BY: STANTEC  
DESIGNED BY: STANTEC CHECKED BY: JLL  
IPARM FILE: z99b178int02.i SHEET 59 OF 84