

646.20
~~646.402 DURABLE 4 INCH WHITE LINE, THERMOPLASTIC~~
 CORINTH:
 STA. 114+00 DOUBLE SOLID LT (T.H. 4)

646.602 TEMPORARY 4 INCH WHITE LINE, PAINT
 CORINTH:
 STA. 114+00 DOUBLE SOLID LT (T.H. 4)

675.50 REMOVING SIGNS
 AS SHOWN - 4

646.21
~~646.412 DURABLE 4 INCH YELLOW LINE, THERMOPLASTIC~~
 CORINTH:
 STA. 113+62 DOUBLE SOLID LT (T.H. 4)


646.612 TEMPORARY 4 INCH YELLOW LINE, PAINT
 CORINTH:
 STA. 113+62 DOUBLE SOLID LT (T.H. 4)

646.26
~~646.482 DURABLE 24" STOP BAR, THERMOPLASTIC~~
 CORINTH:
 STA. 113+62 LT (T.H. 4)

646.682 TEMPORARY 24" STOP BAR, PAINT
 CORINTH:
 STA. 113+62 LT (T.H. 4)

646.492 DURABLE LETTER OR SYMBOL, THERMOPLASTIC
 CORINTH:
 STA. 113+62 LT - "STOP"

646.692 TEMPORARY LETTER OR SYMBOL, PAINT
 CORINTH:
 STA. 113+62 LT - "STOP"

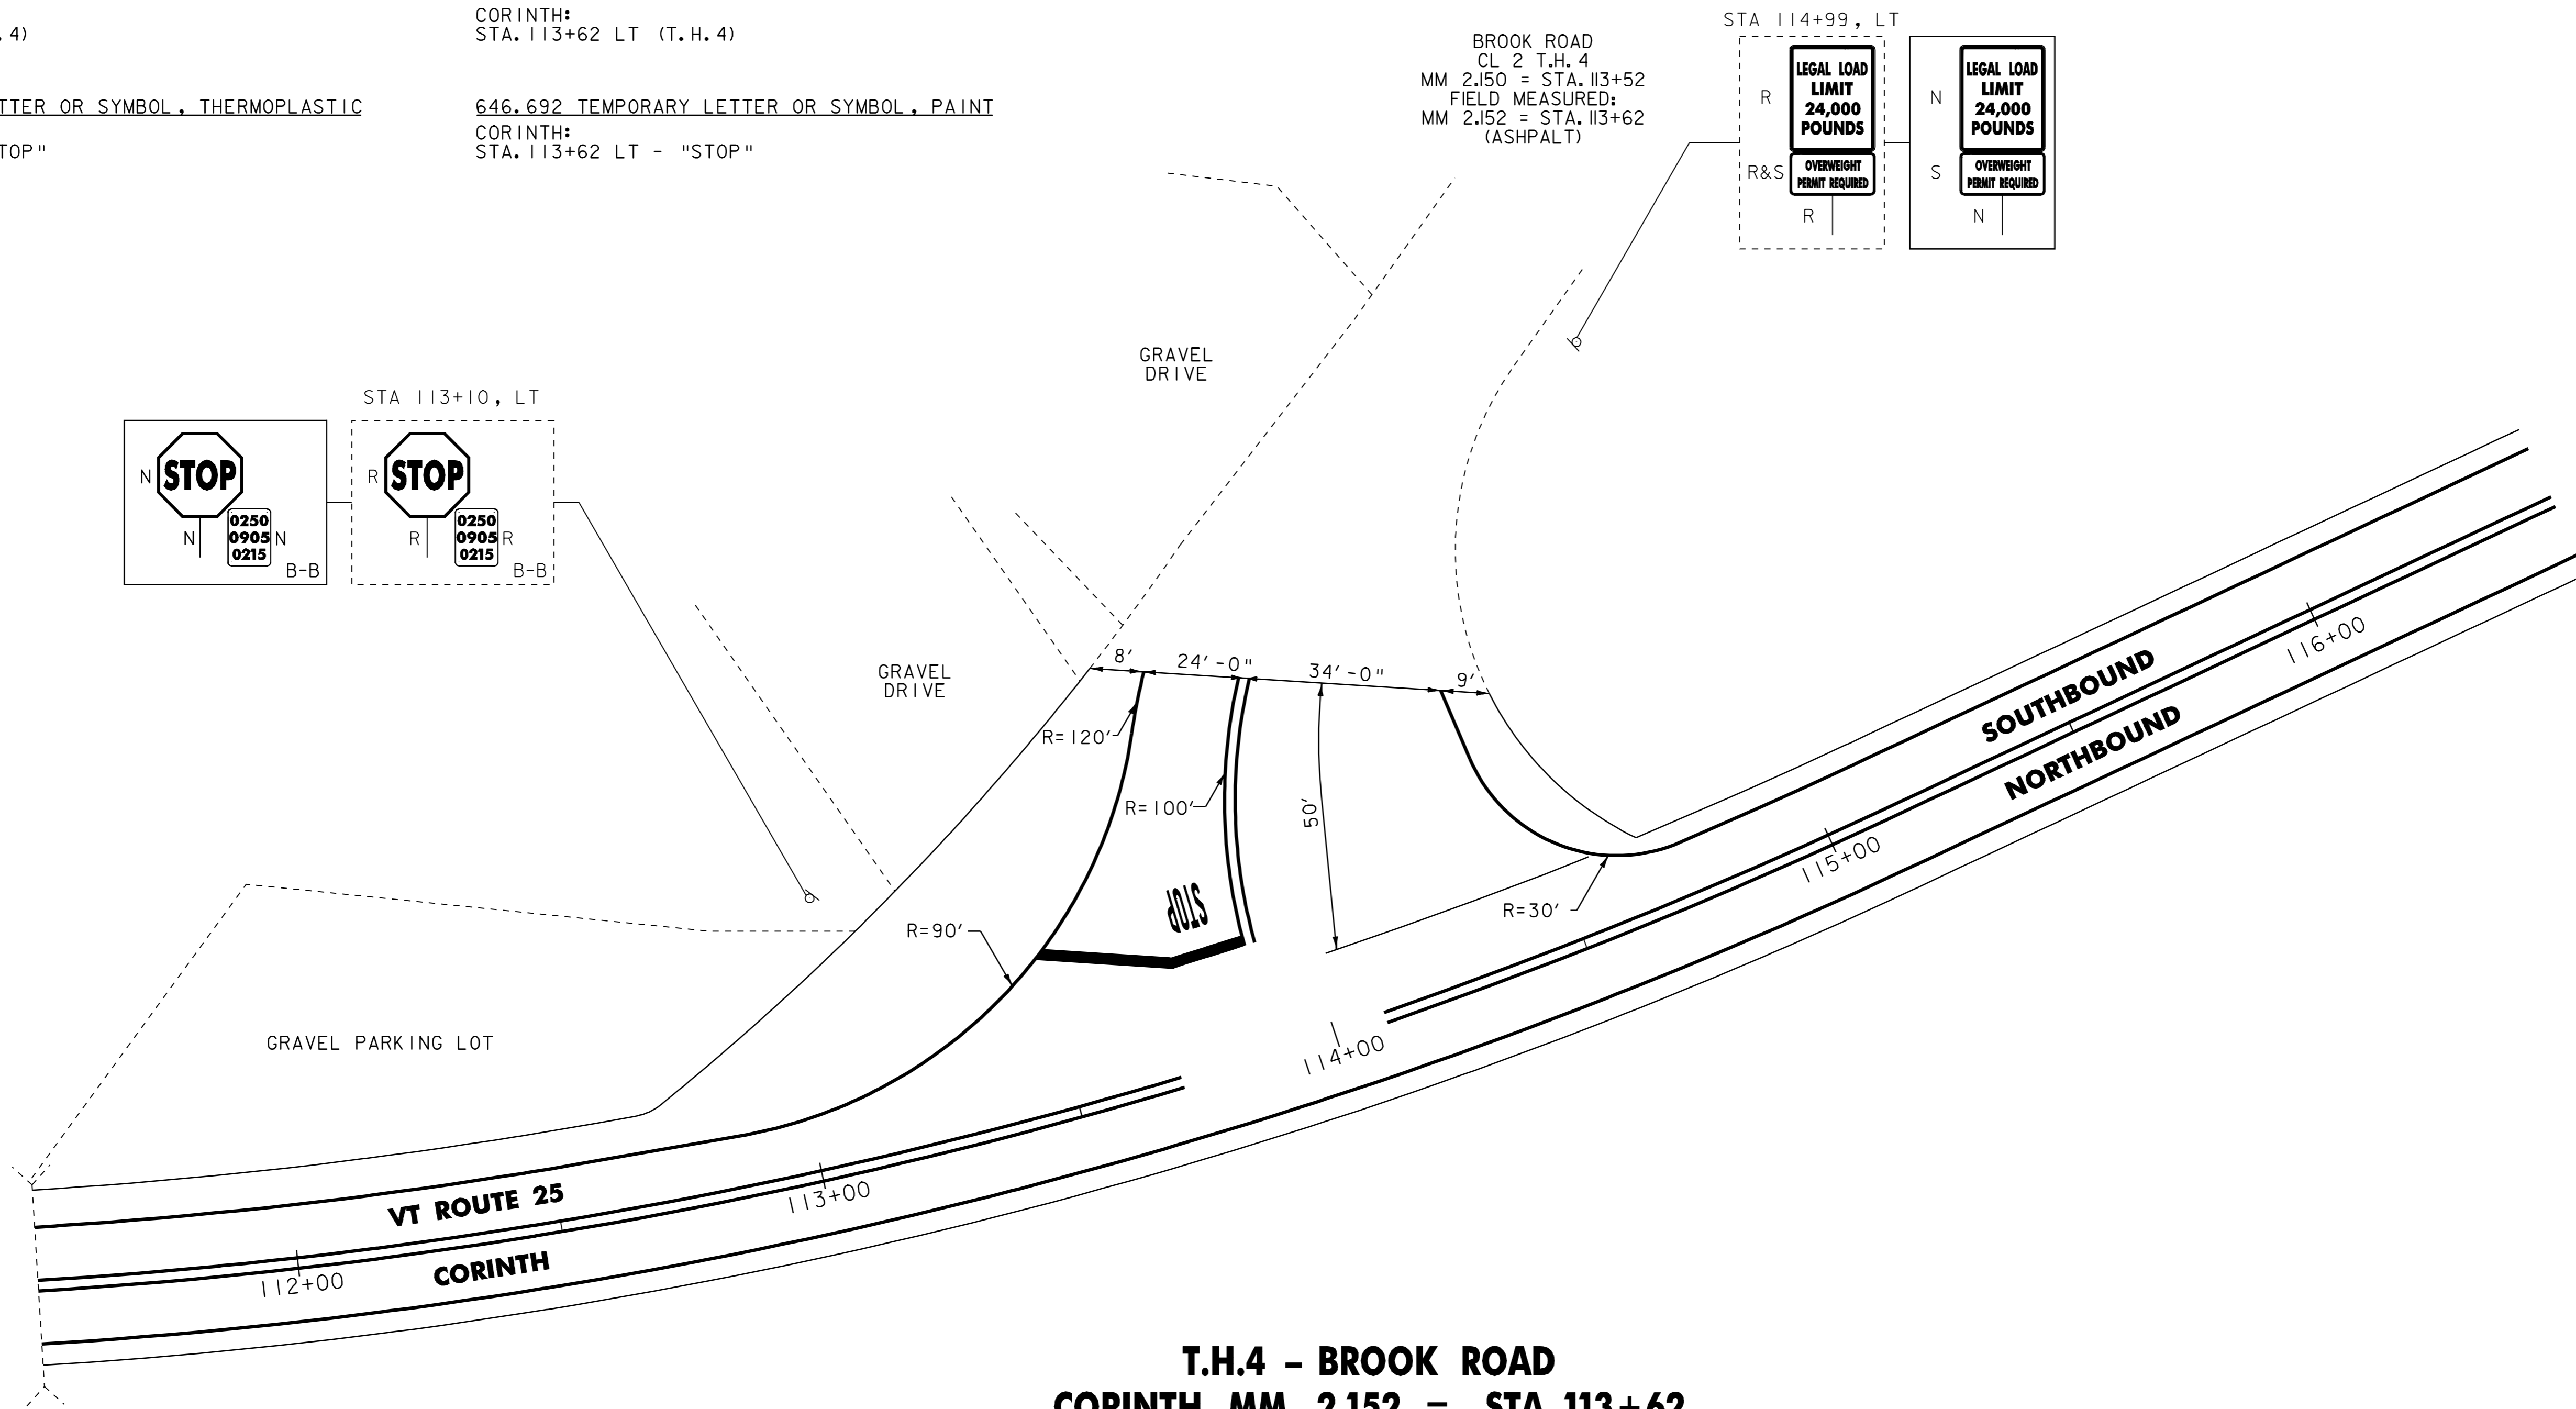

**T.H.4 - BROOK ROAD
 CORINTH MM 2.152 = STA. 113+62**

NOTE:

1. PAVING LIMIT ON ALL TOWN HIGHWAYS SHALL BE MEASURED 25 FT. BACK FROM VT ROUTE 25 EDGE OF SHOULDER UNLESS DENOTED OTHERWISE ON THE PLANS OR AS DIRECTED BY THE RESIDENT ENGINEER.

NOT TO SCALE

SIGN LEGEND
 R = REMOVE
 S = SALVAGE
 N = NEW
 RET = RETAIN
 B-B = BACK TO BACK
 EXISTING =
 NEW =



**INTERSECTION
 DETAIL SHEET
 NO. 3**

PROJECT NAME: BRADFORD - ORANGE	FILE NAME: p99b178.dgn	PLOT DATE: 28-MAY-2010 13:4
PROJECT NUMBER: STP 2213(I)	PROJECT LEADER: JLL	DRAWN BY: STANTEC
DESIGNED BY: STANTEC	CHECKED BY: JLL	SHEET 60 OF 84
IPARM FILE: z99b178int03.i		