

646.20  
~~646.402 DURABLE~~ 4 INCH WHITE LINE, THERMOPLASTIC  
 TOPSHAM:  
 STA. 299+52 DOUBLE SOLID RT (T.H.24)

646.21  
~~646.412 DURABLE~~ 4 INCH YELLOW LINE, THERMOPLASTIC  
 TOPSHAM:  
 STA. 299+52 DOUBLE SOLID RT (T.H.24)

646.26  
~~646.482 DURABLE~~ 24" STOP BAR, THERMOPLASTIC  
 TOPSHAM:  
 STA. 299+52 RT (T.H.24)

646.492 DURABLE LETTER OR SYMBOL, THERMOPLASTIC  
 TOPSHAM:  
 STA. 299+52 RT - "STOP"


646.602 TEMPORARY 4 INCH WHITE LINE, PAINT  
 TOPSHAM:  
 STA. 299+52 DOUBLE SOLID RT (T.H.24)

646.612 TEMPORARY 4 INCH YELLOW LINE, PAINT  
 TOPSHAM:  
 STA. 299+52 DOUBLE SOLID RT (T.H.24)

646.682 TEMPORARY 24" STOP BAR, PAINT  
 TOPSHAM:  
 STA. 299+52 RT (T.H.24)

646.692 TEMPORARY LETTER OR SYMBOL, PAINT  
 TOPSHAM:  
 STA. 299+52 RT - "STOP"

675.50 REMOVING SIGNS  
 AS SHOWN - 3

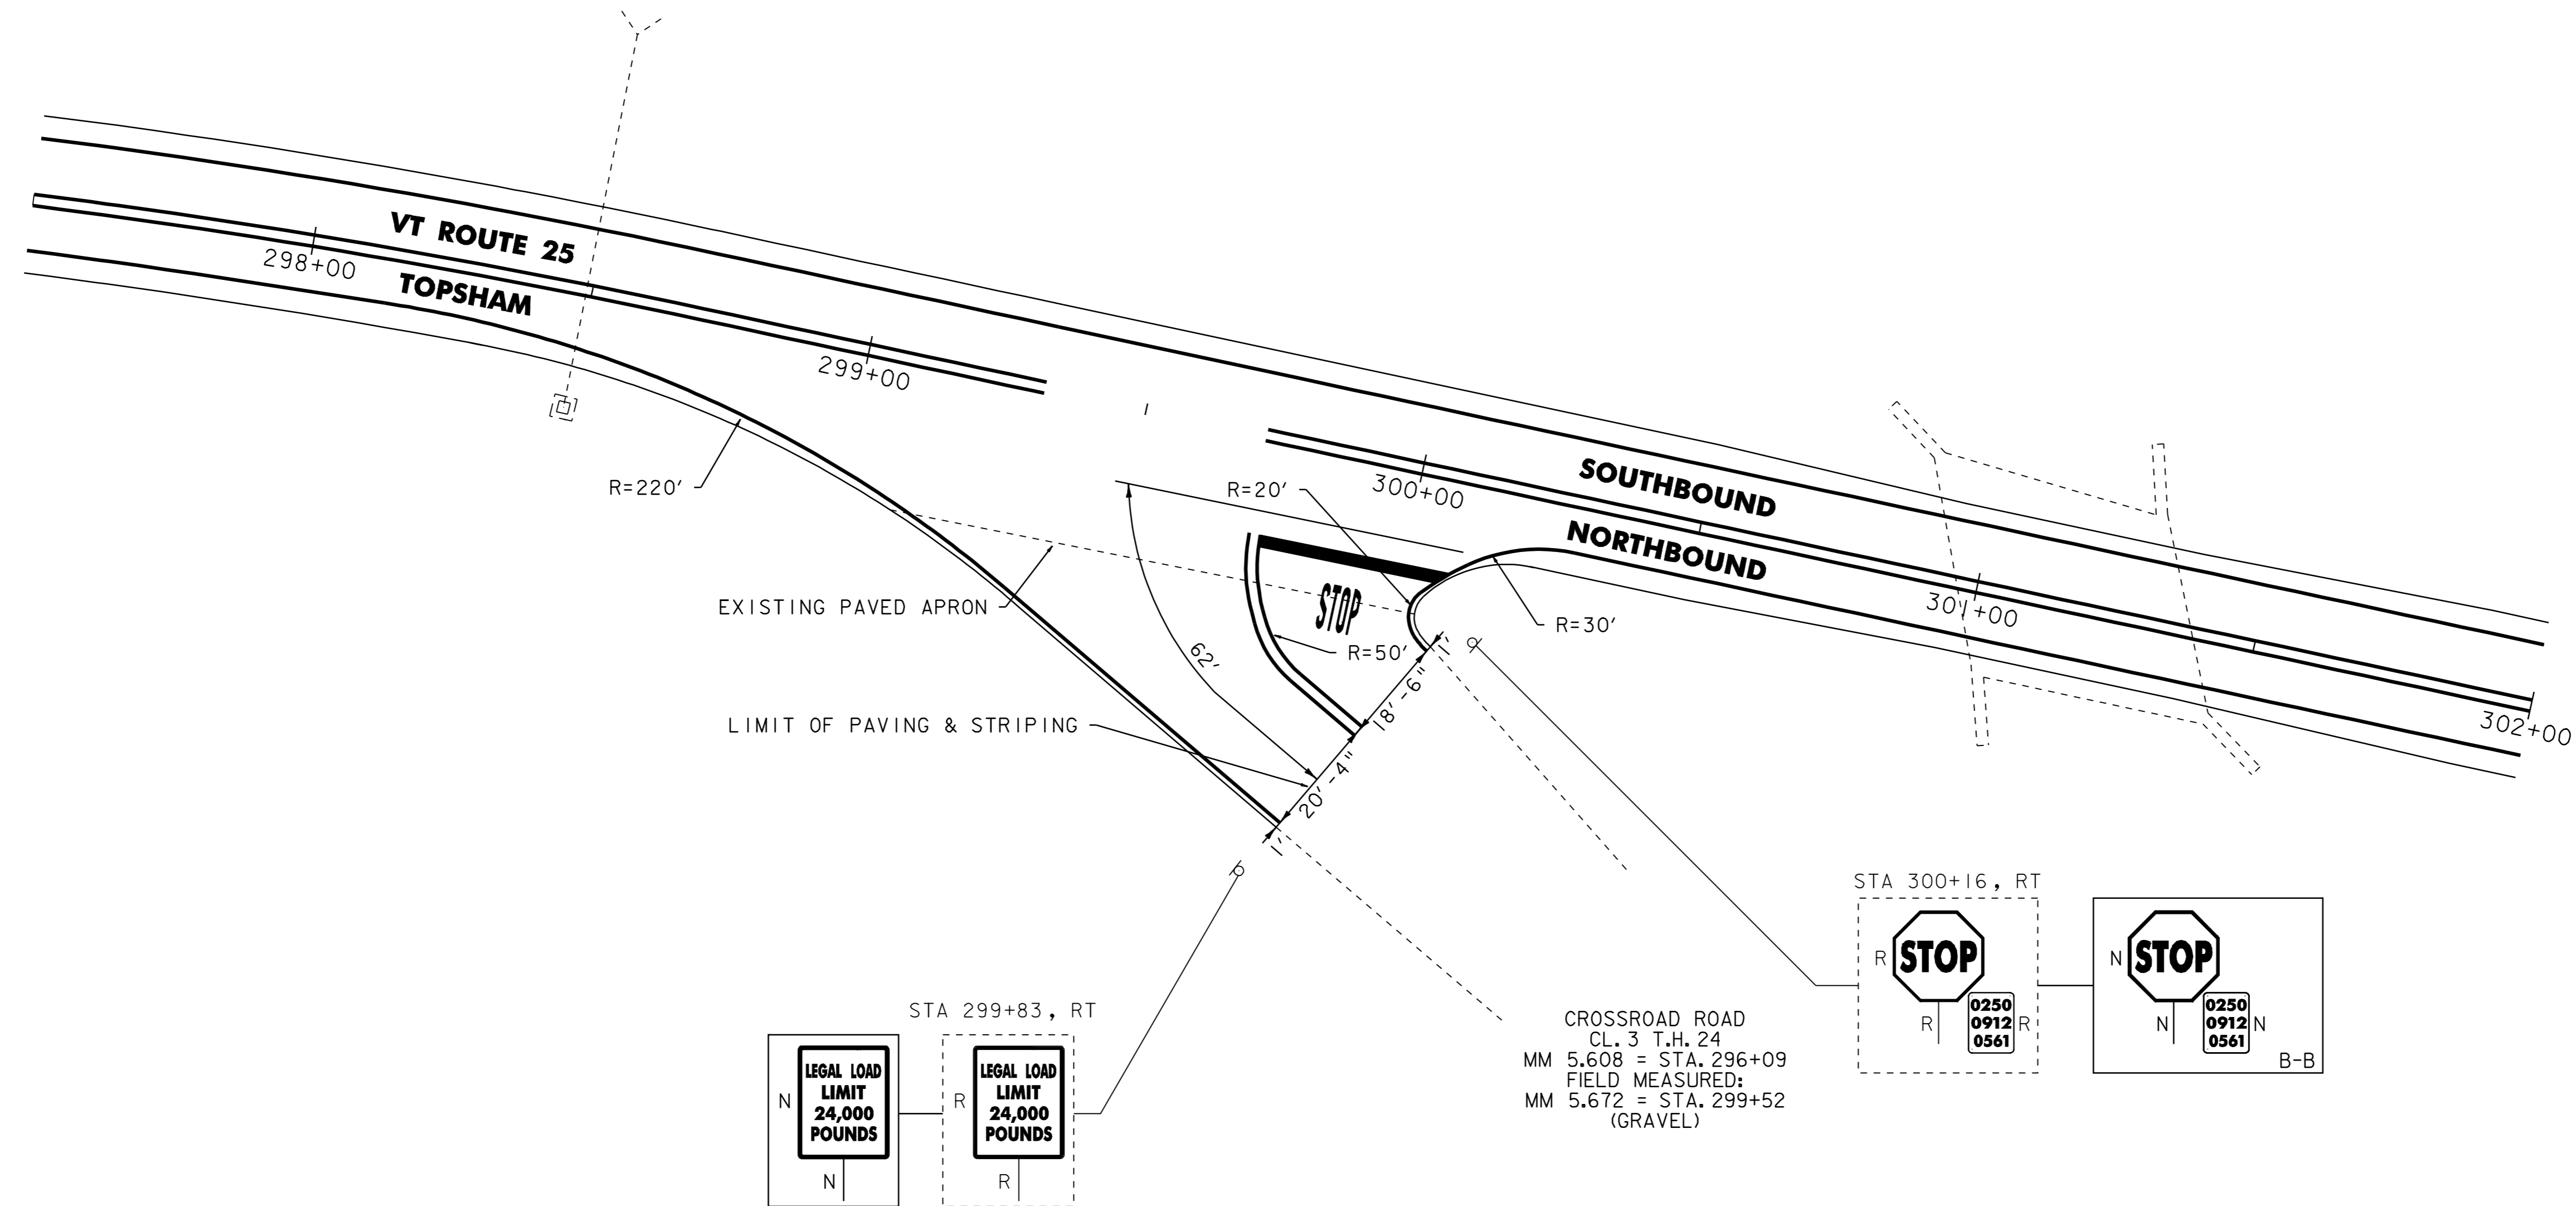

**T.H.24 - CROSSROAD ROAD  
 TOPSHAM MM 5.672 = STA. 299+52**

NOTE:

1. PAVING LIMIT ON ALL TOWN HIGHWAYS SHALL BE MEASURED 25 FT. BACK FROM VT ROUTE 25 EDGE OF SHOULDER UNLESS DENOTED OTHERWISE ON THE PLANS OR AS DIRECTED BY THE RESIDENT ENGINEER.

NOT TO SCALE

SIGN LEGEND  
 R = REMOVE  
 S = SALVAGE  
 N = NEW  
 RET = RETAIN  
 B-B = BACK TO BACK  
 EXISTING = \_\_\_\_\_  
 NEW = \_\_\_\_\_



**INTERSECTION  
 DETAIL SHEET  
 NO. 5**

|                                 |                        |                             |
|---------------------------------|------------------------|-----------------------------|
| PROJECT NAME: BRADFORD - ORANGE | FILE NAME: p99b178.dgn | PLOT DATE: 28-MAY-2010 13:4 |
| PROJECT NUMBER: STP 2213(I)     | PROJECT LEADER: JLL    | DRAWN BY: STANTEC           |
| DESIGNED BY: STANTEC            | CHECKED BY: JLL        |                             |
| IPARM FILE: z99b178int05.i      |                        | SHEET 62 OF 84              |