


DETAIL FOR PIPE PLACEMENT @ GUARD RAIL END TREATMENT LOCATION

CORINTH STA. 77+02.5, RT.
TOPSHAM STA. 275+10, RT.

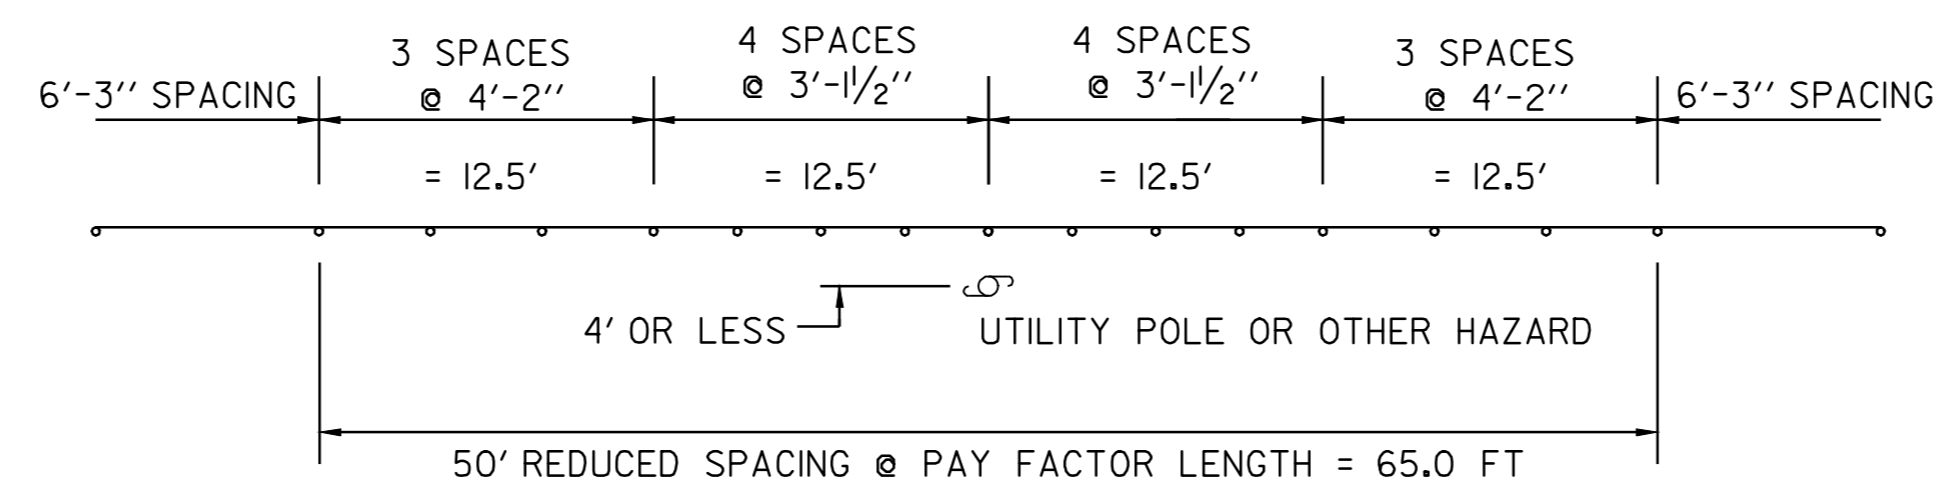

REDUCED GUARD RAIL POST SPACING DETAIL

OBJECTS WITHIN 4 FT OF GUARDRAIL (N.T.S.)

TOPSHAM STA. 51+80, LT - UTILITY POLE
TOPSHAM STA. 54+70, LT - UTILITY POLE



NOT TO SCALE

GUARD RAIL DETAIL SHEET

PROJECT NAME: BRADFORD - ORANGE

PROJECT NUMBER: STP 2213(I)

FILE NAME: p99b178.dgn

PLOT DATE: 28-MAY-2010 13:4

PROJECT LEADER: JLL

DRAWN BY: STANTEC

DESIGNED BY: STANTEC

CHECKED BY: JLL

IPARM FILE: p99b178gds.i

SHEET 72 OF 84