


MARKER POST LOCATIONS FOR CULVERTS (CROSS-PIPES ONLY)  
PAID AS ITEM 619.17, YEILDING MARKER POSTS

EACH STATION HAS 1 POST

- WILMINGTON STA.
- II+047 RT
  - II+050 LT
  - II+111 RT
  - II+115 LT
  - II+163 RT SOUTH OF GALLUP PITCH ROAD
  - II+168 LT SOUTH OF GALLUP PITCH ROAD
  - II+237 RT NORTH OF GALLUP PITCH ROAD
  - II+238 LT NORTH OF GALLUP PITCH ROAD
  - II+335 RT
  - II+337 LT
  - II+403 LT
  - II+470 RT
  - II+472 LT
  - II+503 RT
  - II+507 LT
  - II+551 RT
  - II+555 LT
  - II+616 RT
  - II+619 LT
  - II+653 RT
  - II+661 LT
  - II+701 RT
  - II+703 LT
  - II+737 RT
  - II+739 LT
  - II+403 RT

STOP SIGN AND LLL SIGN  
WERE IN GOOD CONDITION -  
NOT REPLACED

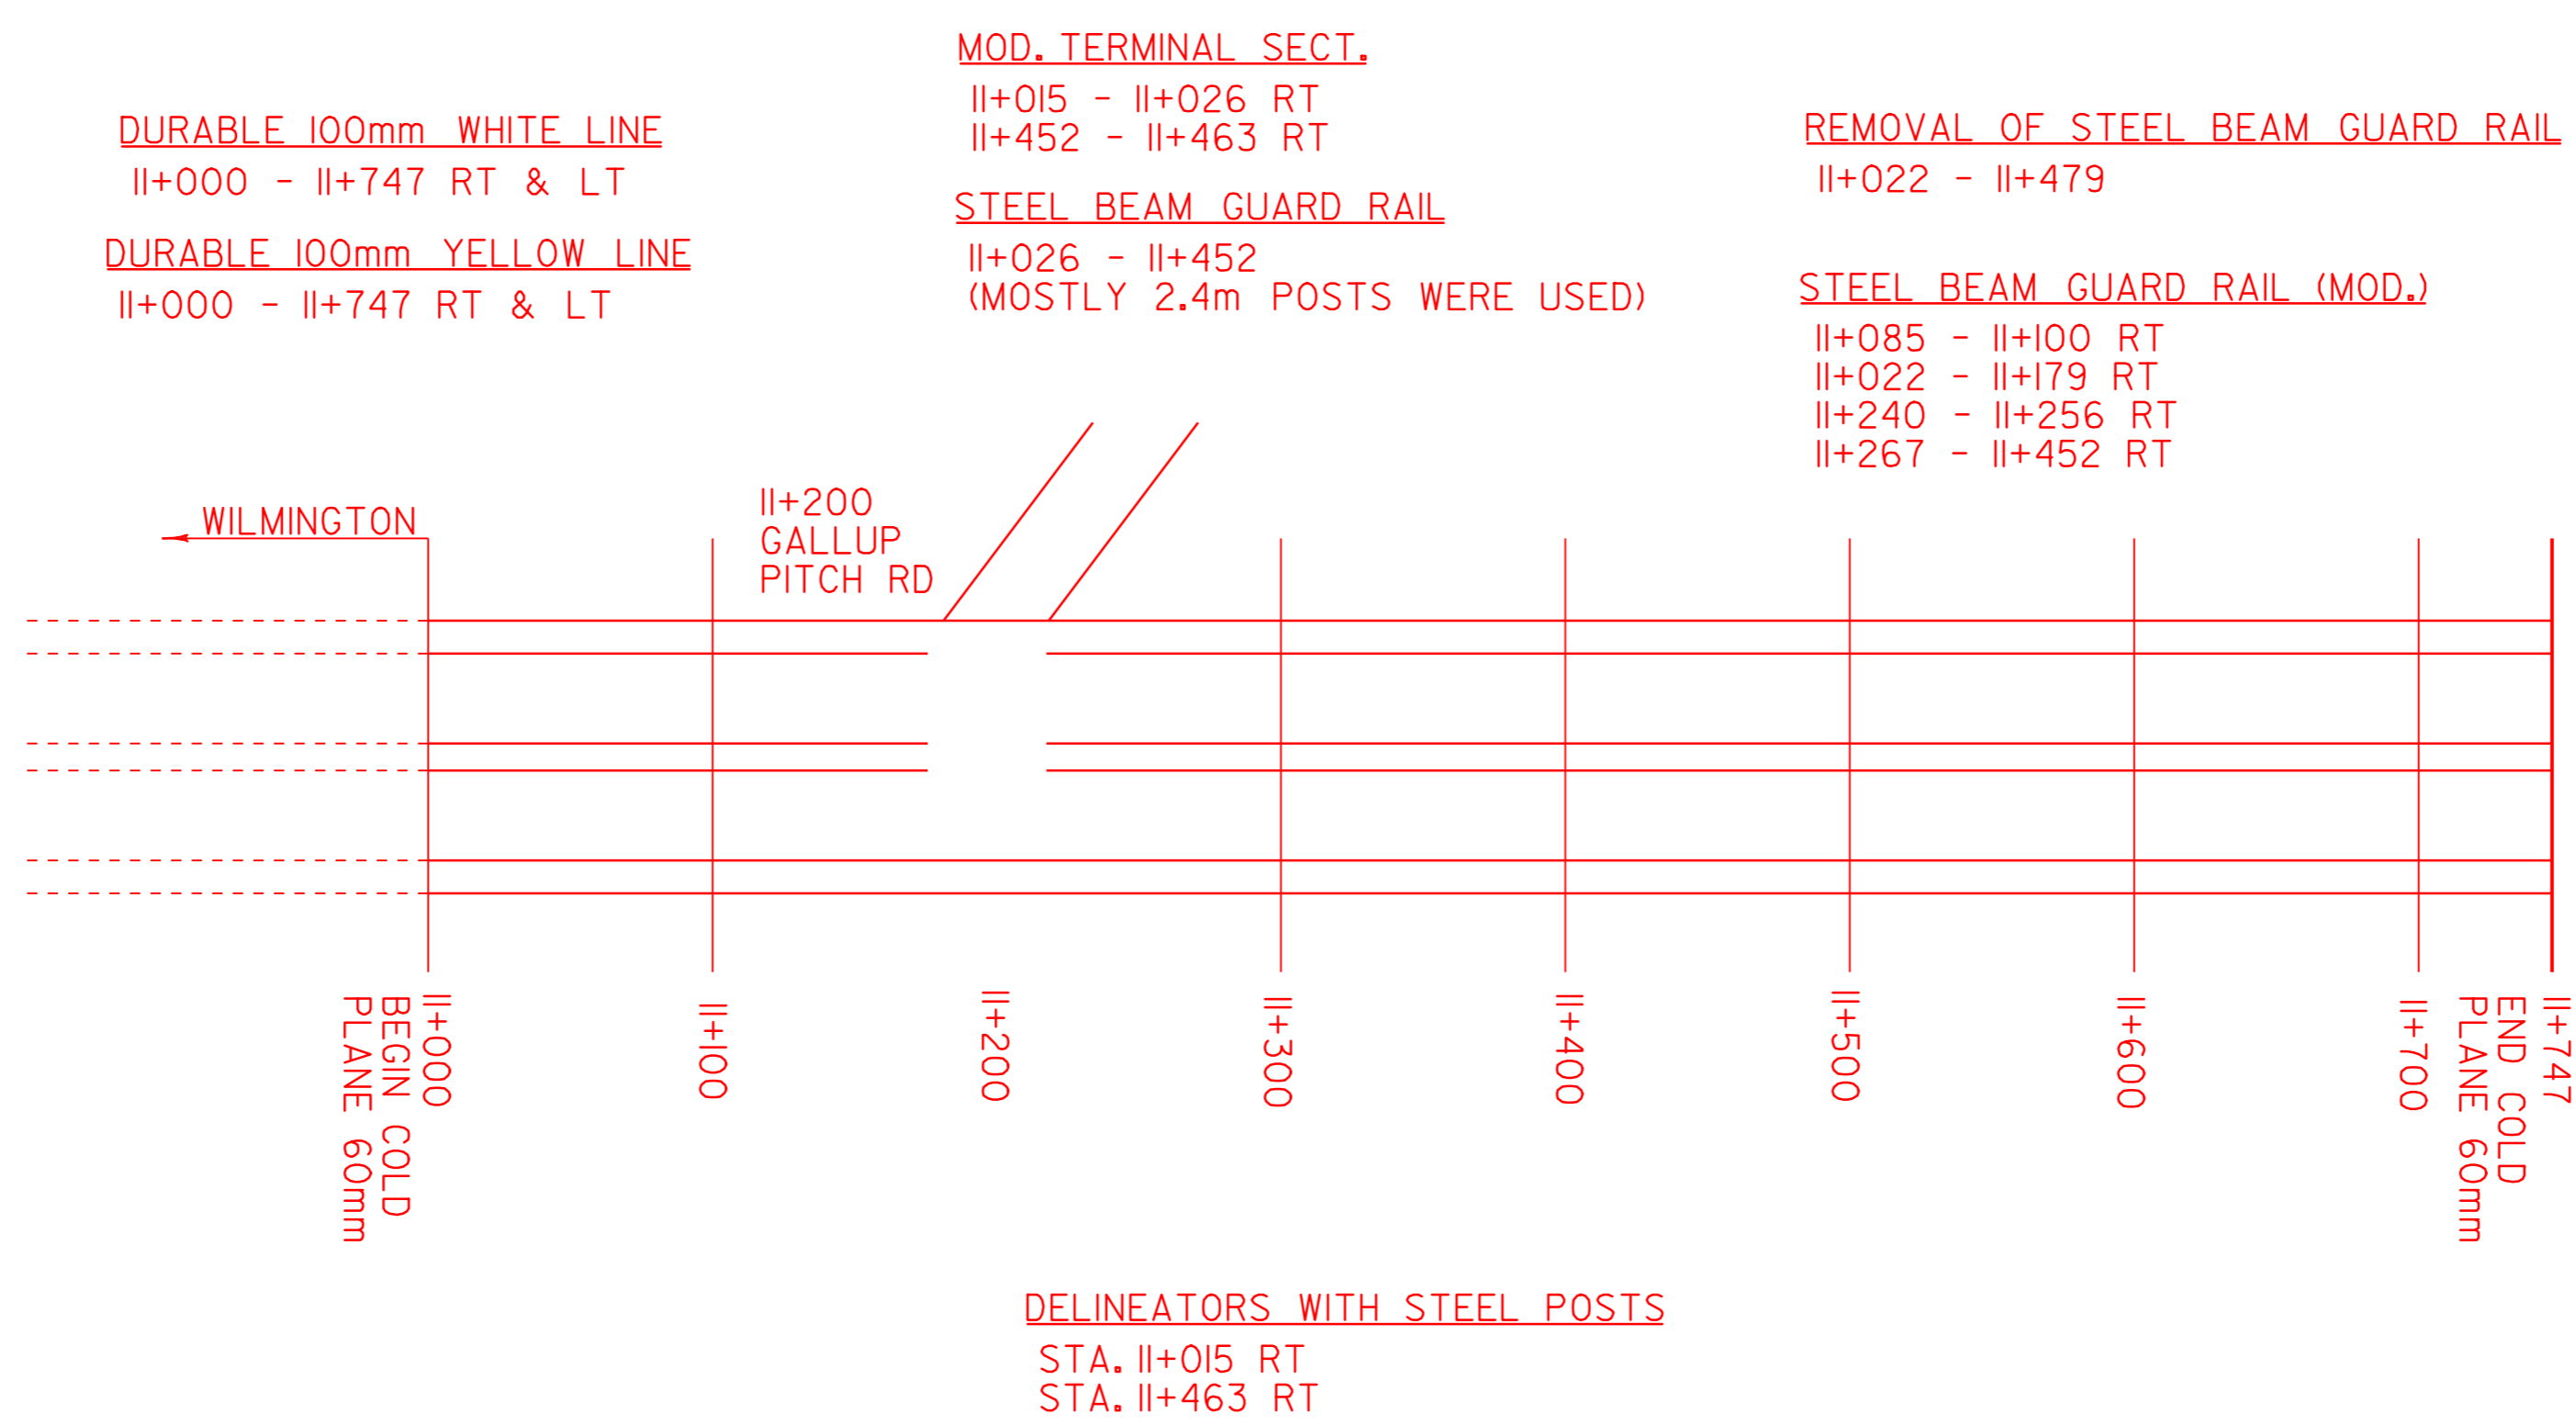

PLEASE NOTE:  
THIS SECTION OF ROAD WAS NOT  
STRAIGHT IT WAS ONLY DRAWN AS  
SUCH FOR PURPOSES OF SIMPLIFICATION

NOT TO SCALE

NOTE: ALL DIMENSIONS IN METERS EXCEPT AS INDICATED

<b>DATUM</b>	
VERTICAL	N/A
HORIZONTAL	N/A

PROJECT: <b>DOVER-STRATTON</b>	PROJECT NO.: <b>STP 2214(I)S</b>
DESIGN FILE NAME: /pave/99bl80/pbl80.dgn IPARM FILE NAME: pbl80i01.i	PLOT DATE: 24-MAY-2007 1 SURVEY DATE: 5/00 DRAWN BY: J GILMORE SHEET: 9A OF 49