

TEMPORARY AND DURABLE 100 mm YELLOW LINE
 STA 0+600 TO 1+200 SOLID LT & RT

TEMPORARY AND DURABLE 100 mm WHITE LINE
 STA 0+600 TO 1+200 SOLID LT
 STA 0+600 TO 1+200 SOLID RT


STEEL BEAM GUARDRAIL (2.4 m POST)(MOD)
 STA 0+600 TO 0+827 RT
 STA 0+750 TO 0+782 RT (UTILITY POLE)
 REMOVAL & DISPOSAL OF GUARDRAIL (FACTORED SPACING)
 STA 0+600 TO 0+827 RT
 ANCHOR FOR STEEL BEAM RAIL
 STA 0+827 RT

REHABILITATION OF DI, CB OR MH, CLASS I
 STA 1+187 RT
 STA 0+693 LT - 2 EA (2 GRATES)
 CHANGING ELEVATION OF SMH
 STA 0+682 LT
 STA 0+695 LT
 STA 0+829 LT
 STA 0+788 LT
 STA 0+887 LT

STEEL BEAM GUARDRAIL
 STA. 0+600 TO 0+674 RT
 STA. 0+681 TO 0+750 RT
 STA. 0+782 TO 0+827 RT

DELINEATORS WITH STEEL POSTS
 STA. 0+827 RT

YIELDING MARKER POSTS
 STA. 0+689 RT
 STA. 0+777 LT
 STA. 0+873 RT
 STA. 0+874 LT
 STA. 1+085 LT
 STA. 1+085 RT
 STA. 1+129 LT
 STA. 1+168 RT
 STA. 1+178 LT

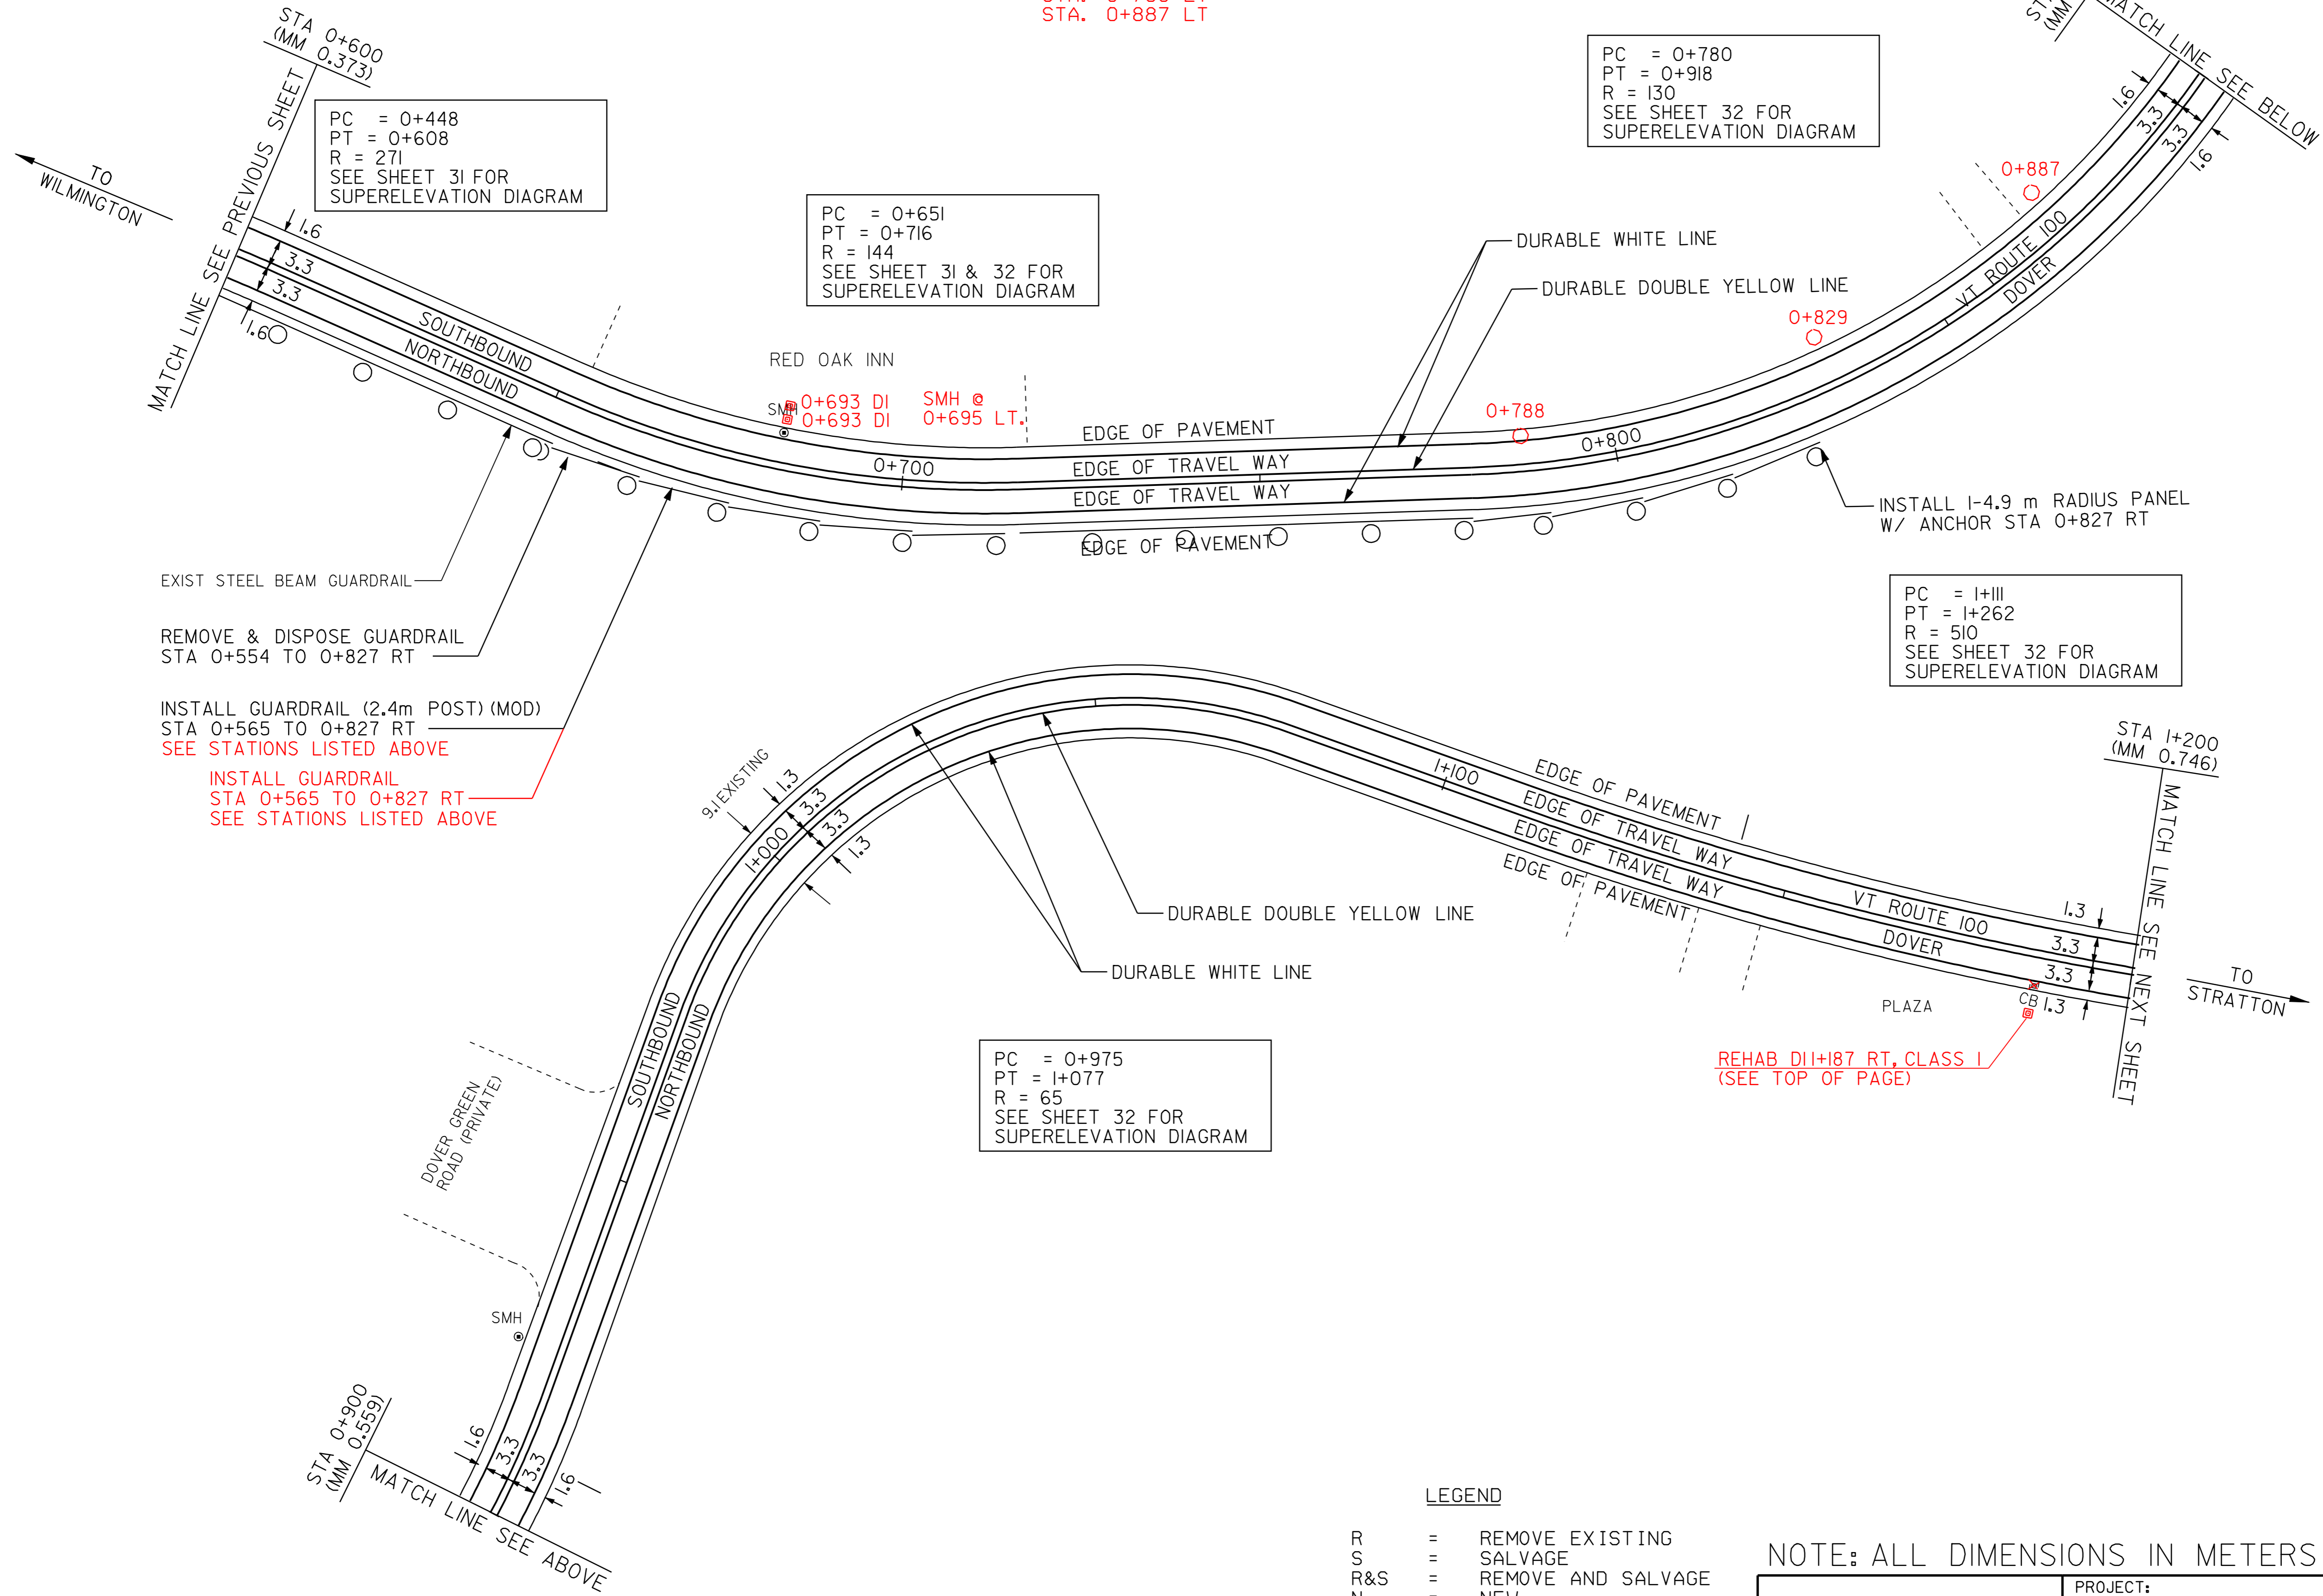

PC = 0+448
 PT = 0+608
 R = 271
 SEE SHEET 31 FOR SUPERELEVATION DIAGRAM

PC = 0+651
 PT = 0+716
 R = 144
 SEE SHEET 31 & 32 FOR SUPERELEVATION DIAGRAM

PC = 0+780
 PT = 0+918
 R = 130
 SEE SHEET 32 FOR SUPERELEVATION DIAGRAM

PC = 1+111
 PT = 1+262
 R = 510
 SEE SHEET 32 FOR SUPERELEVATION DIAGRAM

PC = 0+975
 PT = 1+077
 R = 65
 SEE SHEET 32 FOR SUPERELEVATION DIAGRAM

EXIST STEEL BEAM GUARDRAIL
 REMOVE & DISPOSE GUARDRAIL
 STA 0+554 TO 0+827 RT
 INSTALL GUARDRAIL (2.4m POST)(MOD)
 STA 0+565 TO 0+827 RT
 SEE STATIONS LISTED ABOVE
 INSTALL GUARDRAIL
 STA 0+565 TO 0+827 RT
 SEE STATIONS LISTED ABOVE

REHAB DI+187 RT, CLASS I
 (SEE TOP OF PAGE)

INSTALL 1-4.9 m RADIUS PANEL
 W/ ANCHOR STA 0+827 RT

- LEGEND
- R = REMOVE EXISTING
 - S = SALVAGE
 - R&S = REMOVE AND SALVAGE
 - N = NEW
 - RET = RETAIN
 - B-B = BACK TO BACK
 - = NEW RAIL
 - - - = EXISTING RAIL
 - ⊗ = BORING LOCATION

NOTE: ALL DIMENSIONS IN METERS EXCEPT AS INDICATED

DATUM

VERTICAL	N/A
HORIZONTAL	N/A

NOT TO SCALE

PAVING PROJECT LAYOUT #2	PROJECT:	DOVER-STRATTON	PROJECT NO.:	STP 2214(I)S
	DESIGN FILE NAME:	/pave/99bl80/pbl80.dgn		
	IPARM FILE NAME:	pbl80i02.i		
	SURVEYED BY:	CLD ENGINEERS, INC		
SQUAD LEADER:	WRH			PLOT DATE: 24-MAY-2007
				SURVEY DATE: 5/00
				DRAWN BY: MPS
				SHEET: II OF 49