

TEMPORARY AND DURABLE 100 mm YELLOW LINE
 STA 1+500 TO 1+583 SOLID LT & RT
 STA 1+595 TO 1+769 SOLID LT & RT
 STA 1+775 DOUBLE SOLID LT (TH #9)
 STA 1+775 DOULBE SOLID RT (TH #15)
 STA 1+781 TO 1+800 SOLID LT & RT

TEMPORARY AND DURABLE 100 mm WHITE LINE
 STA 1+500 TO 1+772 SOLID LT
 STA 1+500 TO 1+577 SOLID RT
 STA 1+601 TO 1+772 SOLID RT
 STA 1+778 TO 1+800 SOLID LT
 STA 1+778 TO 1+800 SOLID RT

TEMPORARY AND DURABLE 600 mm STOP BAR
 STA 1+775 LT (TH #9)
 STA 1+775 RT (TH #15)

TEMPORARY AND DURABLE LETTER OR SYMBOL
 STA 1+775 LT - "STOP" (TH #9)
 STA 1+775 RT - "STOP" (TH #15)

STEEL BEAM GUARDRAIL
 STA 1+686 TO 1+771 LT
 STA 1+779 TO 1+800 LT

REMOVAL & DISPOSAL OF GUARDRAIL
 STA 1+762 TO 1+771 LT
 STA 1+779 TO 1+800 LT

REMOVAL & DISPOSAL OF GUIDE POSTS
 STA 1+730 TO 1+748 LT (4)

HEAVY DUTY STEEL BEAM GUARDRAIL
 T.H. #9 STA 1+771 LT (10M)
 T.H. #9 STA 1+779 LT (10M)

STEEL BEAM GUARDRAIL (2.4m POSTS) (MOD.)
 STA. 1+686 TO 1+755 LT

DELINEATORS WITH STEEL POSTS
 STA. 1+686 LT
 STA. 1+762 LT
 STA. 1+788 LT

REHABILITATING
CHANGING ELEV. OF DI, CB OR MH, CLASS

~~STA 1+539 RT~~
 STA 1+628 RT
 STA 1+716 RT
 STA 1+765 RT


ANCHOR FOR STEEL BEAM RAIL
 STA 1+686 LT
 STA 1+762 LT
 STA 1+788 LT

CHANGING ELEV. OF SMH
~~STA 1+593 RT (IN TH 35)~~
 STA. 1+524 RT
 STA. 1+728 RT
 STA. 1+794 RT (IN TH 15)

REMOVING SIGNS
 AS SHOWN - 8

ERECTING SALVAGED SIGNS
 AS SHOWN - 5

YIELDING MARKER POSTS
 STA. 1+721 LT
 STA. 1+770 RT
 STA. 1+772 LT

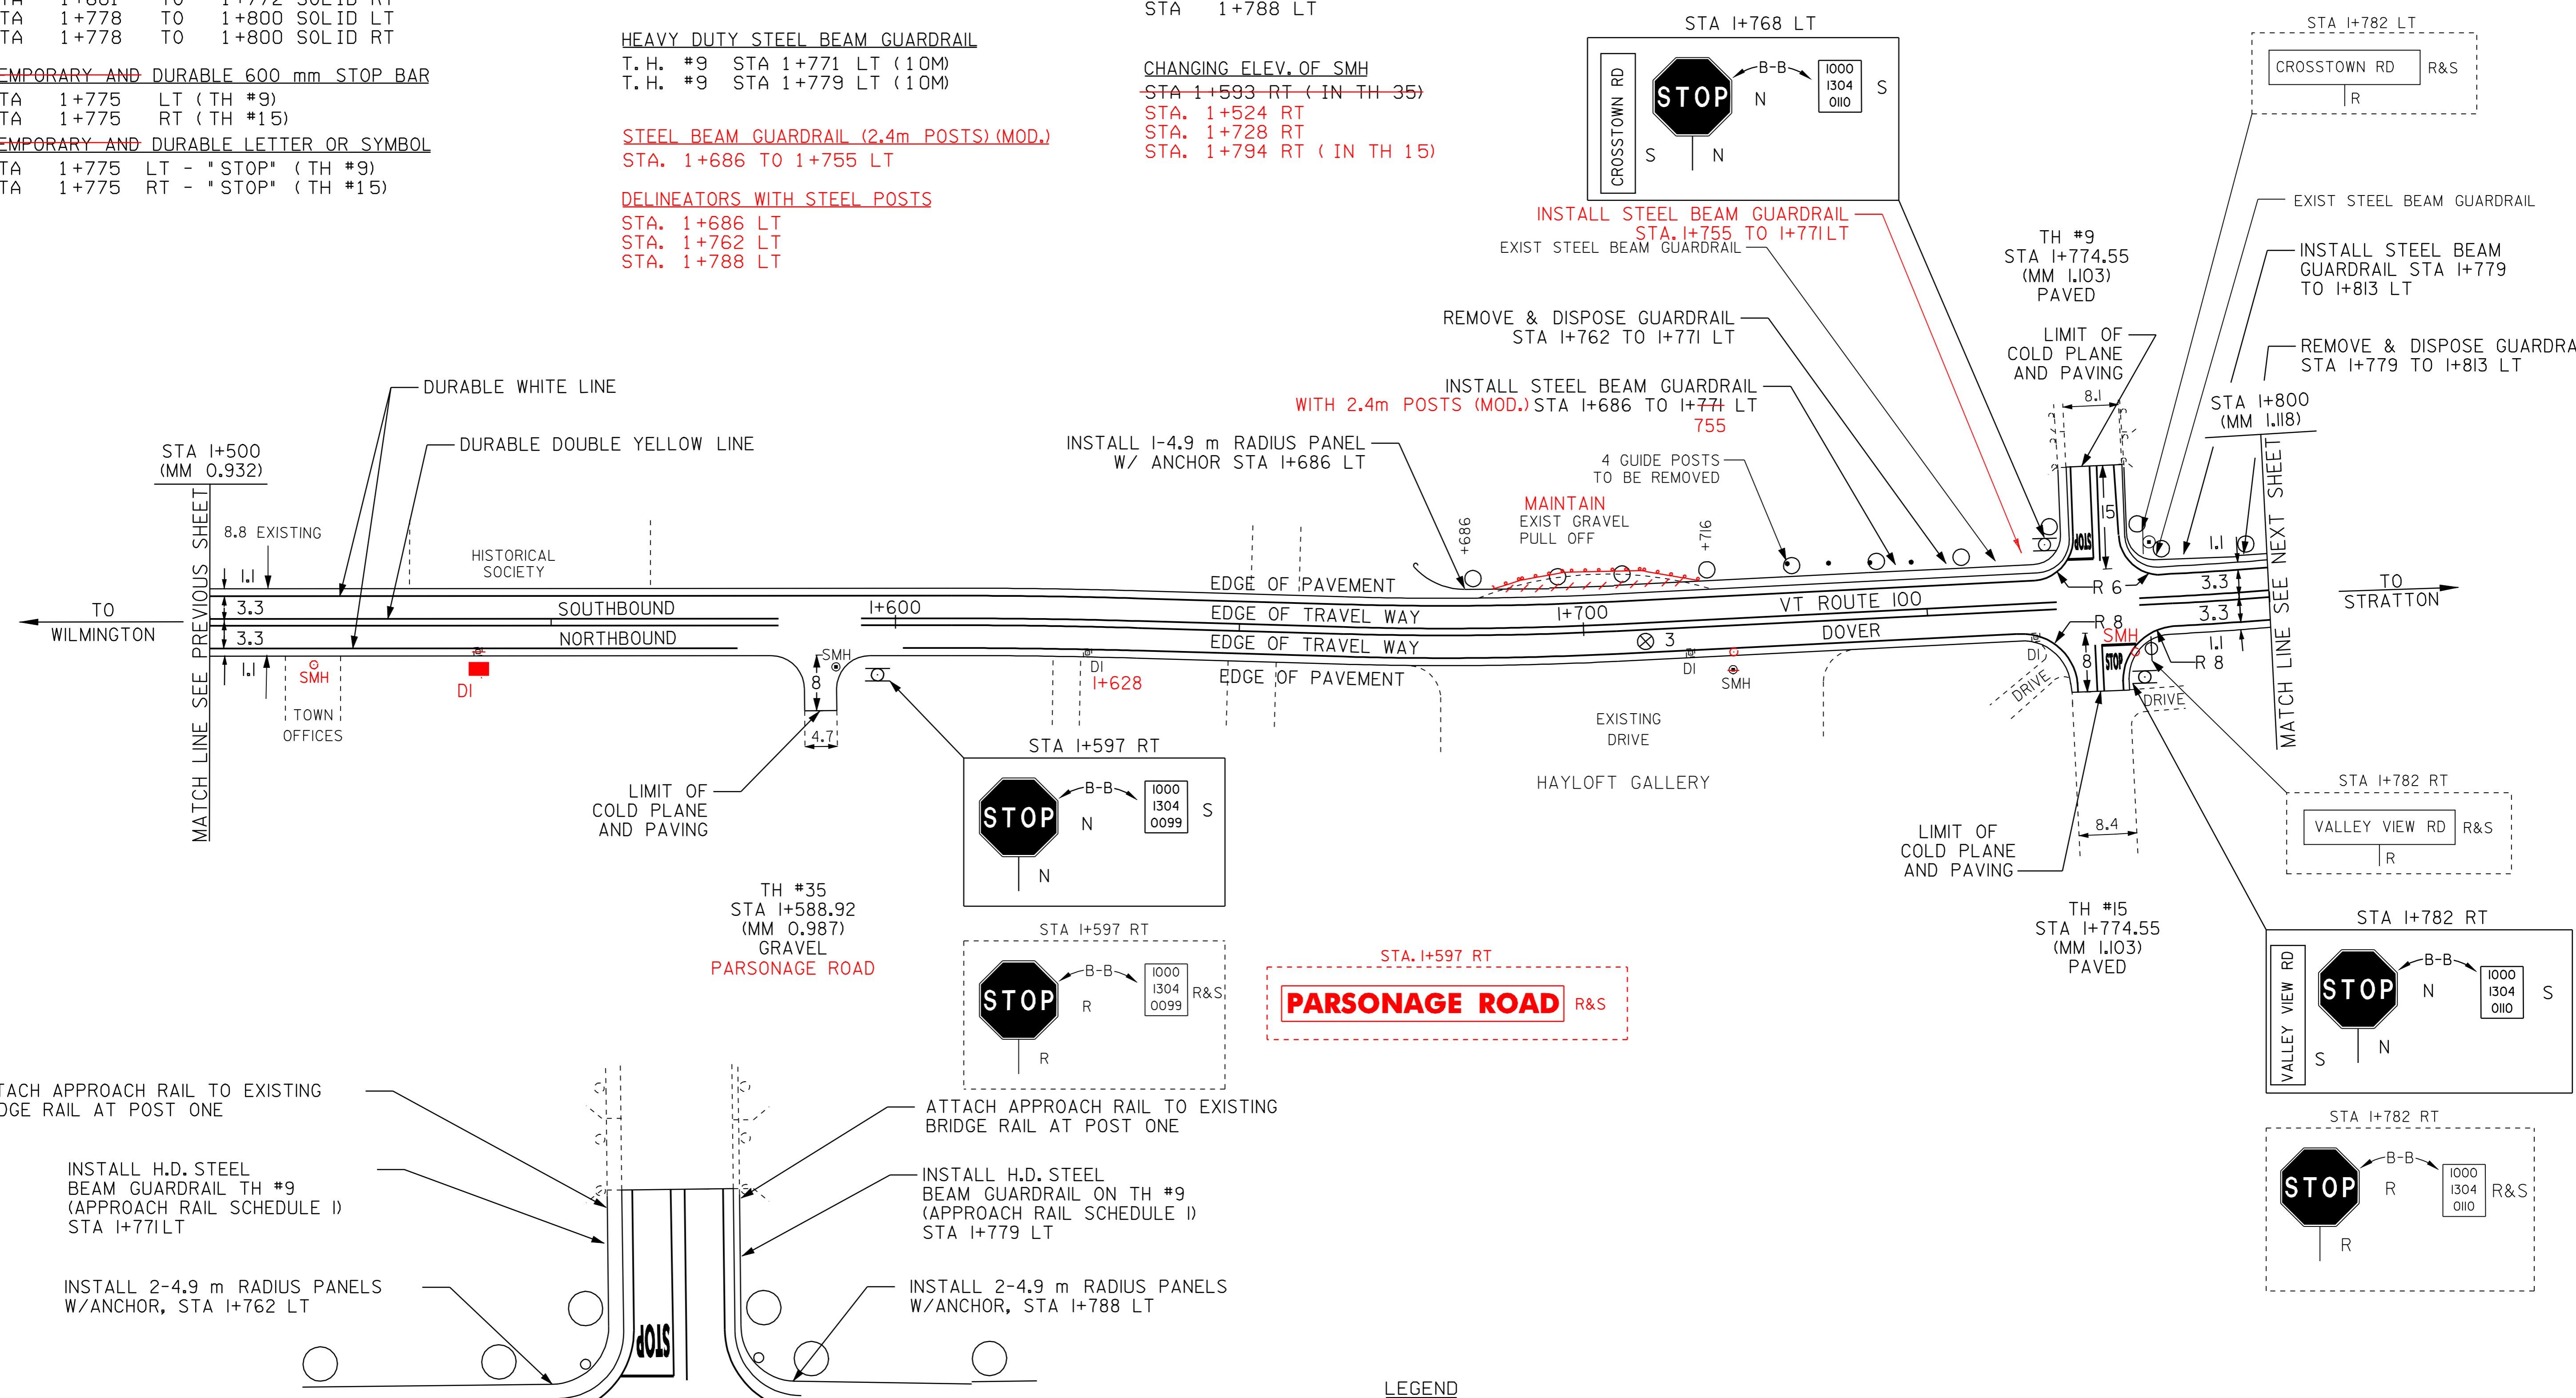

DETAIL OF GUARDRAIL ON TH #9

| DATUM | STA | TOTAL DEPTH (MM) | PCC |
|------------|----------------|------------------|-----|
| VERTICAL | N/A | | |
| HORIZONTAL | N/A | | |
| | 3 STA 1+709 RT | 140 | N0 |

NOT TO SCALE

- LEGEND**
- R = REMOVE EXISTING
 - S = SALVAGE
 - R&S = REMOVE AND SALVAGE
 - N = NEW
 - RET = RETAIN
 - B-B = BACK TO BACK
 - = NEW RAIL
 - - - = EXISTING RAIL
 - ⊗ = BORING LOCATION

NOTE: ALL DIMENSIONS IN METERS EXCEPT AS INDICATED

| | | |
|---------------------------------|--|---------------------------|
| PAVING PROJECT LAYOUT #4 | PROJECT: DOVER-STRATTON | PROJECT NO.: STP 2214(I)S |
| | DESIGN FILE NAME: /pave/99bl80/pbl80.dgn | PLOT DATE: 24-MAY-2007 |
| | IPARM FILE NAME: pbl80i04.i | SURVEY DATE: 5/00 |
| | SURVEYED BY: CLD ENGINEERS, INC | DRAWN BY: MPS |
| | SQUAD LEADER: WRH | SHEET: 13 OF 49 |