

TEMPORARY AND DURABLE 100 mm YELLOW LINE
 STA 1+800 TO 2+400 SOLID LT & RT

STEEL BEAM GUARDRAIL
 STA 1+800 TO 1+813 LT



ANCHOR FOR STEEL BEAM RAIL
 STA 1+813 LT

YIELDING MARKER POSTS
 STA. 1+896 RT
 STA. 1+900 LT
 STA. 1+953 RT
 STA. 1+954 LT
 STA. 2+034 RT
 STA. 2+036 LT
 STA. 2+102 LT
 STA. 2+104 RT

TEMPORARY AND DURABLE 100 mm WHITE LINE
 STA 1+800 TO 2+400 SOLID LT
 STA 1+800 TO 2+400 SOLID RT

REMOVAL & DISPOSAL OF GUARDRAIL
 STA 1+800 TO 1+813 LT

DELINEATORS WITH STEEL POSTS
 STA. 1+813 LT

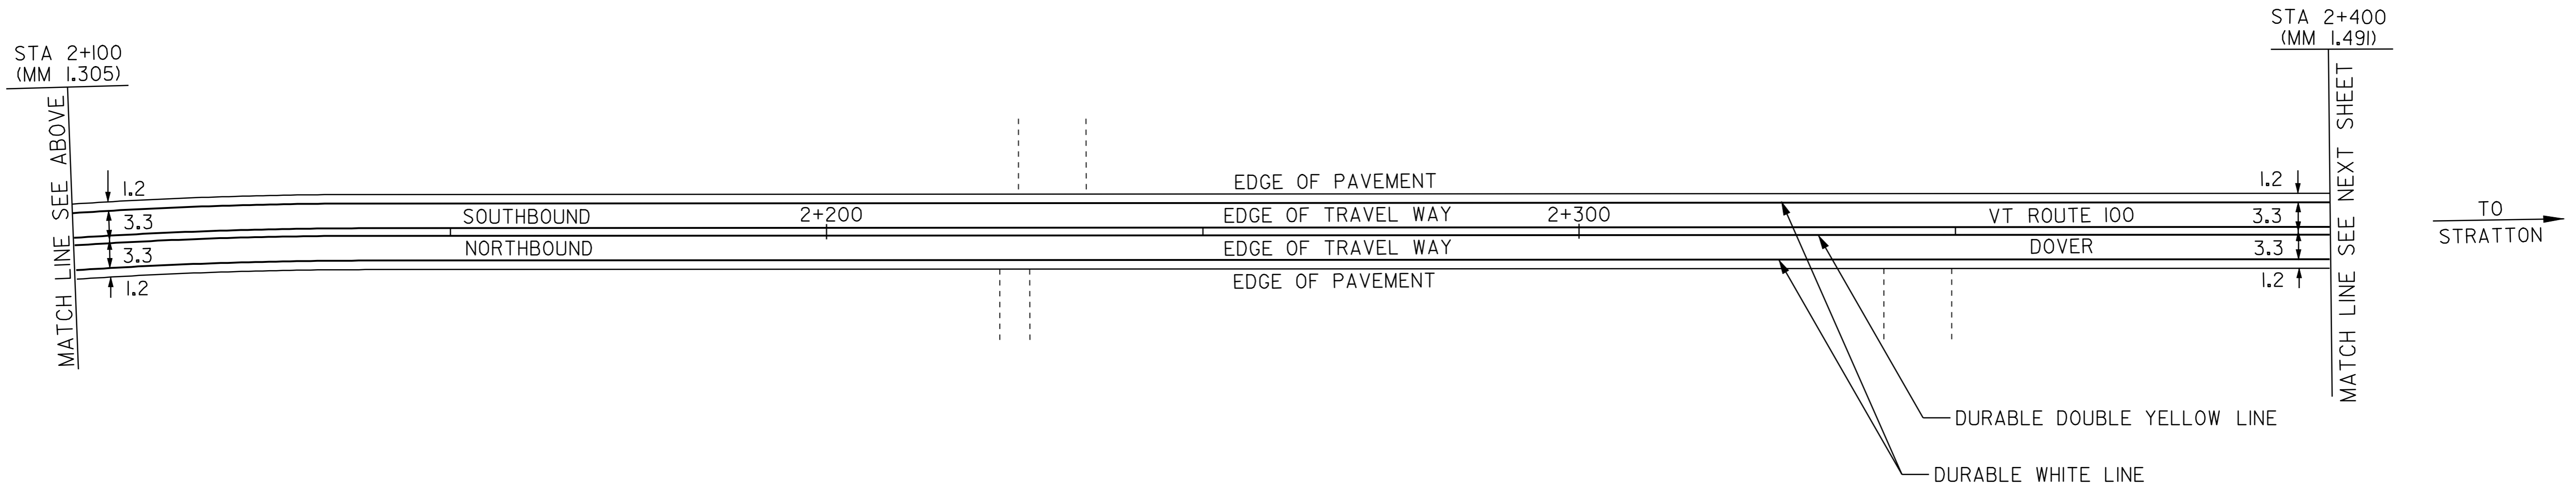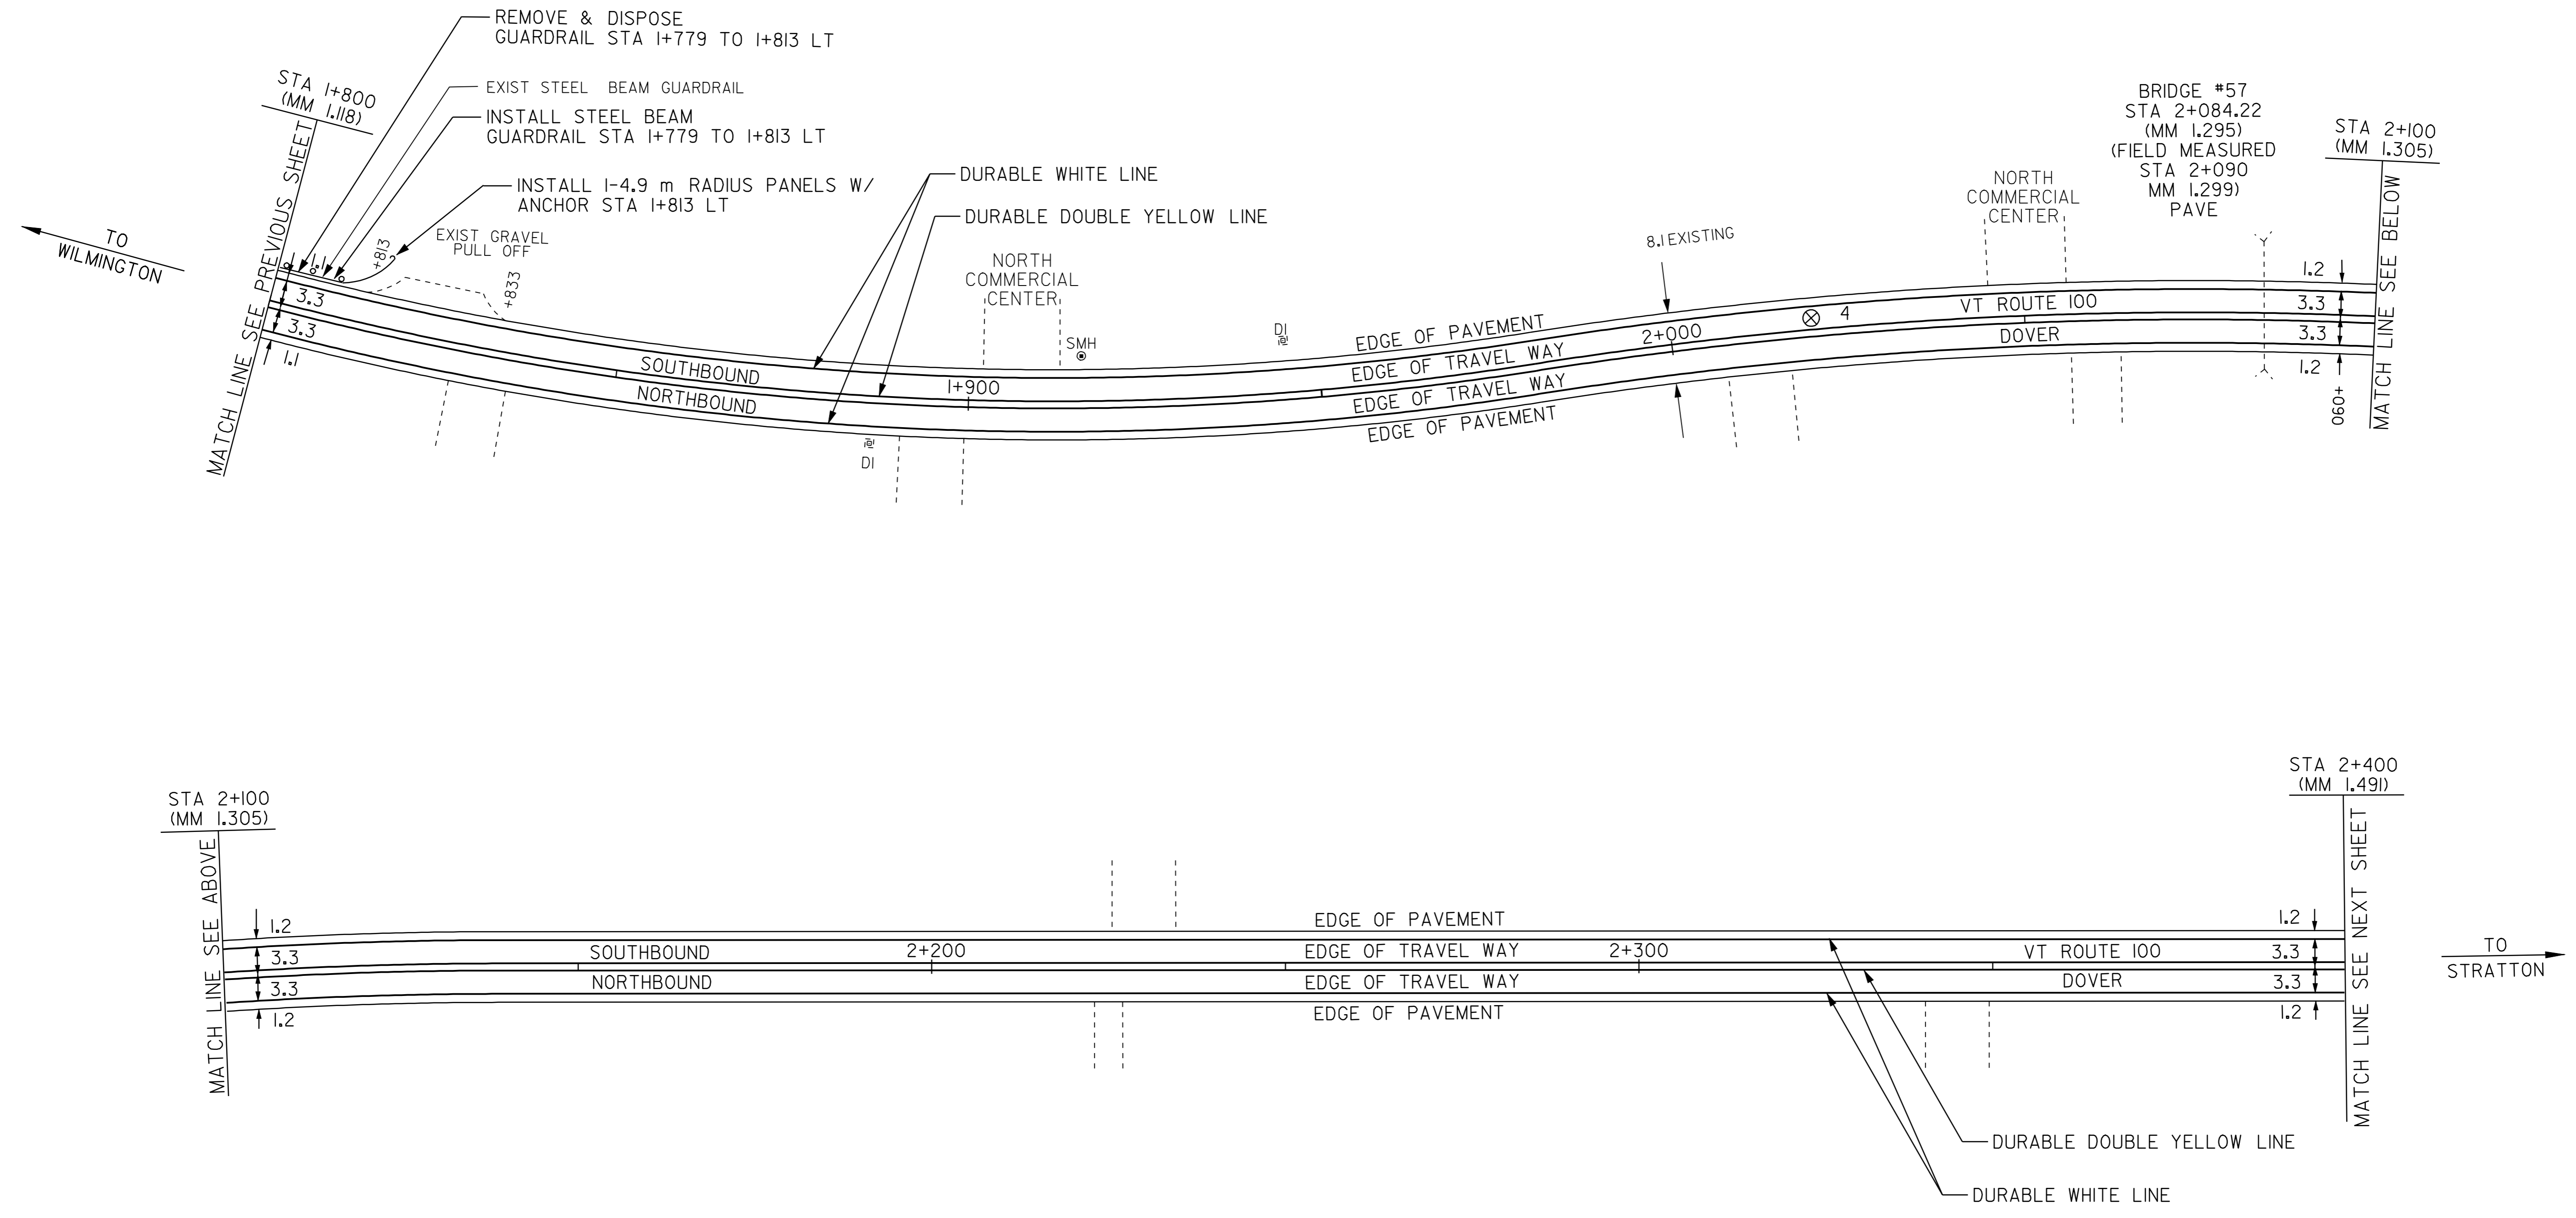

DATUM	STA	TOTAL DEPTH (MM)	PCC
VERTICAL	N/A		
HORIZONTAL	N/A		
PAVEMENT CORES	4 STA 2+020 LT 203		NO

- LEGEND**
- R = REMOVE EXISTING
 - S = SALVAGE
 - R&S = REMOVE AND SALVAGE
 - N = NEW
 - RET = RETAIN
 - B-B = BACK TO BACK
 - = NEW RAIL
 - = EXISTING RAIL
 - ⊗ = BORING LOCATION

NOTE: ALL DIMENSIONS IN METERS EXCEPT AS INDICATED

PAVING PROJECT LAYOUT #5	PROJECT: DOVER-STRATTON	PROJECT NO.: STP 2214(I)S
	DESIGN FILE NAME: /pave/99bi80/pbi80.dgn	PLOT DATE: 24-MAY-2007
	IPARM FILE NAME: pbi80i05.i	SURVEY DATE: 5/00
	SURVEYED BY: CLD ENGINEERS, INC	DRAWN BY: MPS
	SQUAD LEADER: WRH	SHEET: 14 OF 49

NOT TO SCALE