

TEMPORARY AND DURABLE 100 mm YELLOW LINE
 STA 2+400 TO 2+545 SOLID LT & RT
 STA 2+557 TO 2+800 SOLID LT & RT

STEEL BEAM GUARDRAIL
 STA 2+543 TO 2+570 LT
 STA 2+578 TO 2+586 RT
 STA 2+605 TO 2+608 LT
 STA 2+621 TO 2+632 RT
 40

HEAVY DUTY STEEL BEAM GUARDRAIL
 STA 2+570 TO 2+578 LT
 STA 2+586 TO 2+594 RT
 STA 2+597 TO 2+605 LT
 STA 2+613 TO 2+621 RT

REMOVING SIGNS
 AS SHOWN - 3

DELINEATORS WITH STEEL POSTS
 STA. 2+532 LT
 STA. 2+567 RT
 STA. 2+608 LT
 STA. 2+632 RT

TEMPORARY AND DURABLE 100 mm WHITE LINE
 STA 2+400 TO 2+800 SOLID LT
 STA 2+400 TO 2+539 SOLID RT
 STA 2+563 TO 2+800 SOLID RT





REMOVAL & DISPOSAL OF GUARDRAIL
 STA 2+531 TO 2+578 LT
 STA 2+569 TO 2+594 RT
 STA 2+597 TO 2+607 LT
 STA 2+613 TO 2+632 RT

ANCHOR FOR STEEL BEAM RAIL
 STA 2+608 LT
 STA 2+632 RT

ERECTING SALVAGED SIGNS
 AS SHOWN - 1

YIELDING MARKER POSTS
 STA. 2+522 RT

MANUFACTURED TERMINAL SECTION (FLARED)
 STA 2+543 LT
 STA 2+578 RT
 STA. 2+640 RT

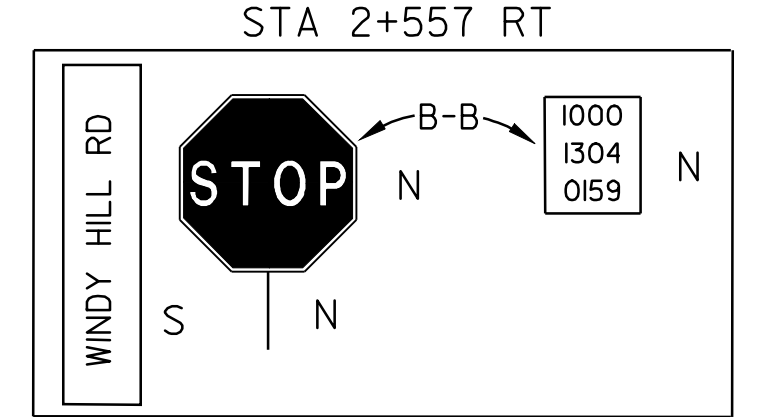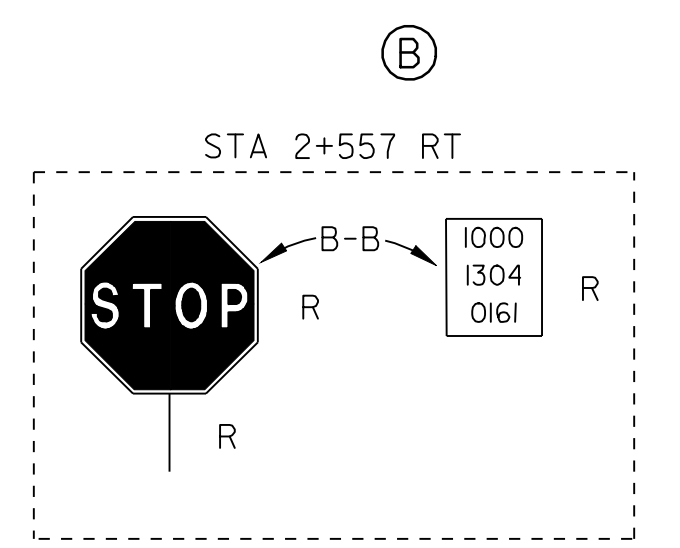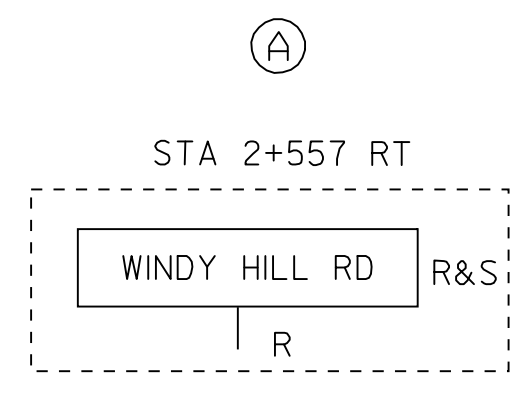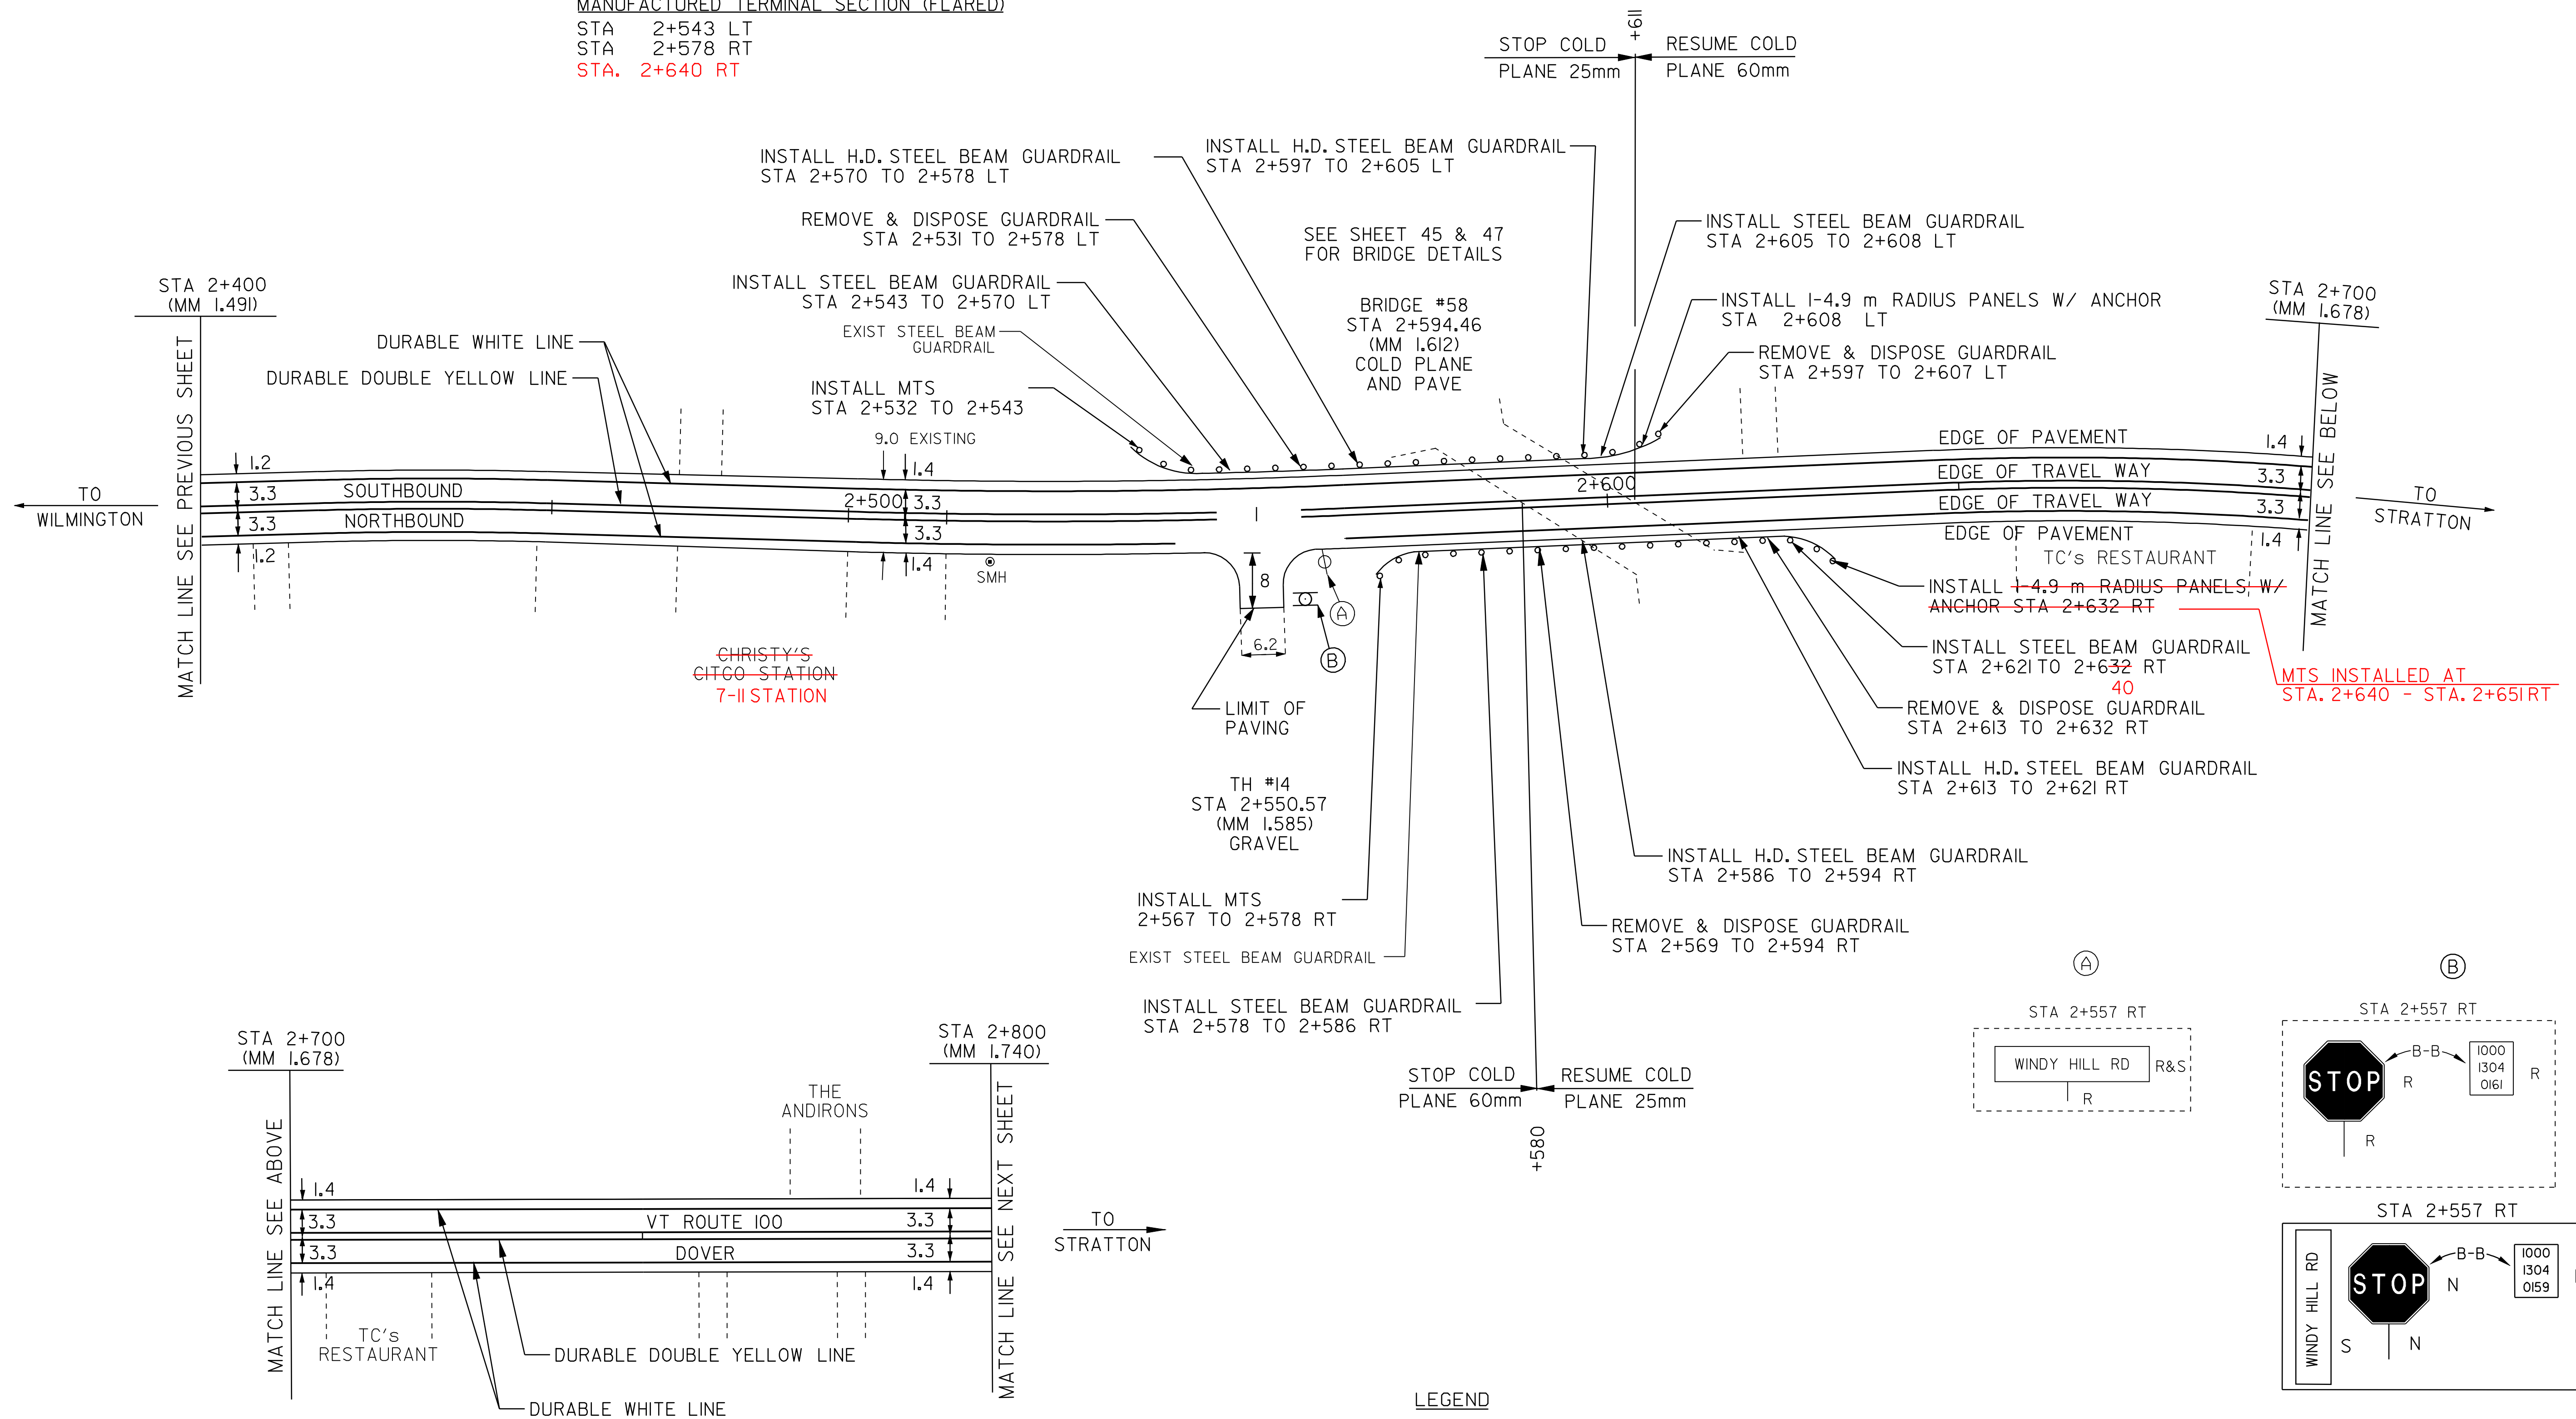

- LEGEND
- R = REMOVE EXISTING
 - S = SALVAGE
 - R&S = REMOVE AND SALVAGE
 - N = NEW
 - RET = RETAIN
 - B-B = BACK TO BACK
 - = NEW RAIL
 - - - = EXISTING RAIL
 - ⊗ = BORING LOCATION

NOTE: ALL DIMENSIONS IN METERS EXCEPT AS INDICATED

DATUM

VERTICAL	N/A
HORIZONTAL	N/A

NOT TO SCALE

PAVING PROJECT LAYOUT #6	PROJECT: DOVER-STRATTON	PROJECT NO.: STP 2214(I)S
	DESIGN FILE NAME: /pave/99bl80/pbl80.dgn	PLOT DATE: 24-MAY-2007
	IPARM FILE NAME: pbl80i06.1	SURVEY DATE: 5/00
	SURVEYED BY: CLD ENGINEERS, INC	DRAWN BY: MPS
	SQUAD LEADER: WRH	SHEET: 15 OF 49