

TEMPORARY AND DURABLE 100 mm YELLOW LINE
 STA 5+600 TO 5+750 DASHED LT, SOLID RT
 STA 5+850 TO ~~5+898~~ SOLID LT & RT 5+910
 STA 5+898 910 TO 6+164 SOLID LT, DASHED RT 6+187
 STA 6+164 87 TO 6+200 DASHED

TEMPORARY AND DURABLE 100 mm WHITE LINE
 STA 5+600 TO 5+750 SOLID LT
 STA 5+600 TO 5+750 SOLID RT
 STA 5+850 TO 6+200 SOLID LT
 STA 5+850 TO 6+200 SOLID RT

REMOVAL & DISPOSAL OF GUARDRAIL
 STA 5+697 TO 5+750 LT
 STA 6+056 TO 6+200 RT
 STA 6+158 TO 6+200 LT


STEEL BEAM GUARDRAIL
 STA 5+709 TO 5+750 LT
 STA 6+068 TO 6+200 RT
~~STA 6+170 TO 6+200 LT~~

STEEL BEAM GUARDRAIL - 2.4m POSTS (MOD.)
 STA. 6+170 TO 6+200 LT

MANUFACTURED TERMINAL SECTION (FLARED)
 STA 5+709 LT
 STA 6+068 RT
 STA 6+170 LT

DELINEATORS WITH STEEL POSTS
 STA. 5+698 LT
 STA. 5+057 RT
 STA. 6+159 LT

YIELDING MARKER POSTS
 STA. 5+691 RT
 STA. 5+693 LT
 STA. 6+180 RT

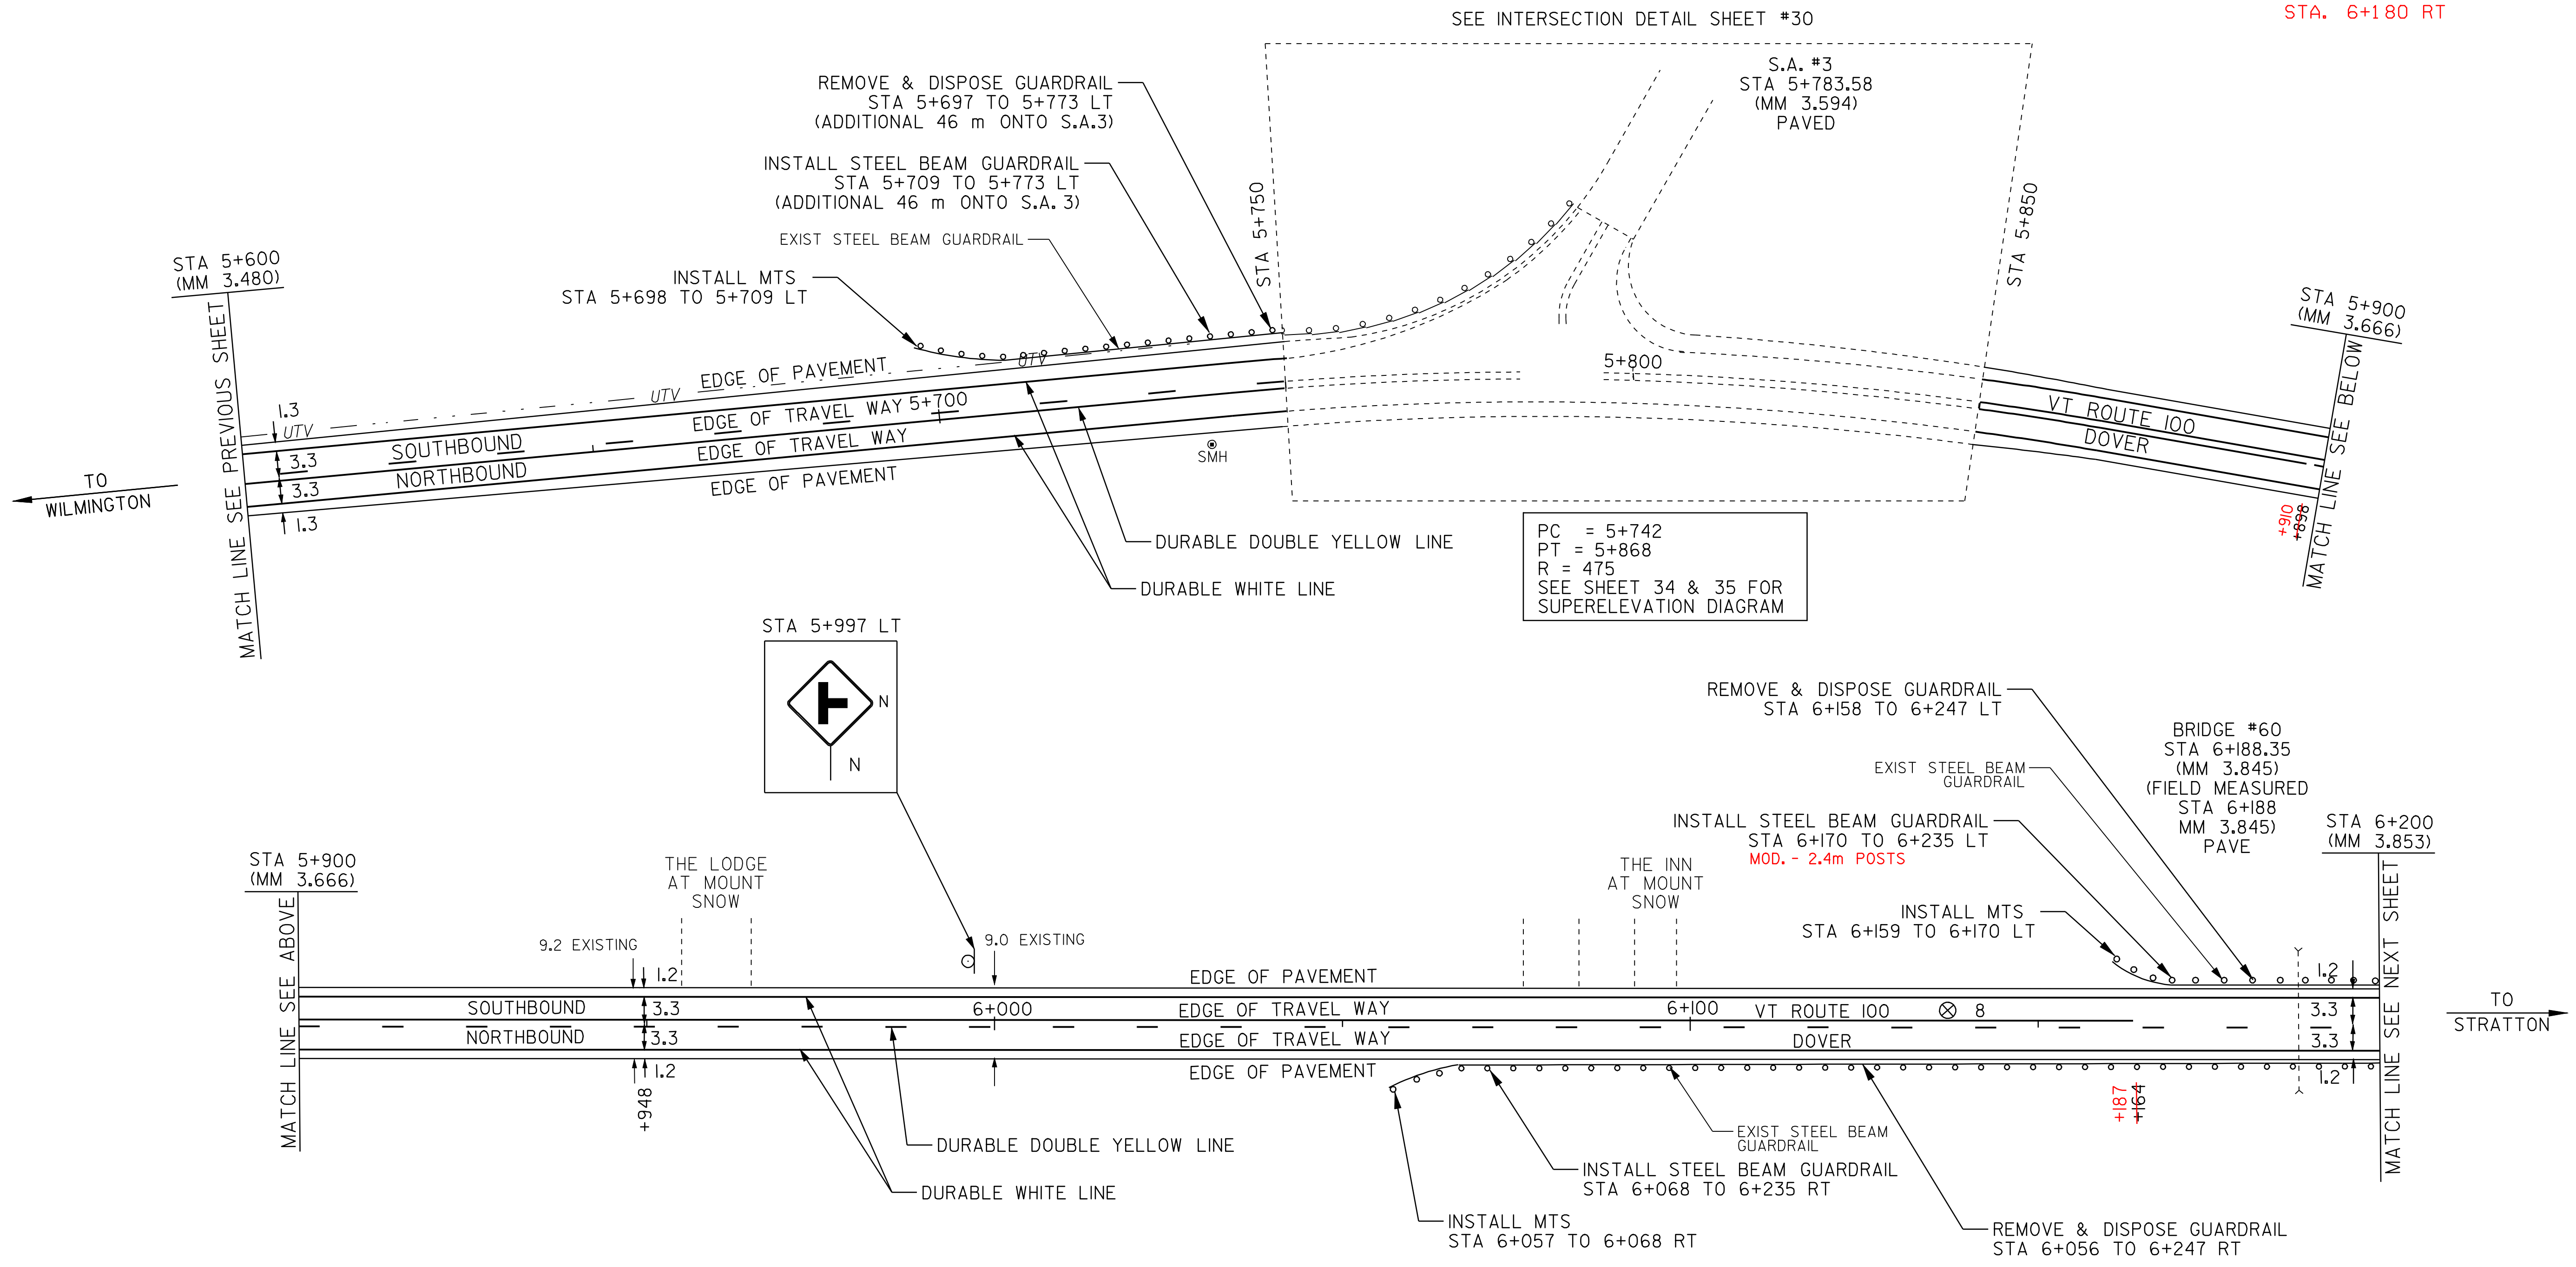

LEGEND

- R = REMOVE EXISTING
- S = SALVAGE
- R&S = REMOVE AND SALVAGE
- N = NEW
- RET = RETAIN
- B-B = BACK TO BACK
- = NEW RAIL
- = EXISTING RAIL
- ⊗ = BORING LOCATION
- UTV = BURIED CABLE

NOTE: ALL DIMENSIONS IN METERS EXCEPT AS INDICATED

DATUM			
VERTICAL	N/A		
HORIZONTAL	N/A		

PAVEMENT CORES	STA	TOTAL DEPTH (MM)	PCC
8	STA 6+136 LT	140	NO

NOT TO SCALE

PAVING PROJECT LAYOUT #12	PROJECT: DOVER-STRATTON	PROJECT NO.: STP 2214(I)S
	DESIGN FILE NAME: /pave/99bl80/pbl80.dgn	PLOT DATE: 24-MAY-2007
	IPARM FILE NAME: pbl80i12.1	SURVEY DATE: 5/00
	SURVEYED BY: CLD ENGINEERS, INC	DRAWN BY: MPS
	SQUAD LEADER: WRH	SHEET: 21 OF 49