

TEMPORARY AND DURABLE 100 mm YELLOW LINE
 STA 6+800 TO 6+952 SOLID LT, DASHED RT 967
 STA 6+952.67 TO 7+051 SOLID LT & RT
 STA 7+057 DOUBLE SOLID LT (TH #53)
 STA 7+063 TO 7+188 SOLID LT & RT
 STA 7+200 TO 7+355 SOLID LT & RT 373
 STA 7+355.73 TO 7+400 SOLID LT, DASHED RT


TEMPORARY AND DURABLE 100 mm WHITE LINE
 STA 6+800 TO 7+054 SOLID LT
 STA 6+800 TO 7+400 SOLID RT
 STA 7+061 TO 7+182 SOLID LT
 STA 7+206 TO 7+400 SOLID LT

TEMPORARY AND DURABLE 600 mm STOP BAR
 STA 7+057 LT (TH #53)
TEMPORARY AND DURABLE LETTER OR SYMBOL
 STA 7+057 LT - "STOP" (TH #53)

REMOVING SIGNS
 AS SHOWN - 6
ERECTING SALVAGED SIGNS
 AS SHOWN - 4

REMOVAL & DISPOSAL OF GUIDE POSTS
 STA 7+069 RT (1)

YIELDING MARKER POSTS
 STA. 6+814 LT
 STA. 6+816 RT
 STA. 6+923 LT
 STA. 6+997 RT
 STA. 7+002 LT
 STA. 7+132 RT
 STA. 7+141 LT
 STA. 7+206 LT
 STA. 7+289 RT
 STA. 7+291 LT

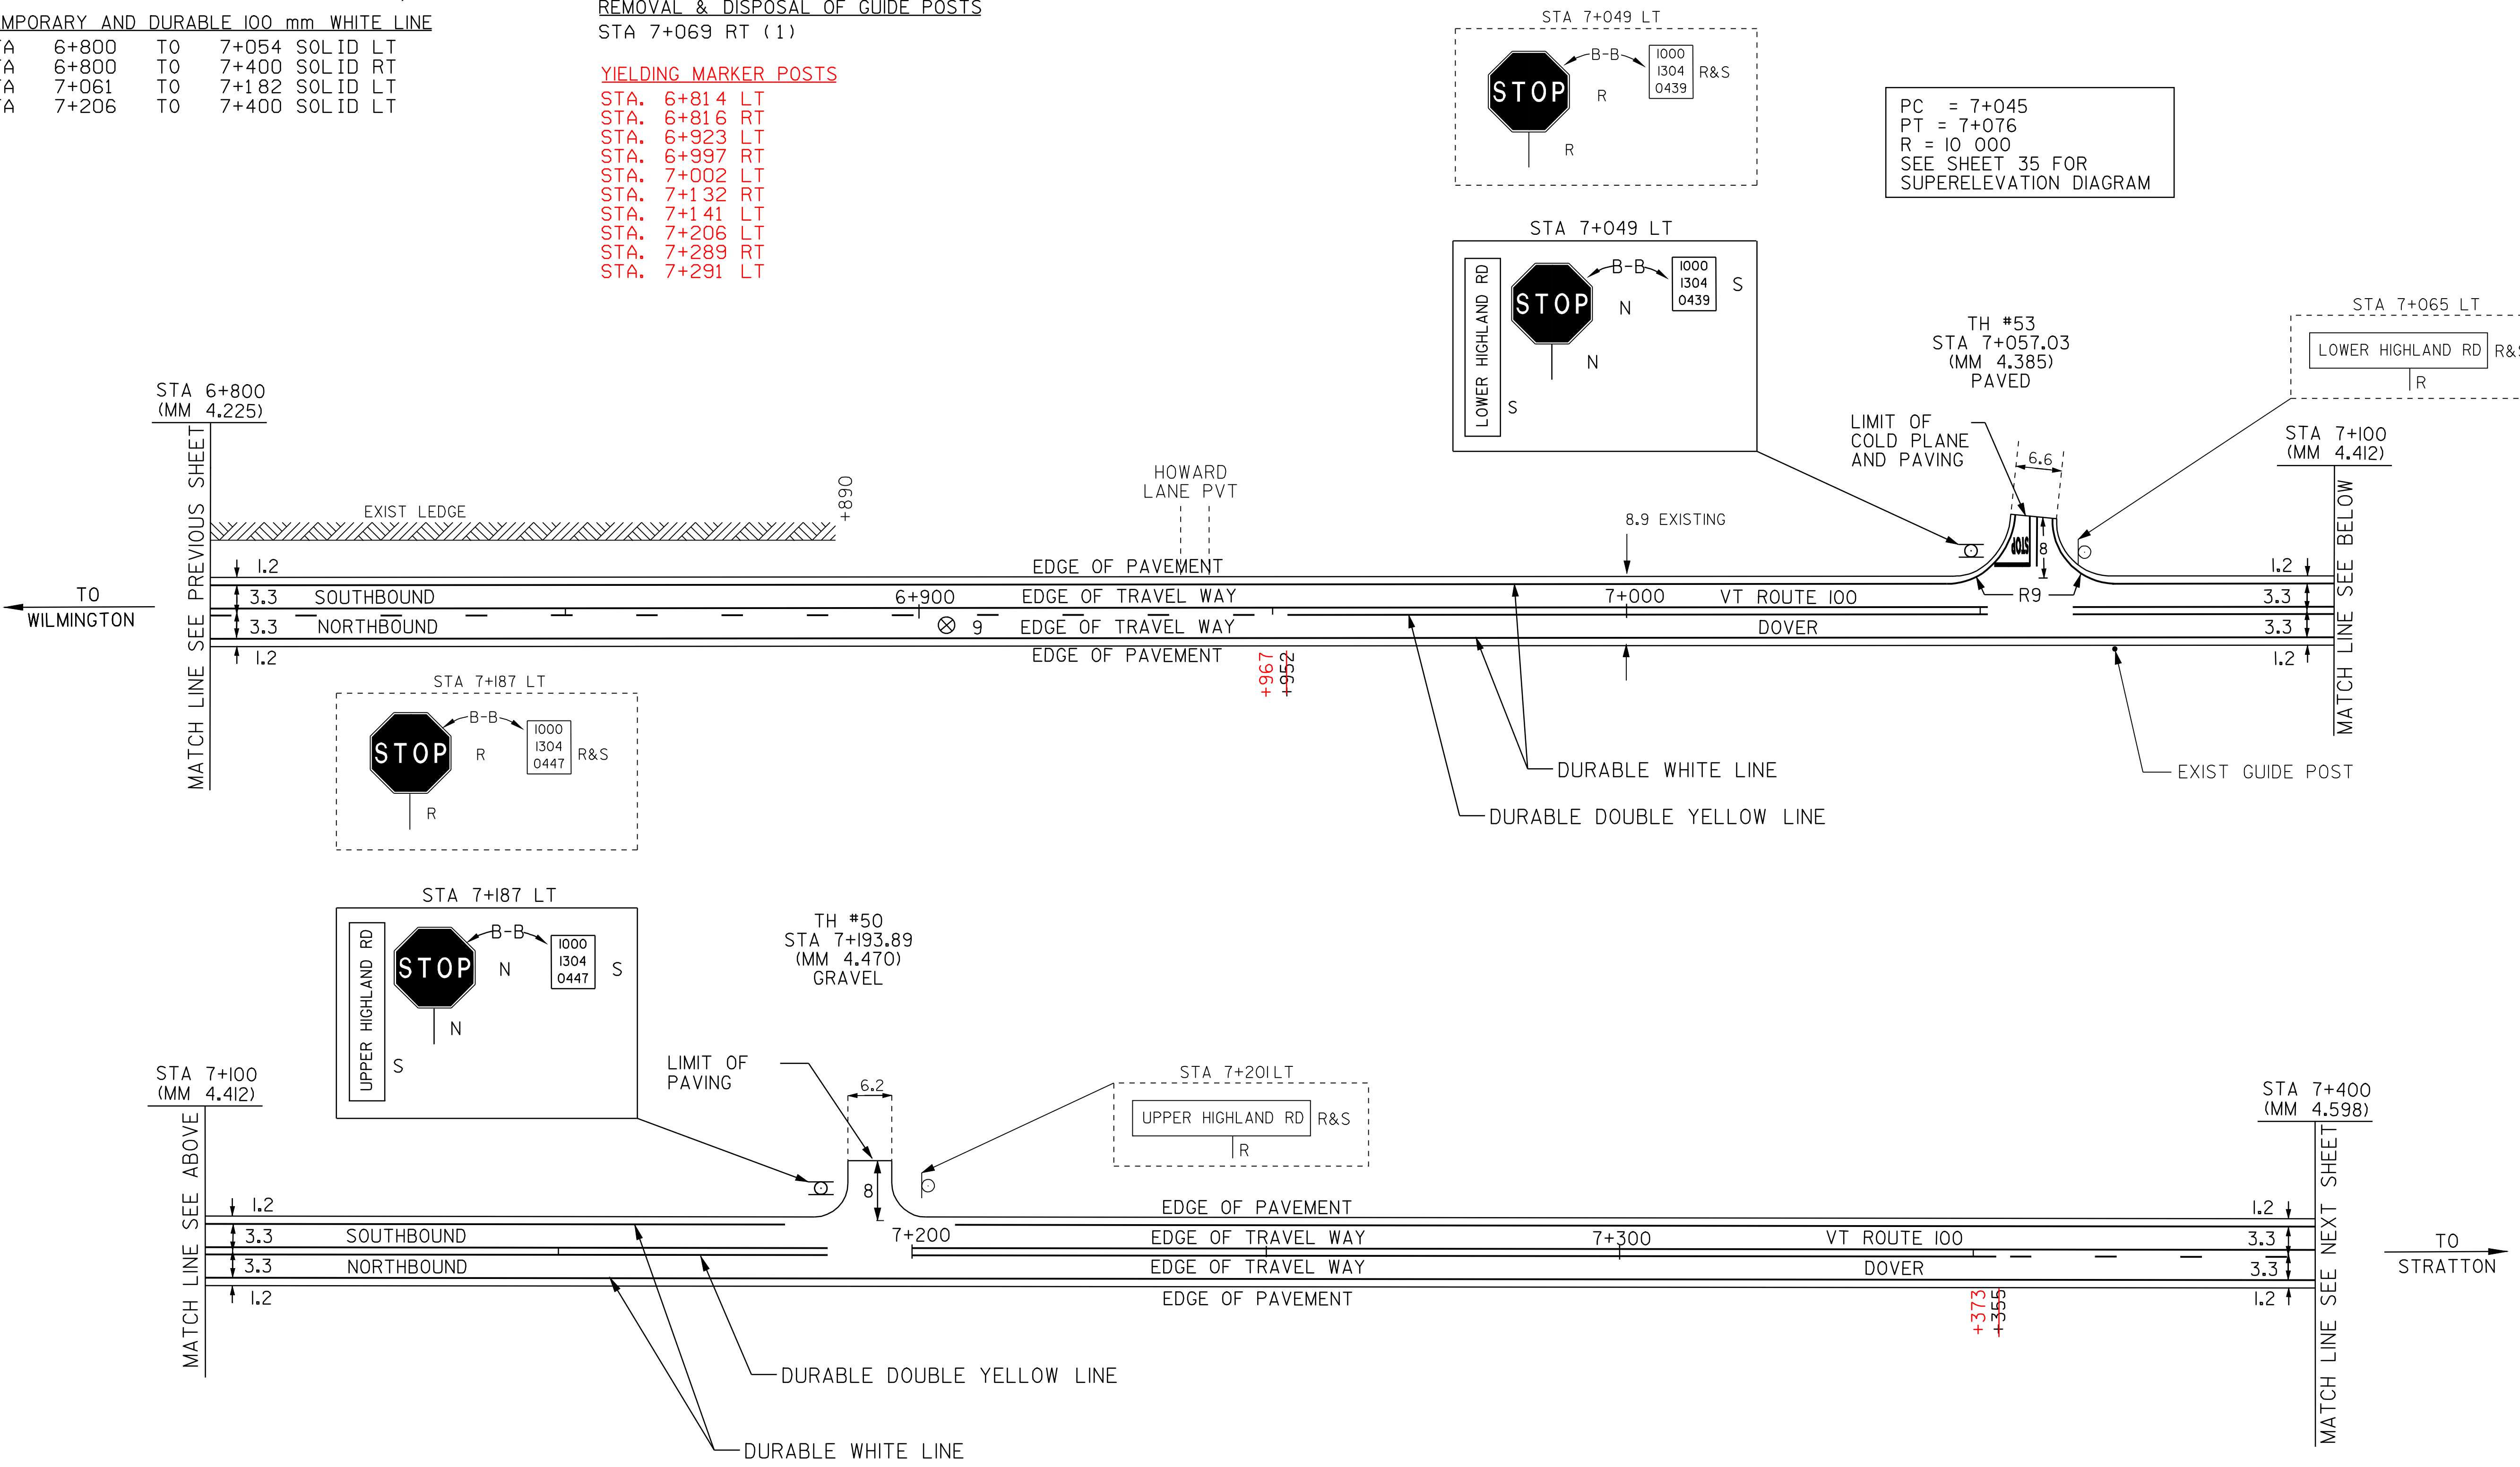

DATUM	
VERTICAL	N/A
HORIZONTAL	N/A

PAVEMENT CORES	STA	TOTAL DEPTH (MM)	PCC
9	STA 6+904 RT	140	NO

NOT TO SCALE

- LEGEND**
- R = REMOVE EXISTING
 - S = SALVAGE
 - R&S = REMOVE AND SALVAGE
 - N = NEW
 - RET = RETAIN
 - B-B = BACK TO BACK
 - = NEW RAIL
 - - - = EXISTING RAIL
 - ⊗ = BORING LOCATION

NOTE: ALL DIMENSIONS IN METERS EXCEPT AS INDICATED

PAVING PROJECT LAYOUT #14	PROJECT: DOVER-STRATTON	PROJECT NO.: STP 2214(I)S
	DESIGN FILE NAME: /pave/99bl80/pbl80.dgn	PLOT DATE: 24-MAY-2007
	IPARM FILE NAME: pbl80i14.1	SURVEY DATE: 5/00
	SURVEYED BY: CLD ENGINEERS, INC	DRAWN BY: MPS
	SQUAD LEADER: WRH	SHEET: 23 OF 49