


TEMPORARY AND DURABLE 100 mm YELLOW LINE
 STA 0+300 TO 0+900 SOLID LT & RT

TEMPORARY AND DURABLE 100 mm WHITE LINE
 STA 0+300 TO 0+900 LT
 STA 0+300 TO 0+900 RT

STONE FILL, TYPE I
 GEOTEXTILE UNDER STONE FILL
 STA 0+300 TO 0+630 RT 635
 STA 0+346 TO 0+410 LT
 STA 0+422 TO 0+507 LT 433
 STA 0+870 TO 0+900 LT
 STA 0+875 TO 0+900 RT
 STA. 0+300 TO 0+301 RT
 STA. 0+476 TO 0+507 LT
 STA. 0+600 TO 0+610 LT
 STA. 0+700 TO 0+740 LT

YIELDING MARKER POSTS
 STA. 0+322 LT
 STA. 0+334 RT
 STA. 0+433 LT
 STA. 0+440 RT
 STA. 0+518 LT
 STA. 0+525 RT
 STA. 0+592 LT
 STA. 0+595 RT
 STA. 0+690 LT
 STA. 0+697 RT

EROSION MATTING
 STA. 0+595 TO 0+608 RT
 STA. 0+710 TO 0+730 LT

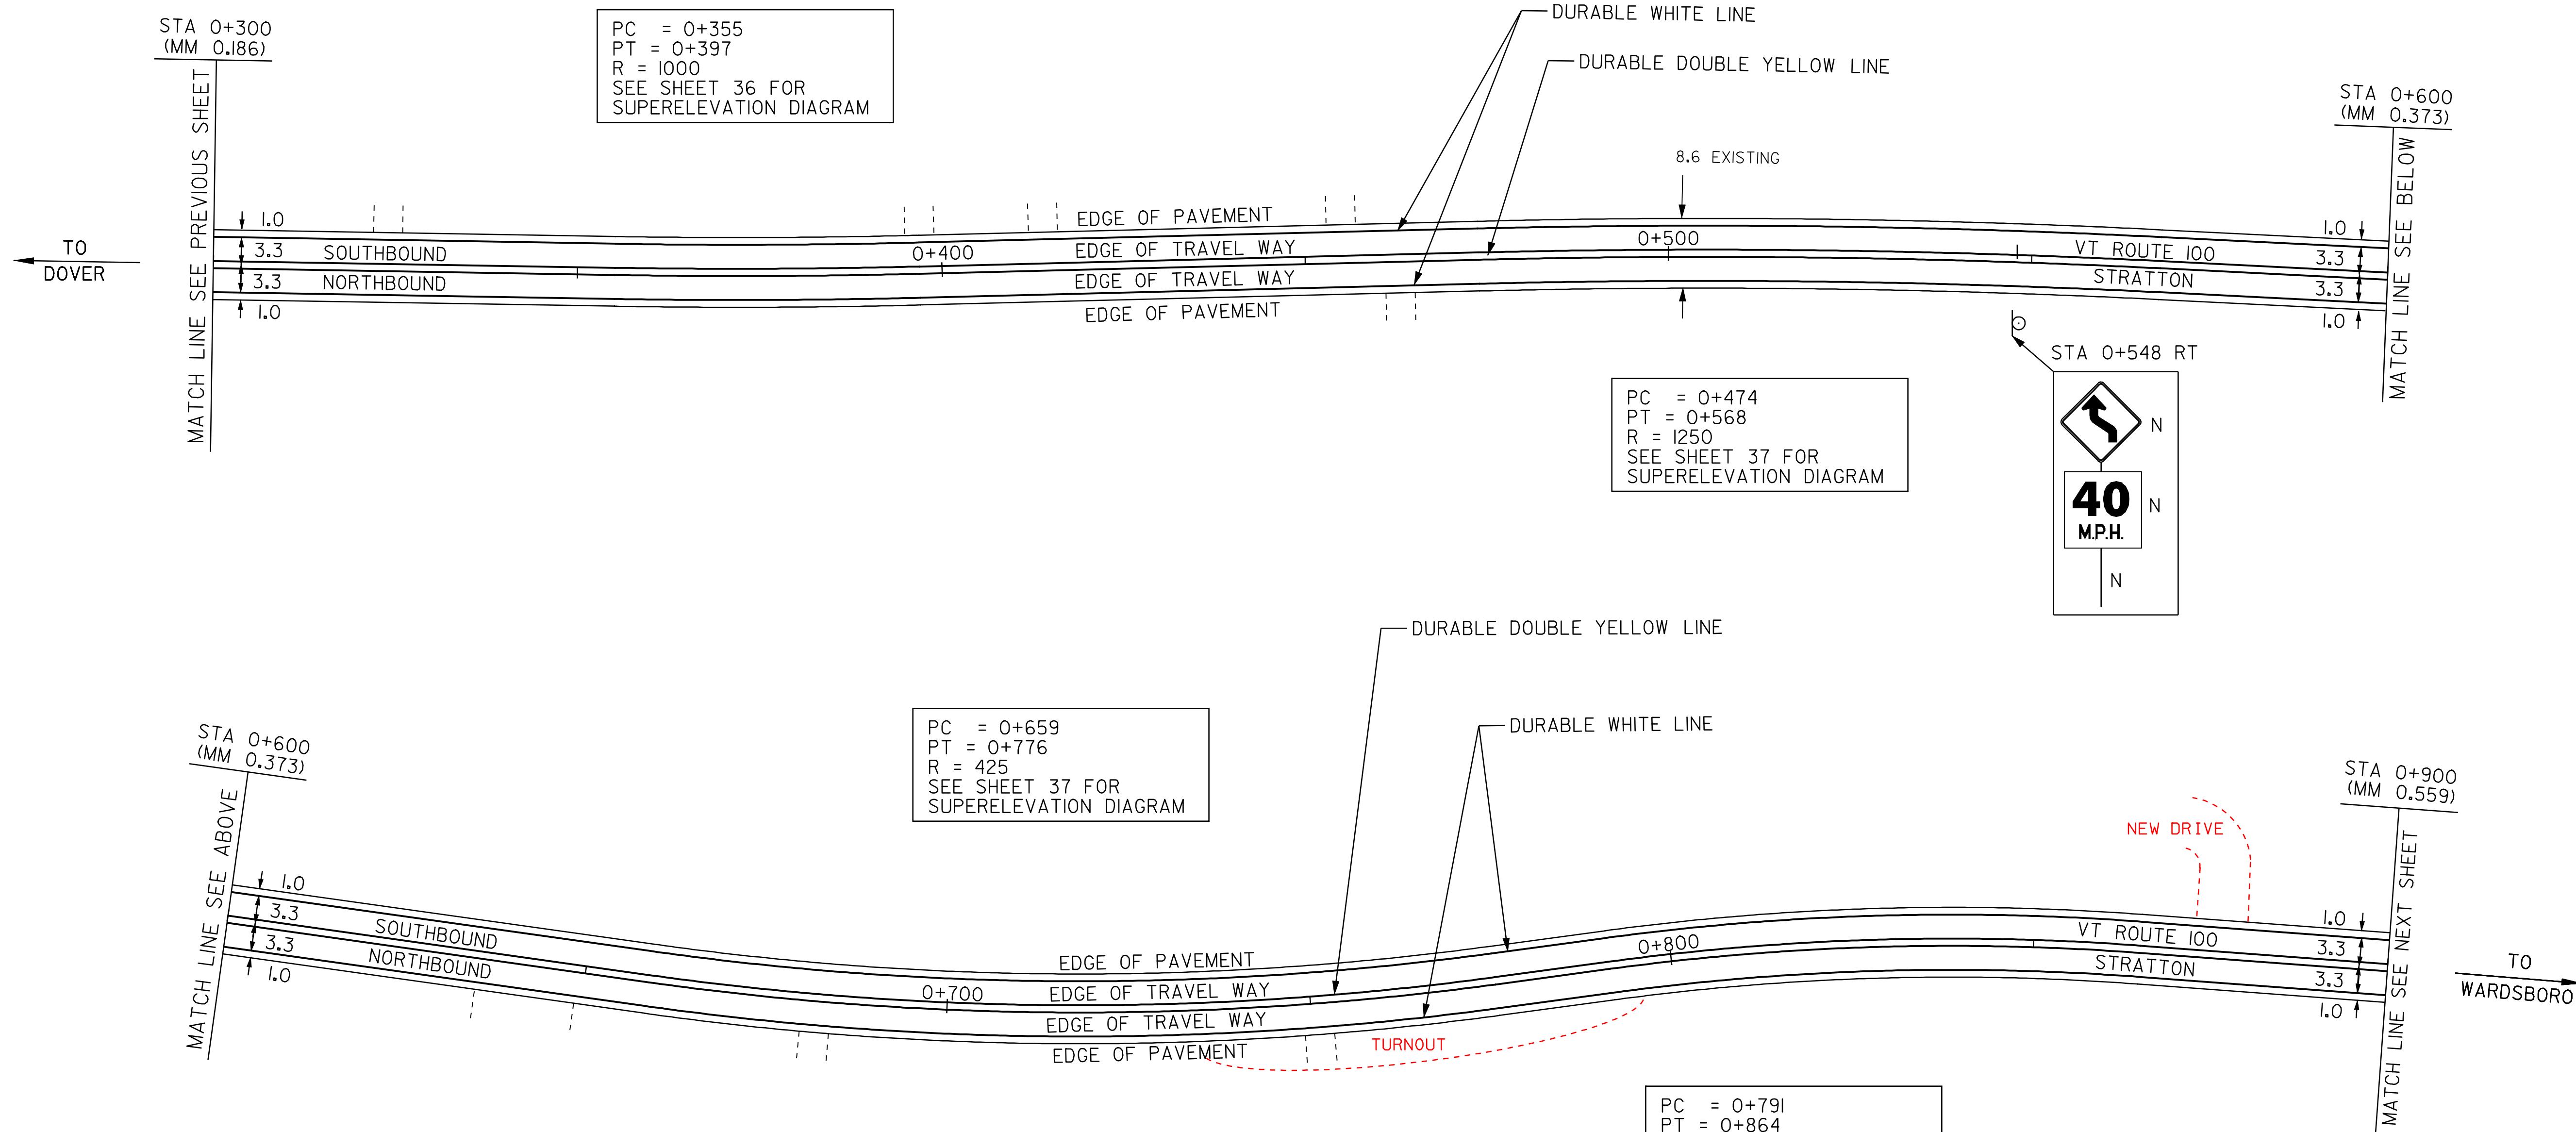


STA 0+300 (MM 0.186)
 PC = 0+355
 PT = 0+397
 R = 1000
 SEE SHEET 36 FOR SUPERELEVATION DIAGRAM

PC = 0+474
 PT = 0+568
 R = 1250
 SEE SHEET 37 FOR SUPERELEVATION DIAGRAM

PC = 0+659
 PT = 0+776
 R = 425
 SEE SHEET 37 FOR SUPERELEVATION DIAGRAM

PC = 0+791
 PT = 0+864
 R = 350
 SEE SHEET 37 FOR SUPERELEVATION DIAGRAM

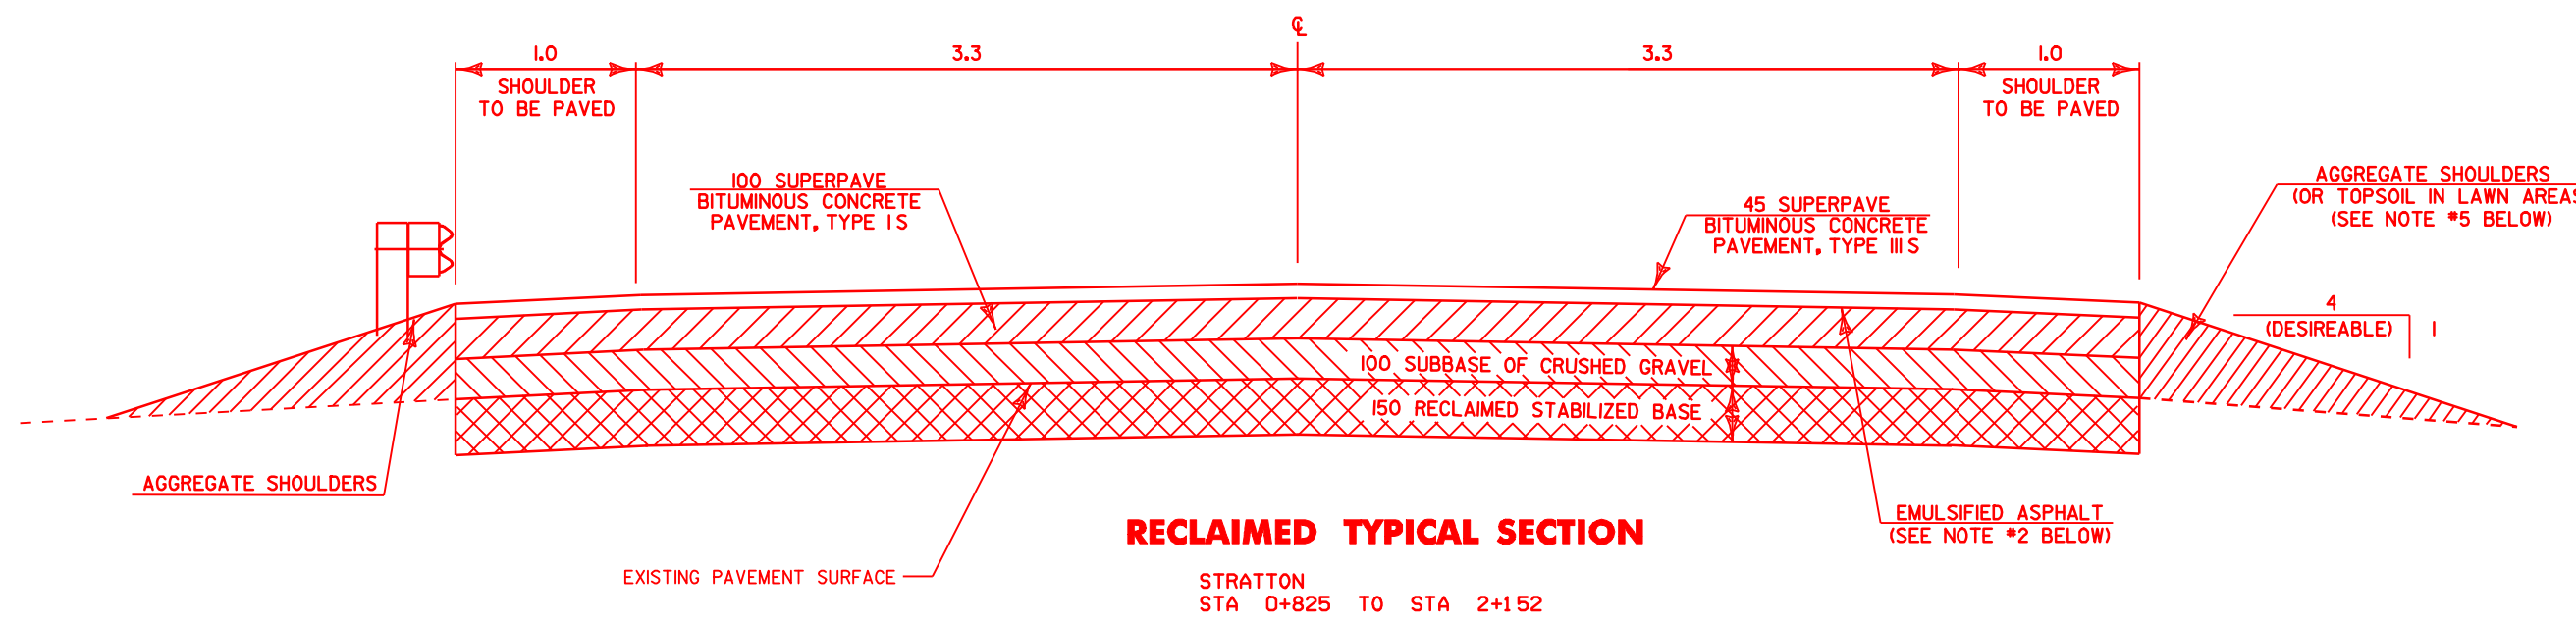

- LEGEND
- R = REMOVE EXISTING
 - S = SALVAGE
 - R&S = REMOVE AND SALVAGE
 - N = NEW
 - RET = RETAIN
 - B-B = BACK TO BACK
 - = NEW RAIL
 - - - = EXISTING RAIL
 - ⊗ = BORING LOCATION

NOTE: ALL DIMENSIONS IN METERS EXCEPT AS INDICATED

PAVING PROJECT LAYOUT #18	PROJECT: DOVER-STRATTON	PROJECT NO.: STP 2214(I)S
	DESIGN FILE NAME: /pave/99bl80/pbl80.dgn	PLOT DATE: 24-MAY-2007
	IPARM FILE NAME: pbl80i18.1	SURVEY DATE: 5/00
	SURVEYED BY: CLD ENGINEERS, INC	DRAWN BY: MPS
	SQUAD LEADER: WRH	SHEET: 27 OF 49

DATUM
 VERTICAL N/A
 HORIZONTAL N/A

ACTUAL WORK: STATION 0+846 TO WARDSBORO 0+015 LT & RT

NOT TO SCALE