

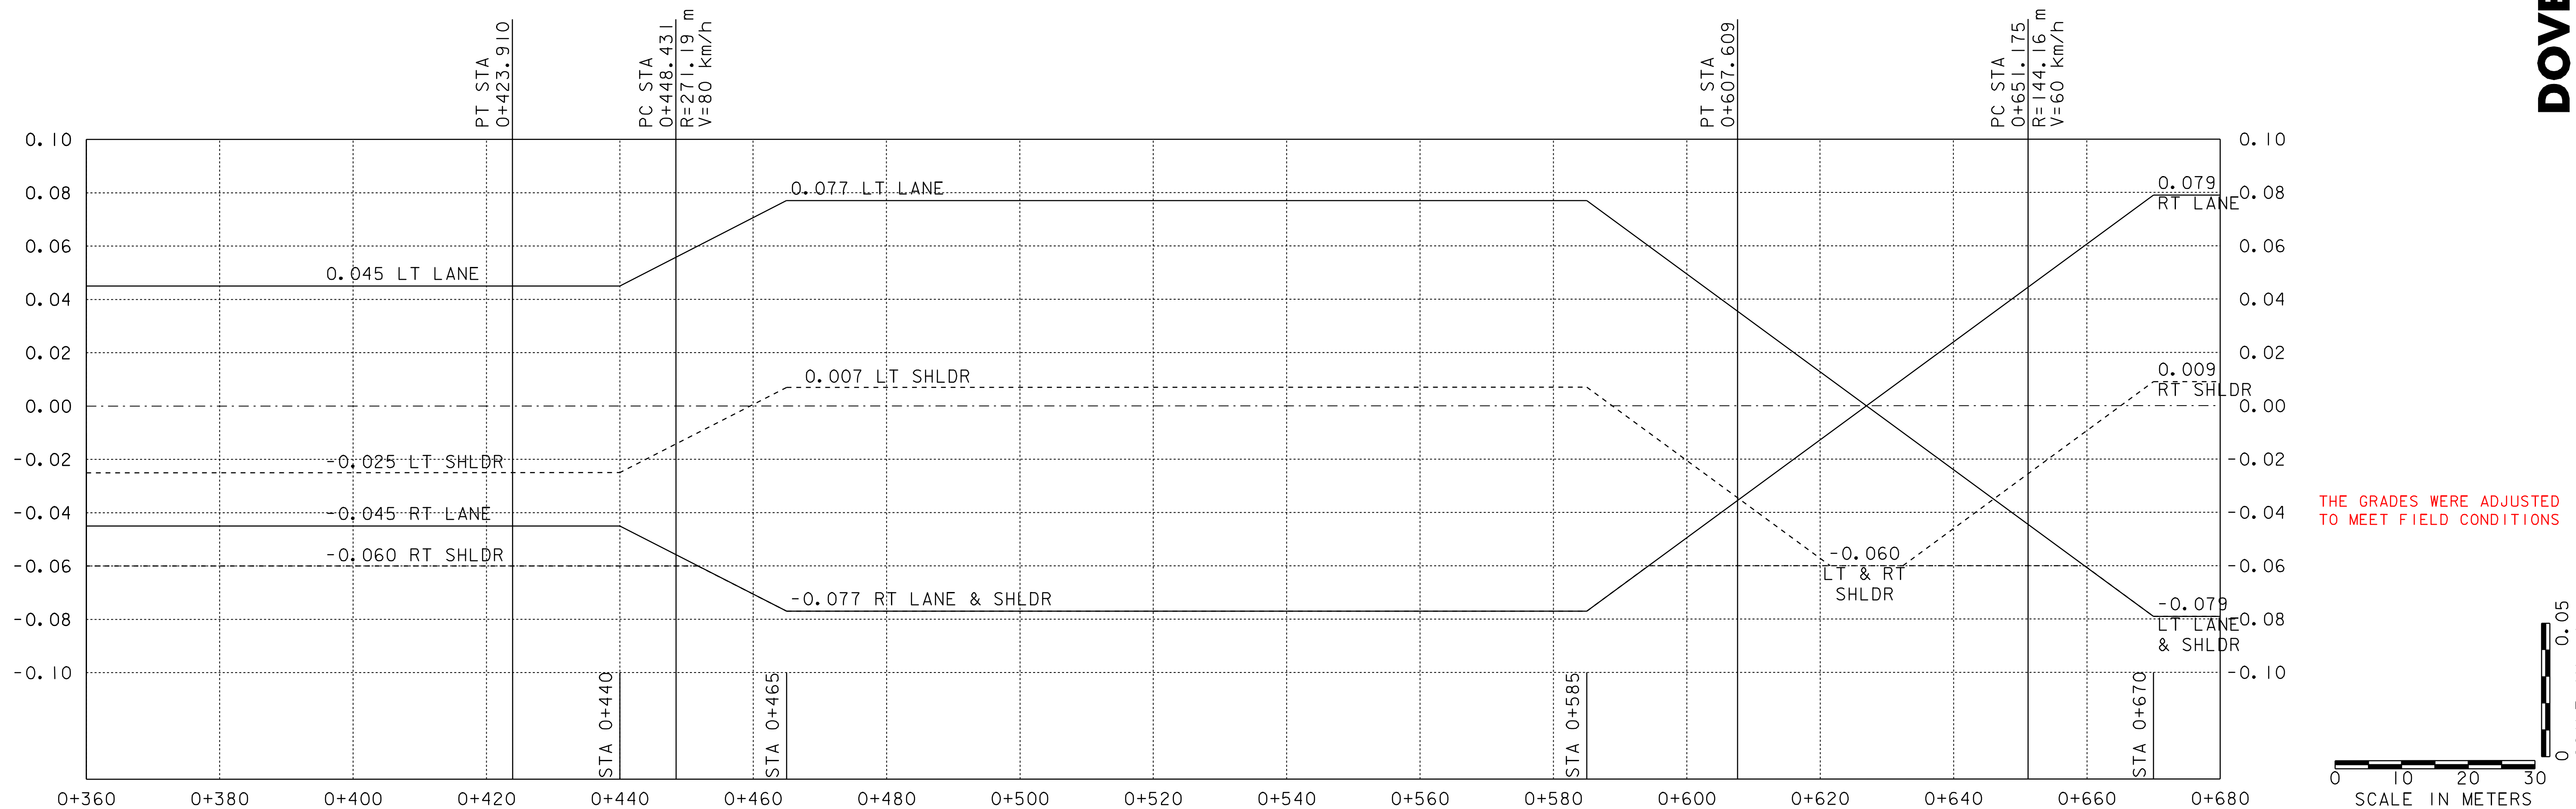


VT ROUTE 100
 STA 0+000.00
 (MM 0.000)
 BEGIN PROJECT
 STP 2214(I)S

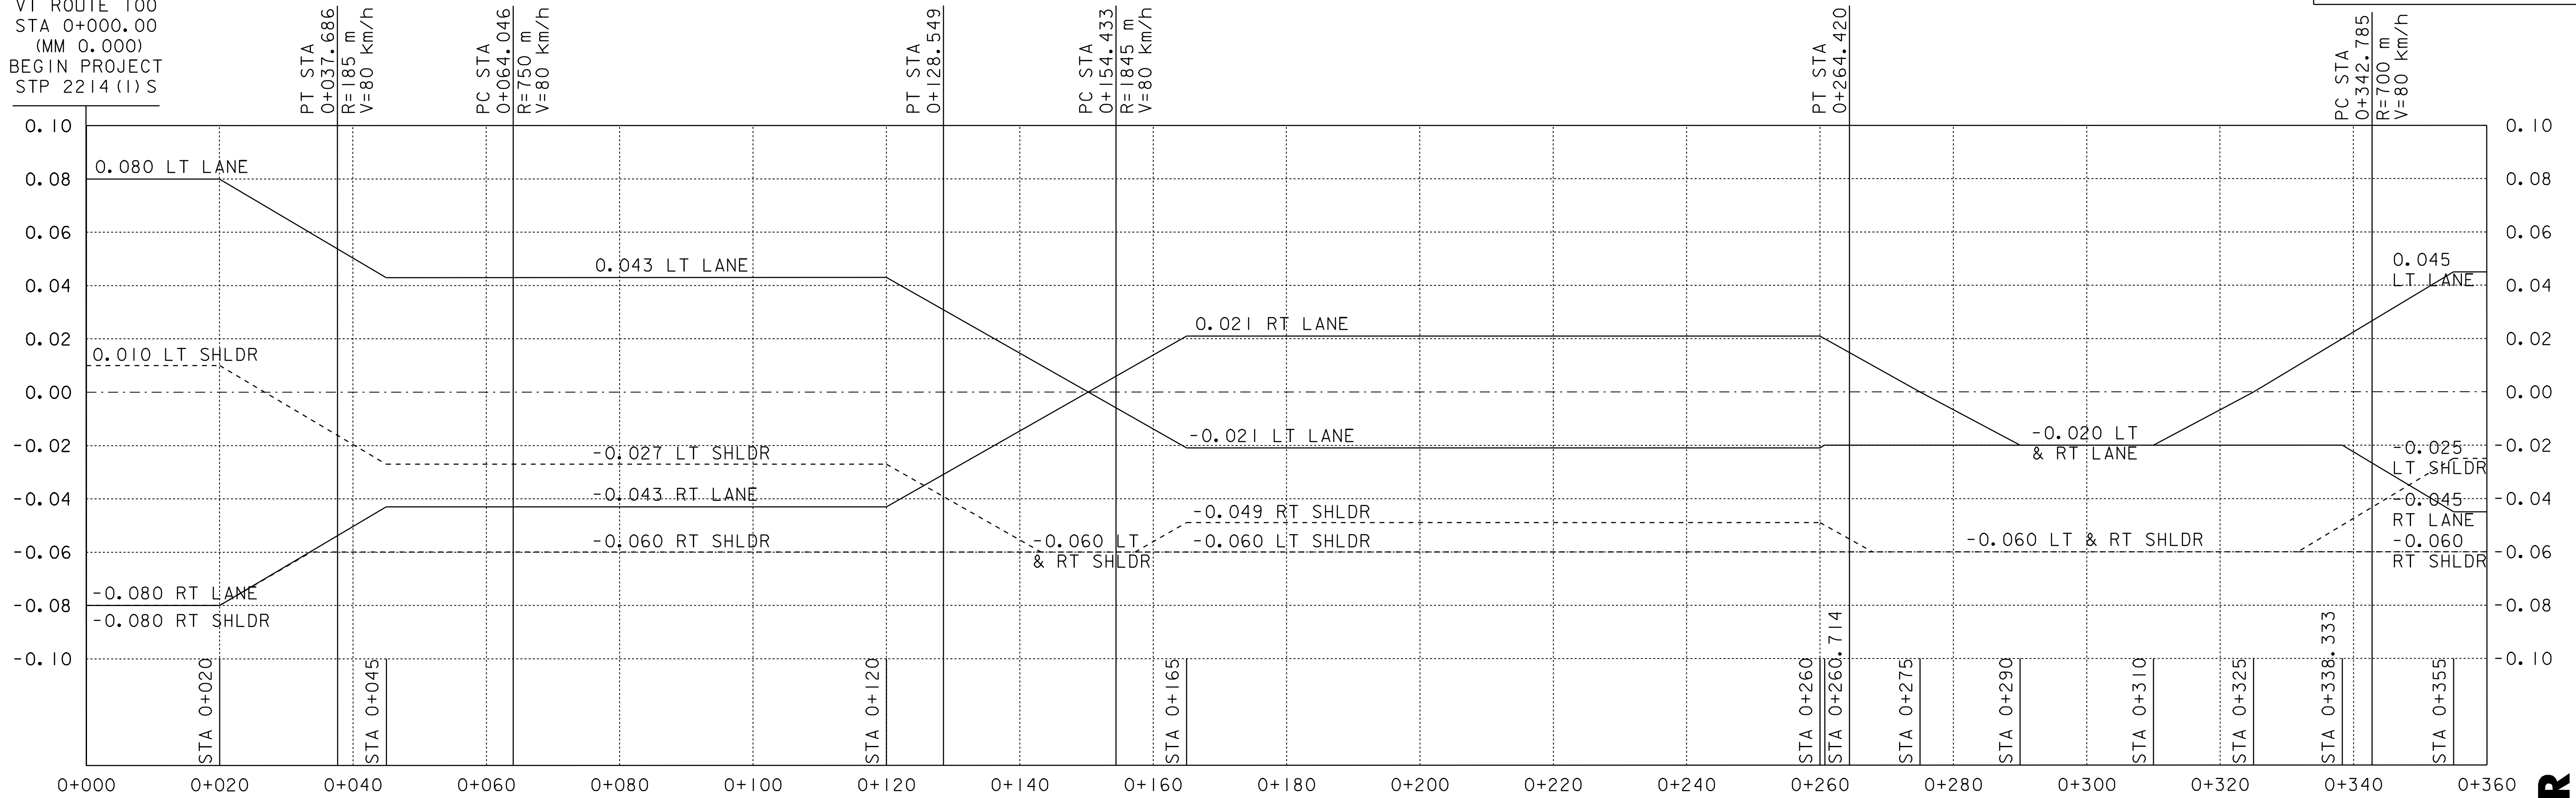

DOVER

THE GRADES WERE ADJUSTED TO MEET FIELD CONDITIONS

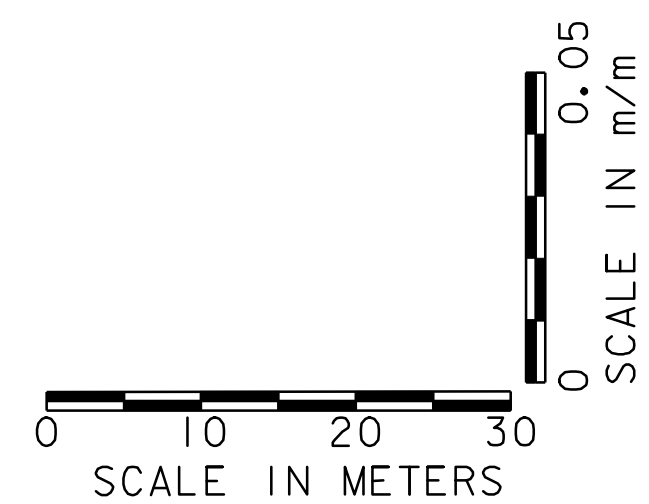

DATUM	
VERTICAL	N/A
HORIZONTAL	N/A

NOTE:
 THE CONTRACTOR IS RESPONSIBLE FOR THE ENGINEERING WORK REQUIRED TO LAYOUT AND MAINTAIN THE CROSS SLOPES IN THE REGRADING OF THE RECLAIMED AREAS.

**BANKING
 DIAGRAM
 SHEET 1**

PROJECT: DOVER-STRATTON	PROJECT NO.: STP 2214(I)S
DESIGN FILE NAME: /pave/99bi80/pbi80.dgn	PLOT DATE: 24-MAY-2007
IPARM FILE NAME: pbi80bd01.i	SURVEY DATE: 5/00
SURVEYED BY: CLD ENGINEERS, INC	DRAWN BY: PTS
SQUAD LEADER: WRH	SHEET: 31 OF 49