


THE GRADES WERE ADJUSTED TO MEET FIELD CONDITIONS

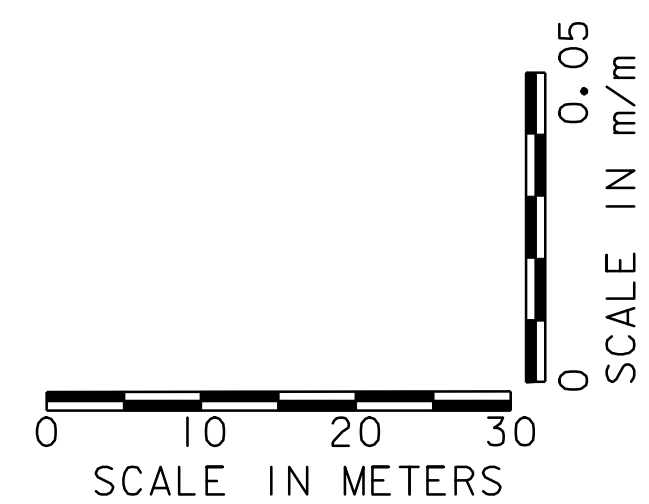

DATUM	
VERTICAL	N/A
HORIZONTAL	N/A

NOTE:
THE CONTRACTOR IS RESPONSIBLE FOR THE ENGINEERING WORK REQUIRED TO LAYOUT AND MAINTAIN THE CROSS SLOPES IN THE REGRADING OF THE RECLAIMED AREAS.

**BANKING
DIAGRAM
SHEET 2**

PROJECT:	DOVER-STRATTON	PROJECT NO.:	STP 2214(I)S
DESIGN FILE NAME:	/pave/99bi80/pbi80.dgn		
IPARM FILE NAME:	pbi80bd02.i		
SURVEYED BY:	CLD ENGINEERS, INC		
SQUAD LEADER:	WRH		
PLOT DATE:	24-MAY-2007		
SURVEY DATE:	5/00		
DRAWN BY:	PTS		
SHEET:	32 OF 49		

DOVER