


THE GRADES WERE ADJUSTED TO MEET FIELD CONDITIONS

STRATTON

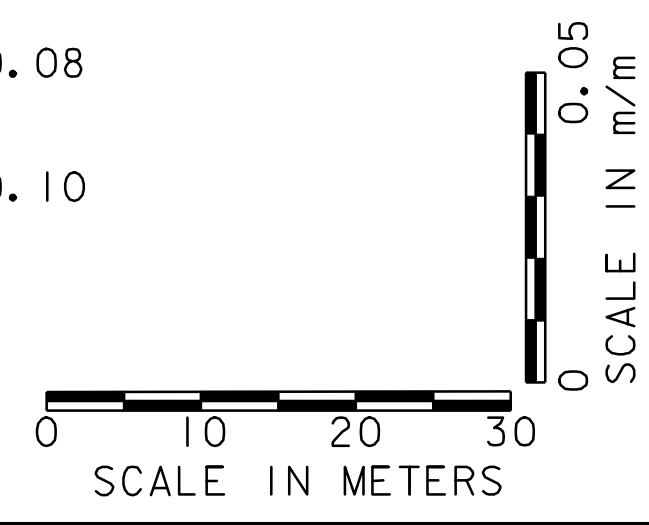

DATUM	
VERTICAL	N/A
HORIZONTAL	N/A

NOTE:
THE CONTRACTOR IS RESPONSIBLE FOR THE ENGINEERING WORK REQUIRED TO LAYOUT AND MAINTAIN THE CROSS SLOPES IN THE REGRADING OF THE RECLAIMED AREAS.

**BANKING
DIAGRAM
SHEET 7**

PROJECT:	DOVER-STRATTON	PROJECT NO.:	STP 2214(I)S
DESIGN FILE NAME:	/pave/99bi80/pbi80.dgn	PLOT DATE:	24-MAY-2007
IPARM FILE NAME:	pbi80bd07.i	SURVEY DATE:	5/00
SURVEYED BY:	CLD ENGINEERS, INC	DRAWN BY:	PTS
SQUAD LEADER:	WRH	SHEET:	37 OF 49