


THE GRADES WERE ADJUSTED TO MEET FIELD CONDITIONS

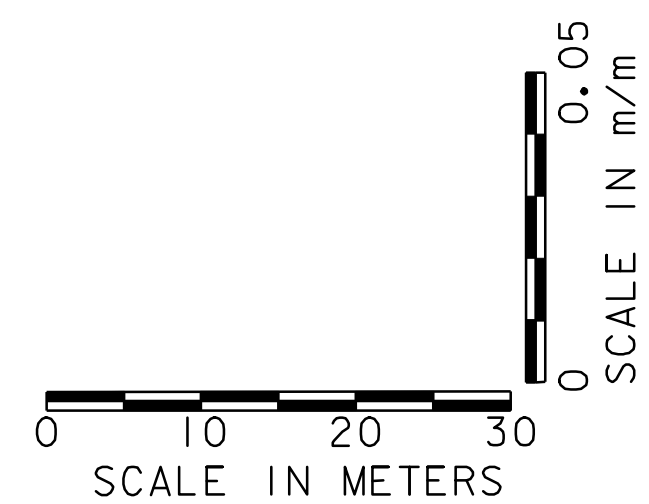

STRATTON

DATUM	
VERTICAL	N/A
HORIZONTAL	N/A

NOTE:
THE CONTRACTOR IS RESPONSIBLE FOR THE ENGINEERING WORK REQUIRED TO LAYOUT AND MAINTAIN THE CROSS SLOPES IN THE REGRADING OF THE RECLAIMED AREAS.

BANKING DIAGRAM SHEET 9	PROJECT:	DOVER-STRATTON	PROJECT NO.:	STP 2214(I)S
	DESIGN FILE NAME:	/pave/99bl80/pbl80.dgn		
	IPARM FILE NAME:	pbl80bd09.i		
	SURVEYED BY:	CLD ENGINEERS, INC		
SQUAD LEADER:	WRH			PLOT DATE: 24-MAY-2007
				SURVEY DATE: 5/00
				DRAWN BY: PTS
				SHEET: 39 OF 49