

TEMPORARY AND DURABLE 100mm YELLOW LINE

STA. 1+370.0 TO STA. 2+040.0 SOLID LT. AND RT.

MANUFACTURED TERMINAL SECTION (FLARED)

STA. 1+771.0 RT. TO STA. 1+782.4 LT.  
STA. 1+945.8 LT. TO STA. 1+957.2 LT.

STEEL BEAM GUARD RAIL

STA. 1+782.4 LT. TO STA. 1+945.8 LT.

REMOVING SIGNS

22 -- AS SHOWN

TEMPORARY AND DURABLE 100mm WHITE LINE


STA. 1+370.0 TO STA. 2+040.0 SOLID LT. AND RT. (EDGE LINE)

FLASHING BEACON -- GROUND MOUNTED (MOD.)

STA. 1+706 RT.

REMOVAL AND DISPOSAL OF GUARD RAIL

STA. 1+771 LT. TO STA. 1+955 LT.

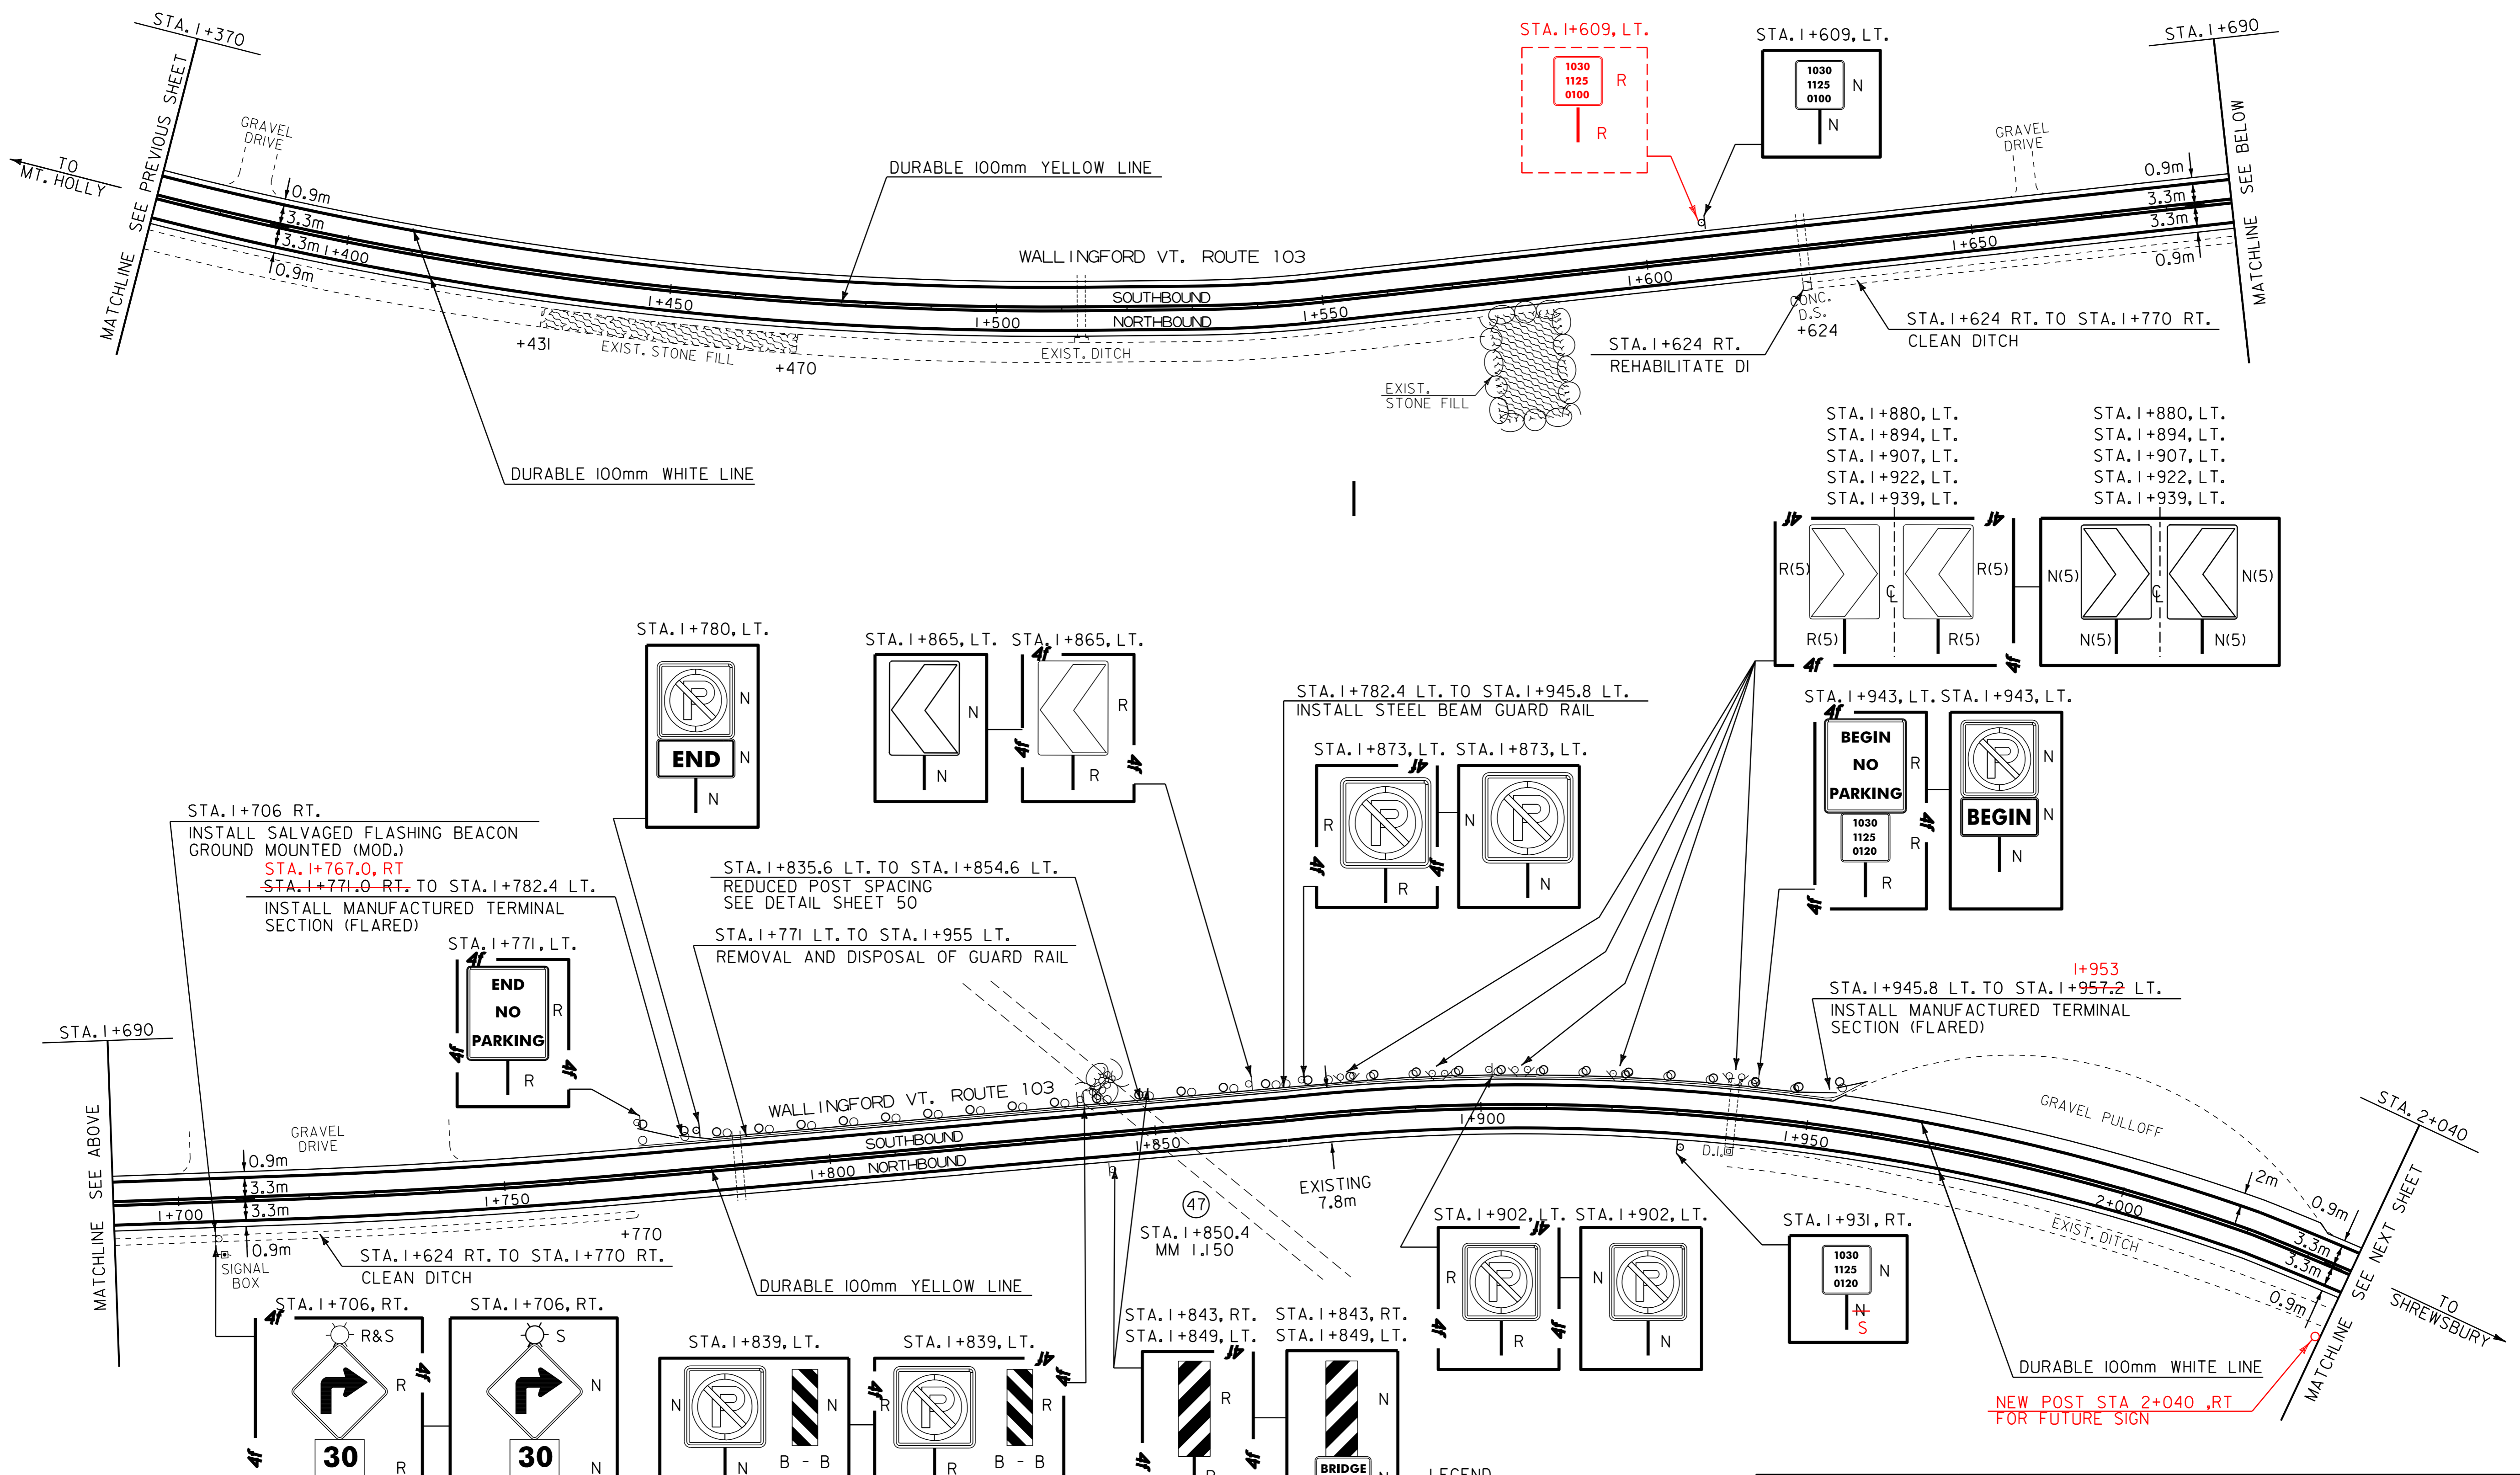

- LEGEND
- N = NEW
  - R = REMOVE
  - R & S = REMOVE AND SALVAGE
  - S = SALVAGE SIGN
  - RET = RETAIN
  - B - B = BACK TO BACK

**PAVING PROJECT LAYOUT #3**

PROJECT: <b>WALLINGFORD-CLARENDON</b>	PROJECT NO.: <b>NH 2216(1)S</b>
DESIGN FILE NAME: /pave/99b184/pb184.dgn	PLOT DATE: 13-NOV-2013 13:
IPARM FILE NAME: pb184i03.i	SURVEY DATE:
SURVEYED BY: SJL, ACT	DRAWN BY: ACT
SQUAD LEADER: JAV	SHEET: 12 OF 51

DATUM  
VERTICAL N/A  
HORIZONTAL N/A