

TEMPORARY AND DURABLE 100mm YELLOW LINE

FLASHING BEACON -- GROUND MOUNTED (MOD.)


REMOVING SIGNS

2+354  
 STA. 2+040.0 TO STA. 2+740.0 SOLID LT. AND RT.  
 STA. 2+354.0 TO STA. 2+557.0 SOLID LT AND DASHED RT  
 STA. 2+354.0 TO STA. 2+740.0 SOLID LT. AND RT.  
 TEMPORARY AND DURABLE 100mm WHITE LINE

STA. 2+159 LT.

15 -- AS SHOWN

STA. 2+040.0 TO STA. 2+740.0 SOLID LT. AND RT. (EDGE LINE)

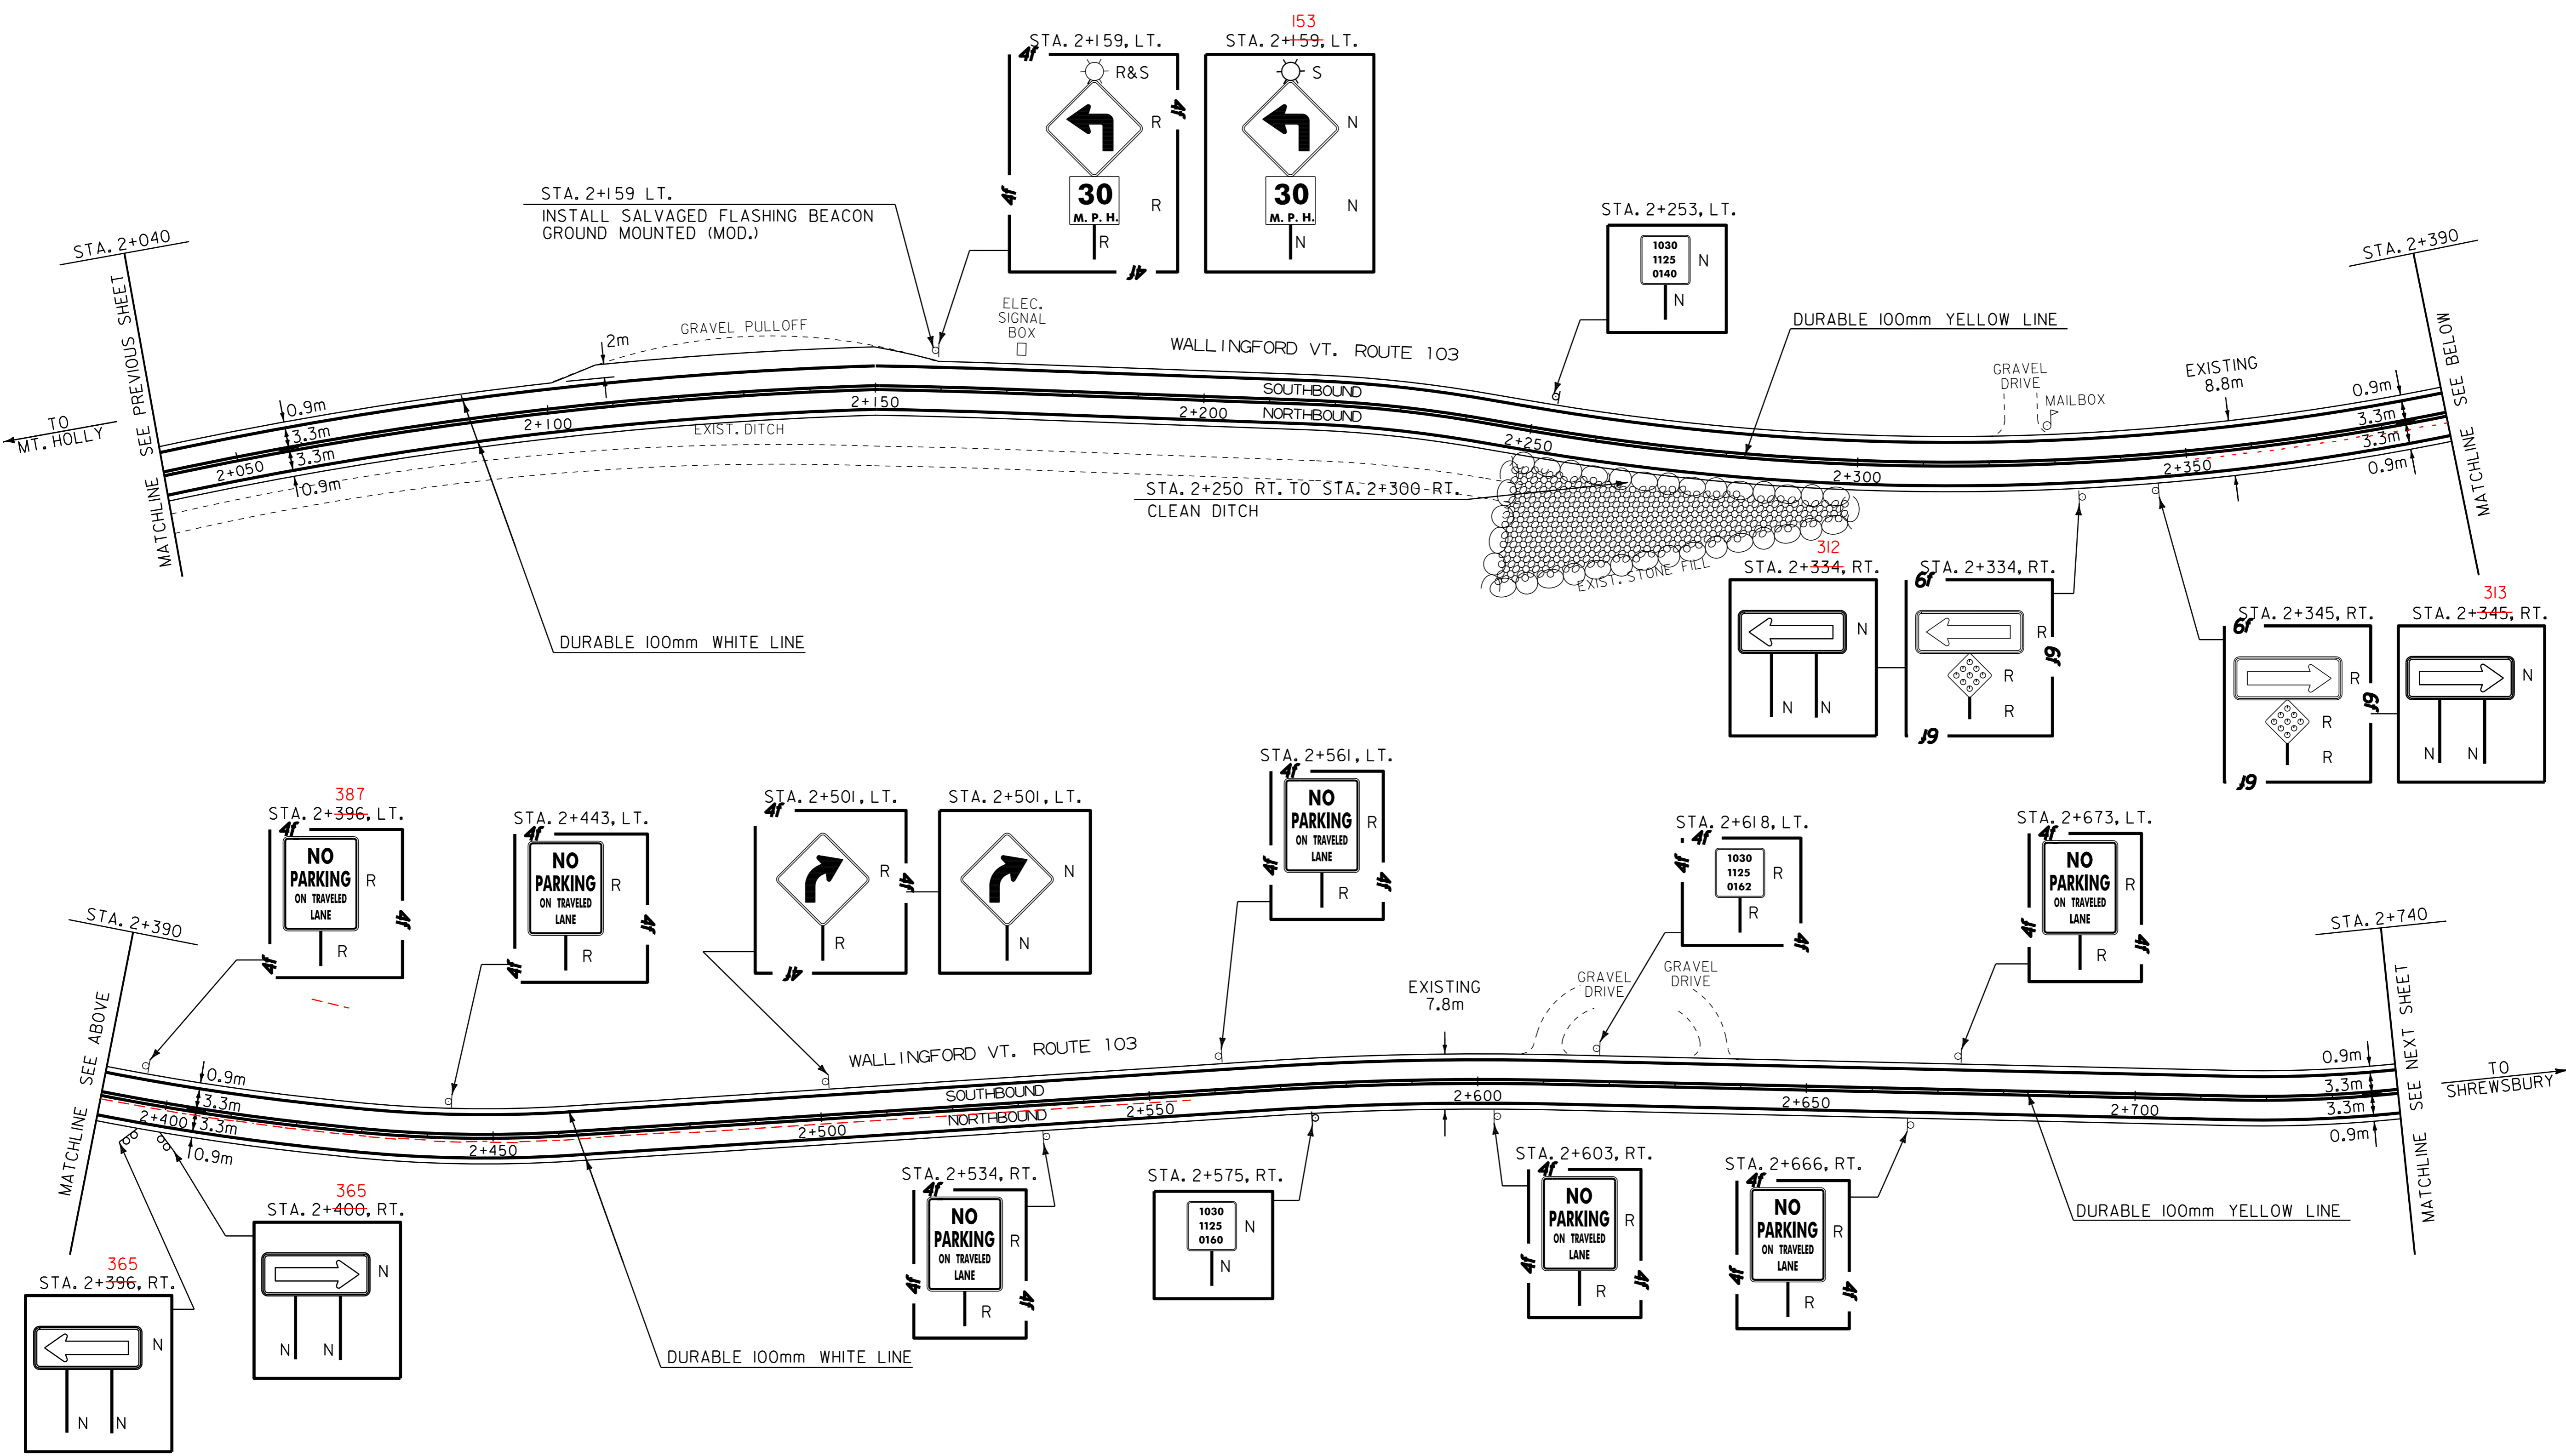

LEGEND  
 N = NEW  
 R = REMOVE  
 R & S = REMOVE AND SALVAGE  
 S = SALVAGE SIGN  
 RET = RETAIN  
 B - B = BACK TO BACK

<b>PAVING PROJECT LAYOUT #4</b>	PROJECT: <b>WALLINGFORD-CLARENDON</b>	PROJECT NO.: <b>NH 2216(1)S</b>
	DESIGN FILE NAME: /pave/99b184/pb184.dgn	PLOT DATE: 13-NOV-2013 13:
	IPARM FILE NAME: pb184104.i	SURVEY DATE:
	SURVEYED BY: SJL, ACT	DRAWN BY: ACT
	SQUAD LEADER: JAV	SHEET: 13 OF 51

DATUM  
 VERTICAL N/A  
 HORIZONTAL N/A