

TEMPORARY AND DURABLE 100mm WHITE LINE


STA. 3+090.0 TO STA. 3+427.93 SOLID LT. AND RT. (EDGE LINE)
 STA. 0+000.00 TO STA. 0+270.0 SOLID LT. AND RT. (EDGE LINE)

TEMPORARY AND DURABLE 100mm YELLOW LINE


STA. 3+090.0 TO STA. 3+427.93 SOLID LT. AND RT.
 STA. 0+000.00 TO STA. 0+270.0 SOLID LT. AND RT.

REMOVING SIGNS

9 -- AS SHOWN

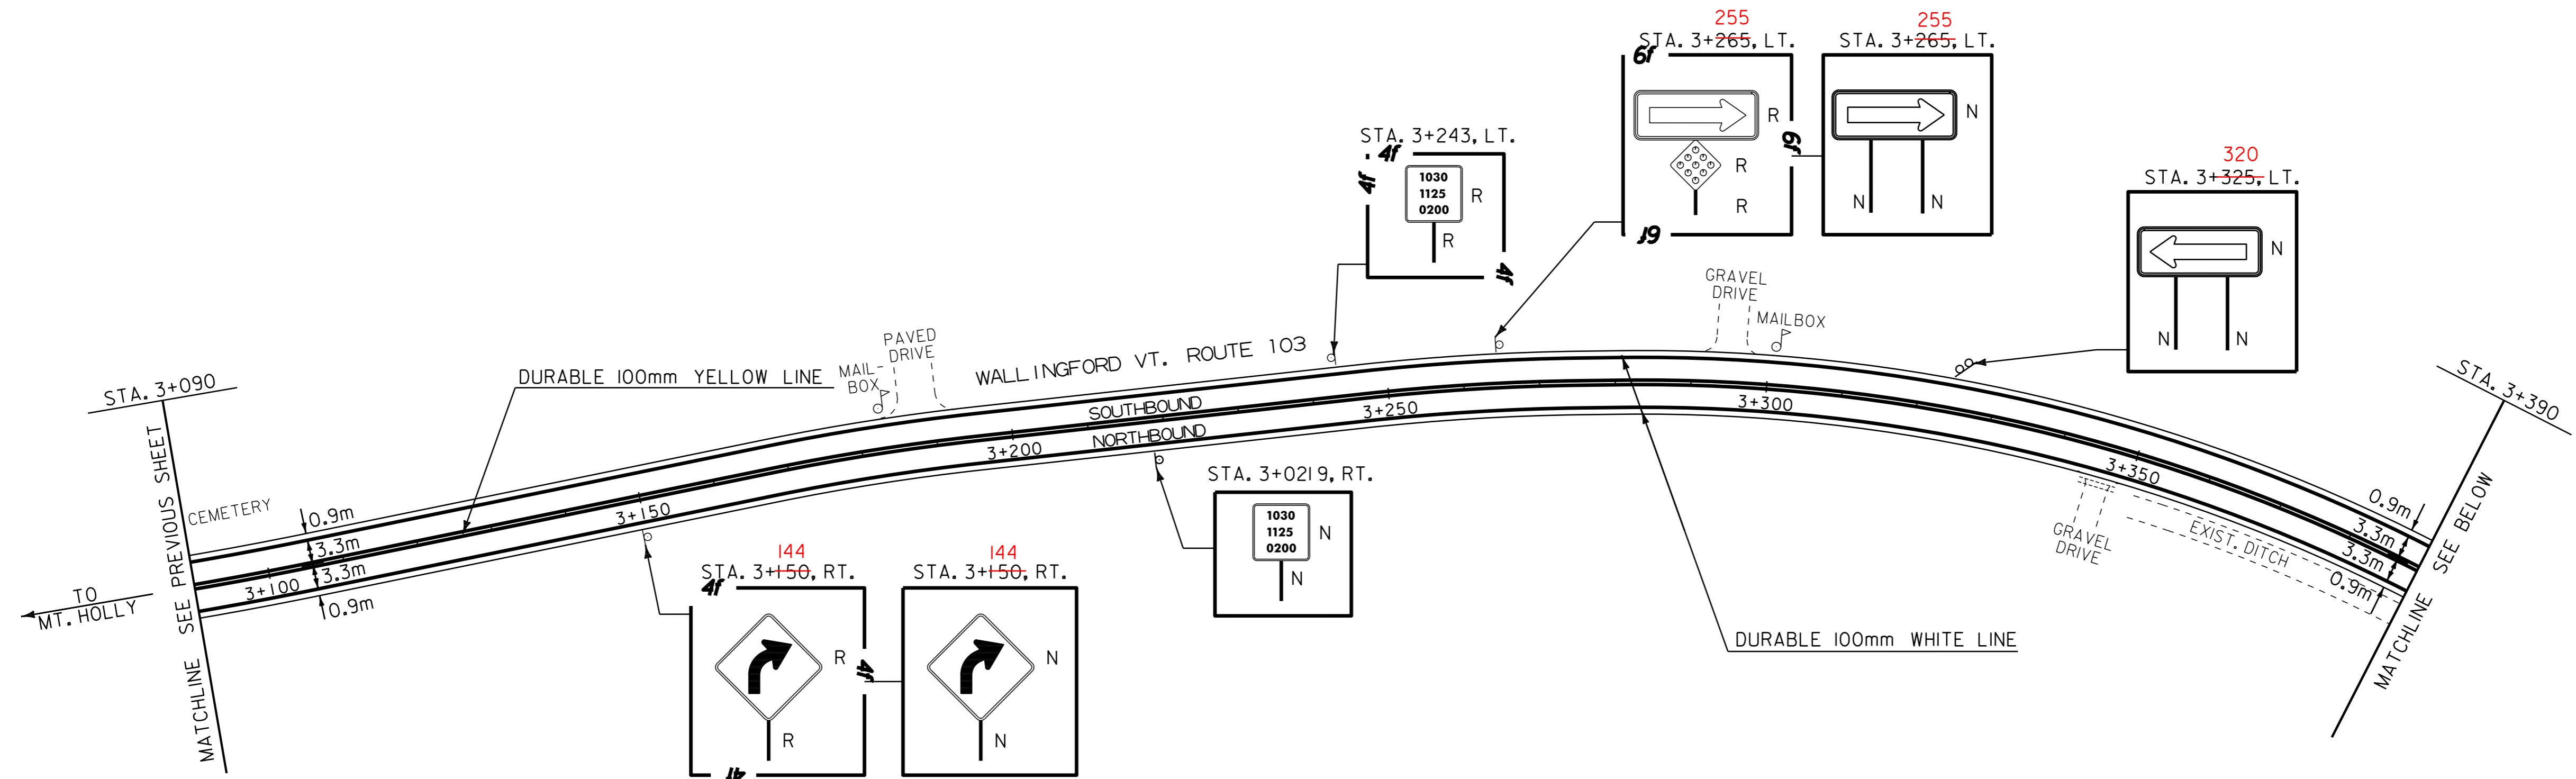

T/L
 WALLINGFORD SHREWSBURY
 416
 STA. 3+427.93 = STA. 0+000.00
 MM 2.130-2.123

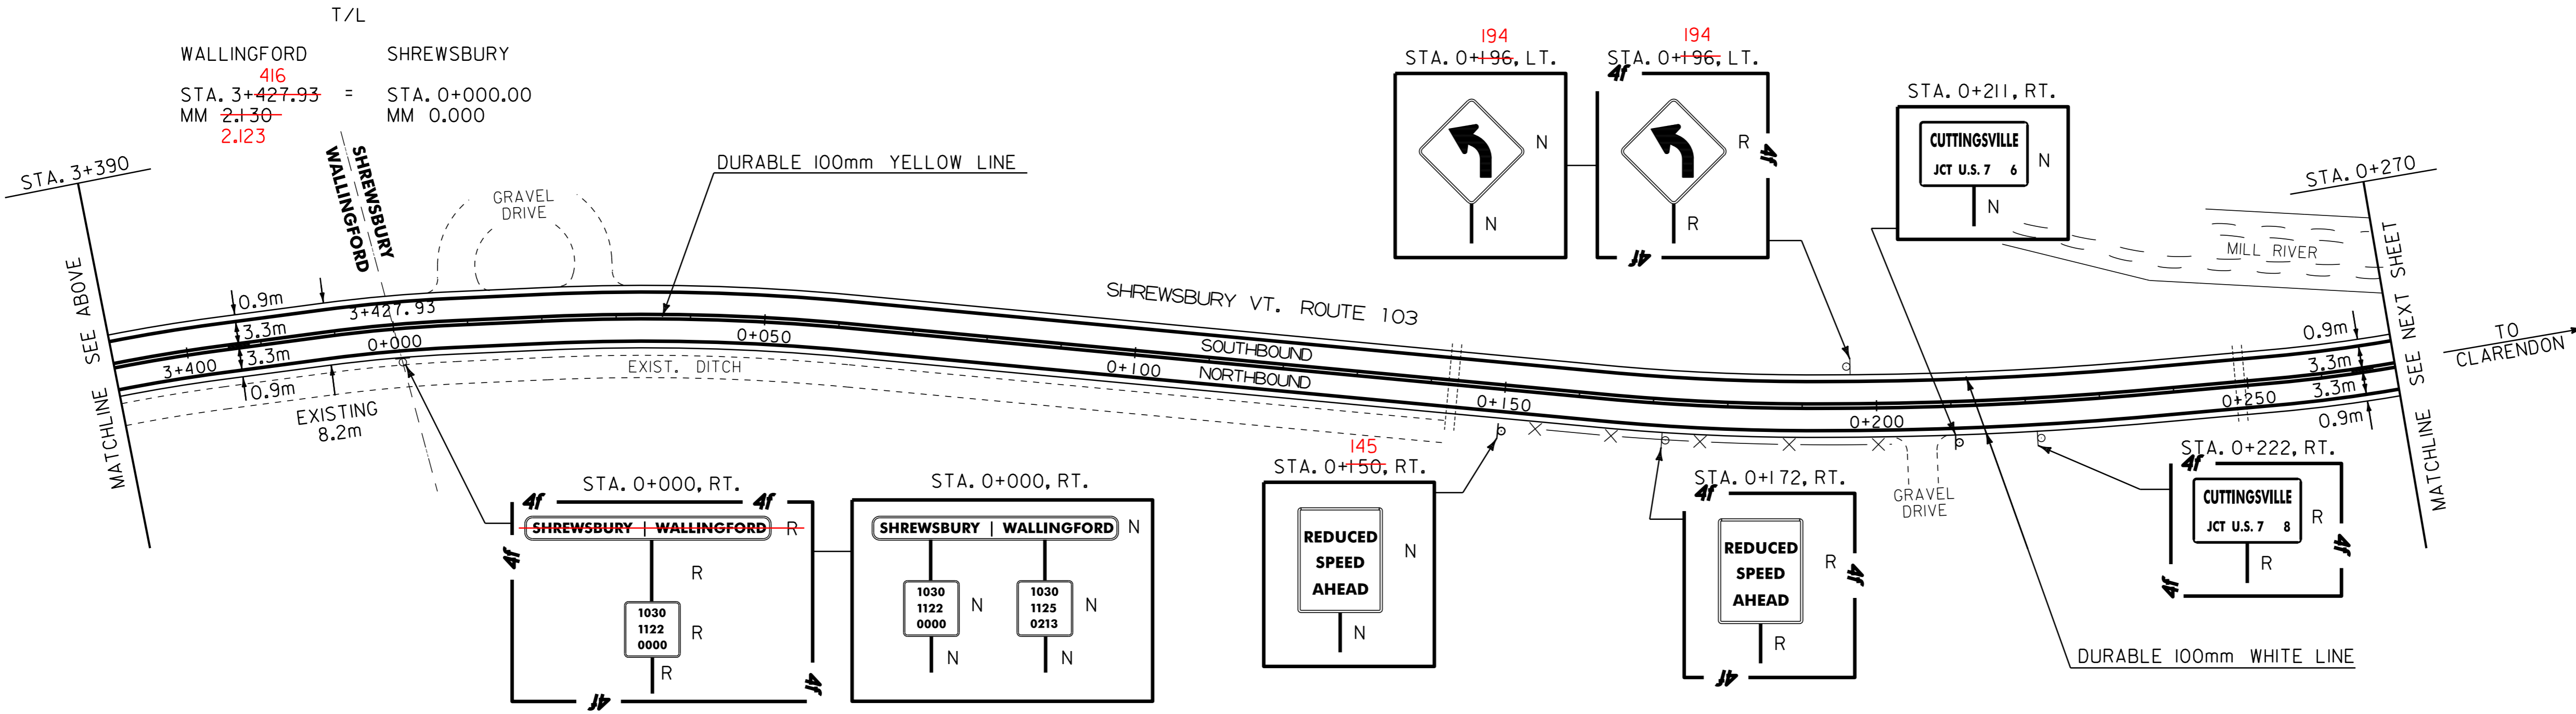

- LEGEND
- N = NEW
 - R = REMOVE
 - R & S = REMOVE AND SALVAGE
 - S = SALVAGE SIGN
 - RET = RETAIN
 - B - B = BACK TO BACK

PAVING PROJECT LAYOUT #6	PROJECT: WALLINGFORD-CLARENDON	PROJECT NO.: NH 2216(1)S
	DESIGN FILE NAME: /pave/99b184/pb184.dgn	PLOT DATE: 13-NOV-2013 13:
	IPARM FILE NAME: pb184106.i	SURVEY DATE:
	SURVEYED BY: SJL, ACT	DRAWN BY: ACT
	SQUAD LEADER: JAV	SHEET: 15 OF 51

DATUM	
VERTICAL	N/A
HORIZONTAL	N/A