


TEMPORARY AND DURABLE 100mm YELLOW LINE

STA. 2+670.0 TO STA. 2+921.0 SOLID LT. AND RT.
STA. 2+921.0 TO STA. 3+154.3 SOLID LT. AND DASHED RT.
STA. 3+154.3 TO STA. 3+310.0 DASHED

TEMPORARY AND DURABLE 100mm WHITE LINE

STA. 2+670.0 TO STA. 3+310.0 SOLID LT. AND RT. (EDGE LINE)

REMOVING SIGNS
I -- AS SHOWN

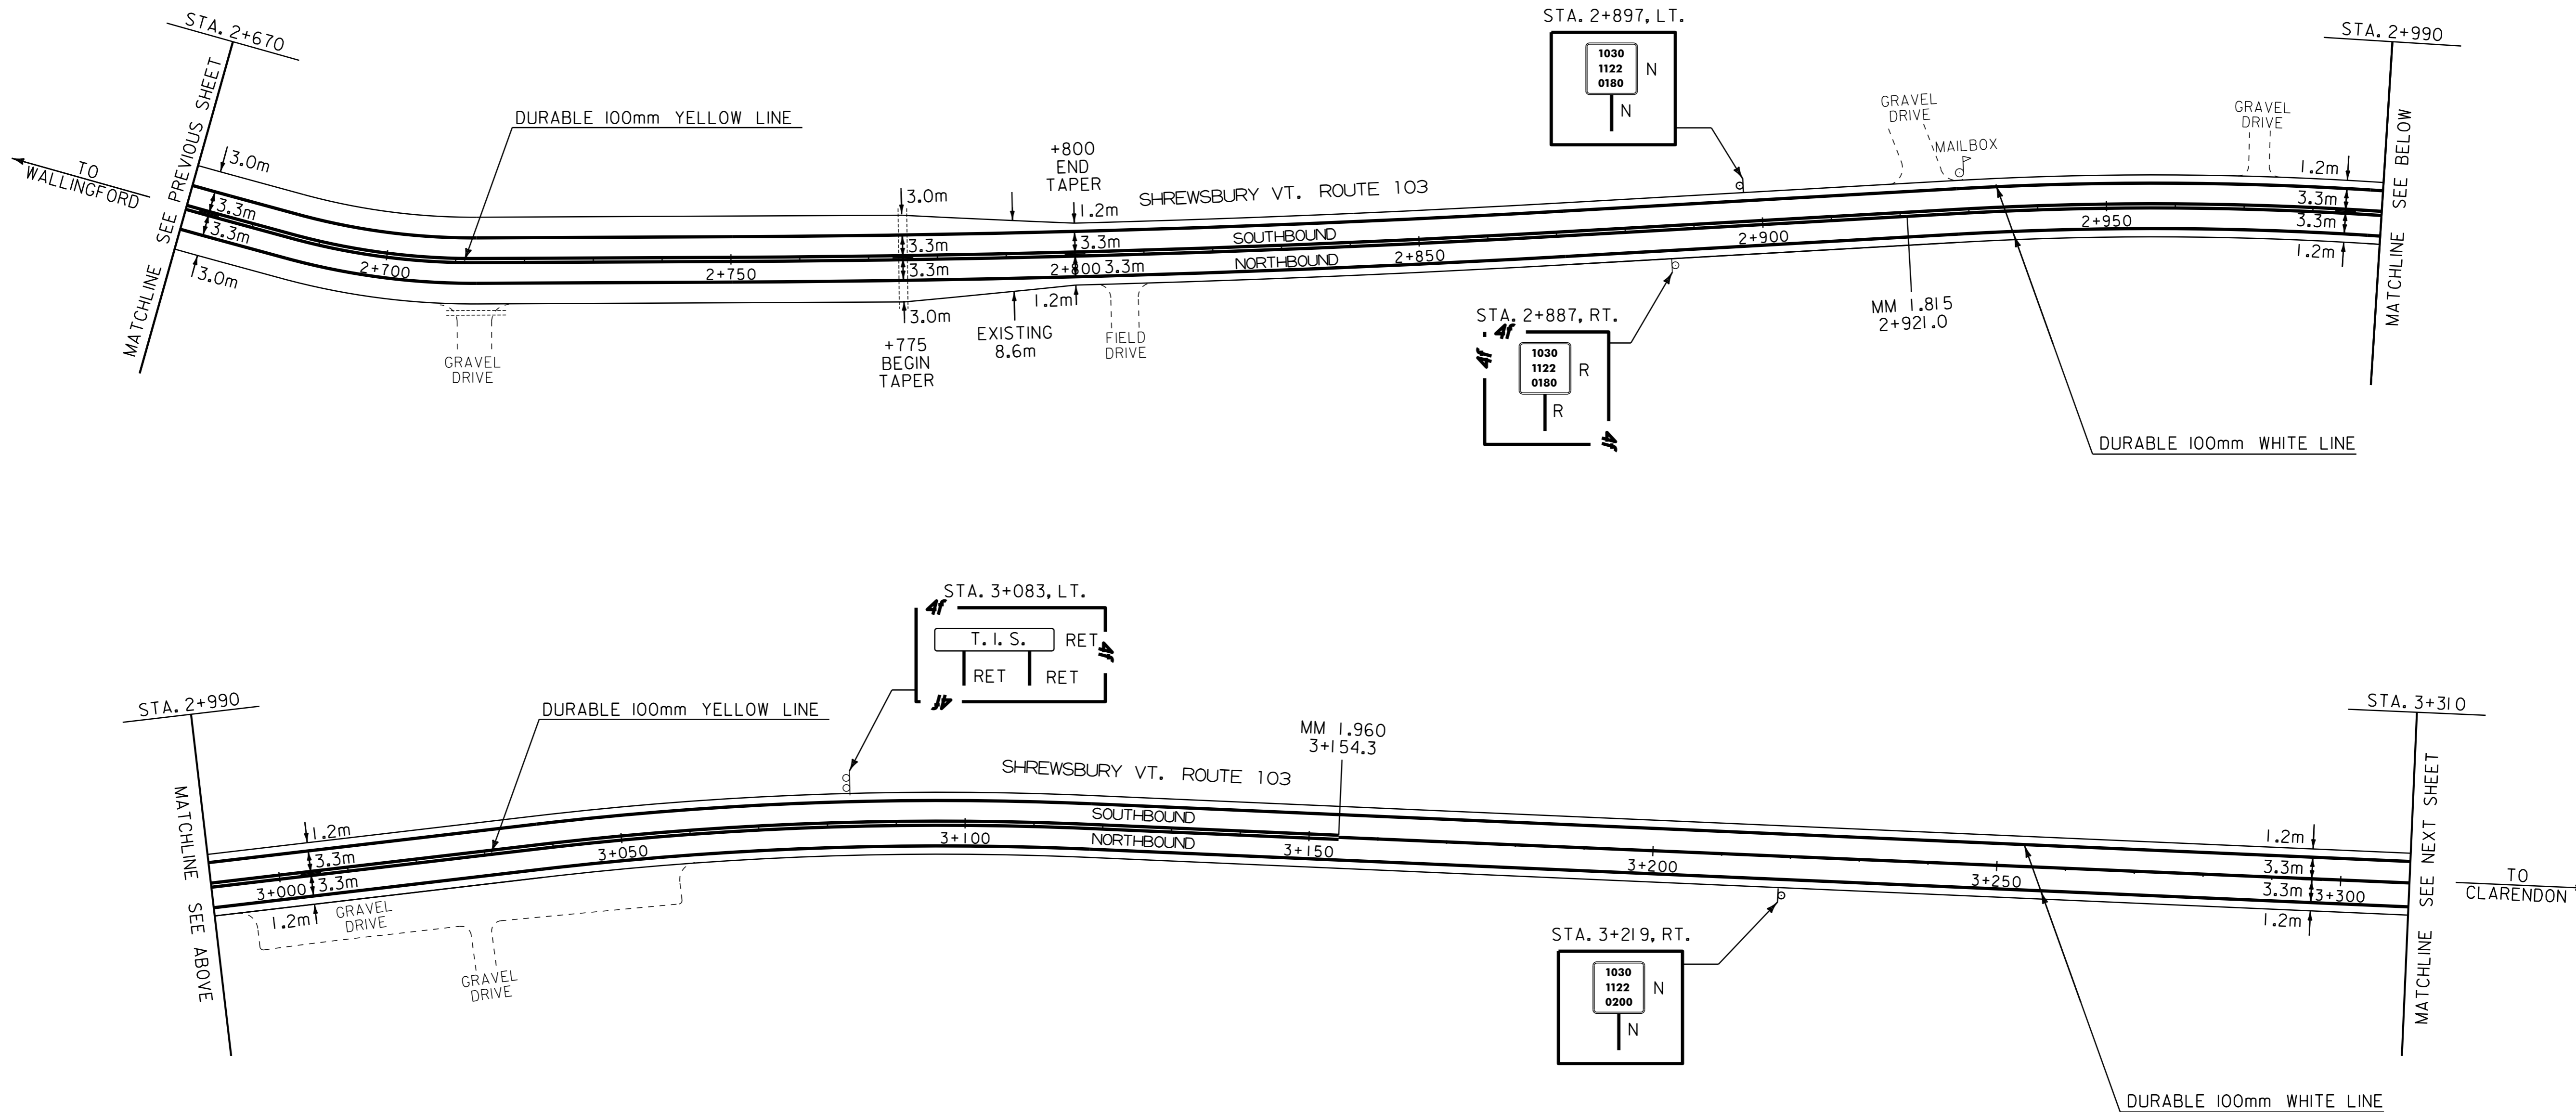

LEGEND

- N = NEW
- R = REMOVE
- R & S = REMOVE AND SALVAGE
- S = SALVAGE SIGN
- RET = RETAIN
- B - B = BACK TO BACK

PAVING PROJECT LAYOUT #11	PROJECT: WALLINGFORD-CLARENDON	PROJECT NO.: NH 2216(1)S
	DESIGN FILE NAME: /pave/99bl84/pbl84.dgn	PLOT DATE: 13-NOV-2013 13:
	IPARM FILE NAME: pbl84iii.i	SURVEY DATE:
	SURVEYED BY: SJL, ACT	DRAWN BY: ACT
	SQUAD LEADER: JAV	SHEET: 20 OF 51

DATUM	
VERTICAL	N/A
HORIZONTAL	N/A