

TEMPORARY AND DURABLE 100mm YELLOW LINE

STA. 1+640.0 TO STA. 1+673.7 DASHED
STA. 1+673.7 TO STA. 1+915.1 DASHED LT. AND SOLID RT.
STA. 1+915.1 TO STA. 2+290.0 SOLID LT. AND RT.


TEMPORARY AND DURABLE 100mm WHITE LINE

STA. 1+640.0 TO STA. 2+290.0 SOLID LT. AND RT. (EDGE LINE)

REMOVING SIGNS
4 -- AS SHOWN



SHOULDER BERM REMOVAL
STA. 2+173 RT. TO STA. 2+290 RT.

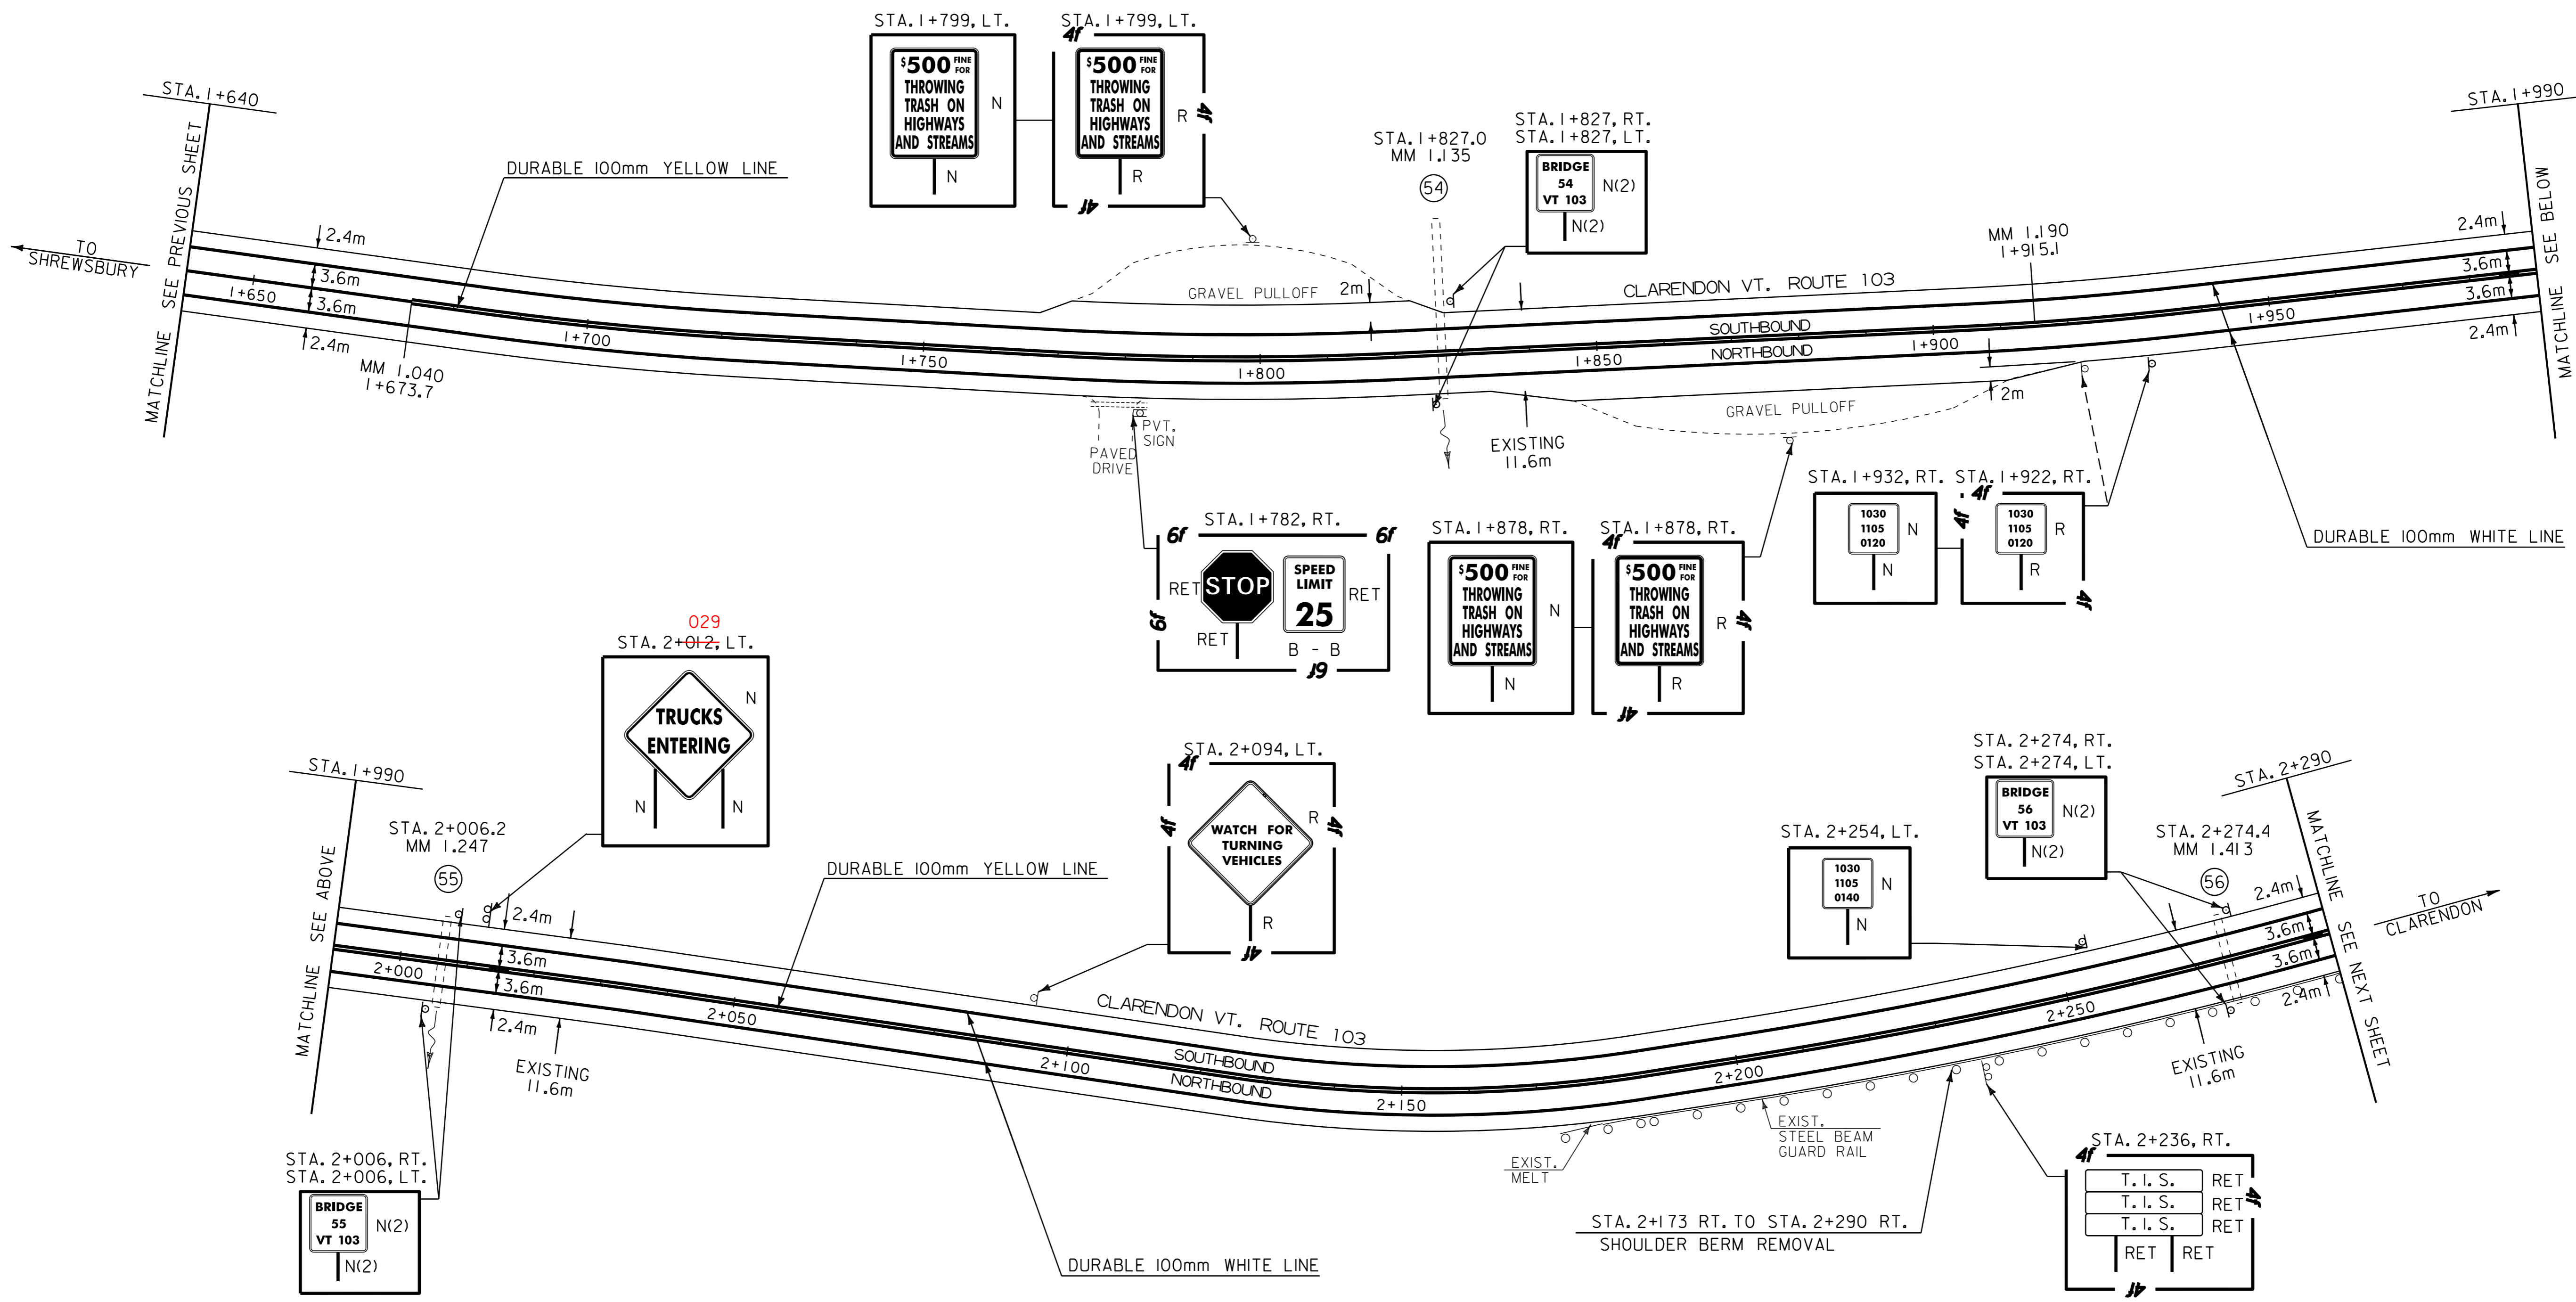

LEGEND

- N = NEW
- R = REMOVE
- R & S = REMOVE AND SALVAGE
- S = SALVAGE SIGN
- RET = RETAIN
- B - B = BACK TO BACK

PAVING PROJECT LAYOUT #20	PROJECT: WALLINGFORD-CLARENDON	PROJECT NO.: NH 2216(1)S
	DESIGN FILE NAME: /pave/99bl84/pbl84.dgn	PLOT DATE: 13-NOV-2013 13:
	IPARM FILE NAME: pbl84i20.i	SURVEY DATE:
	SURVEYED BY: SJL, ACT	DRAWN BY: ACT
	SQUAD LEADER: JAV	SHEET: 29 OF 51

DATUM	
VERTICAL	N/A
HORIZONTAL	N/A